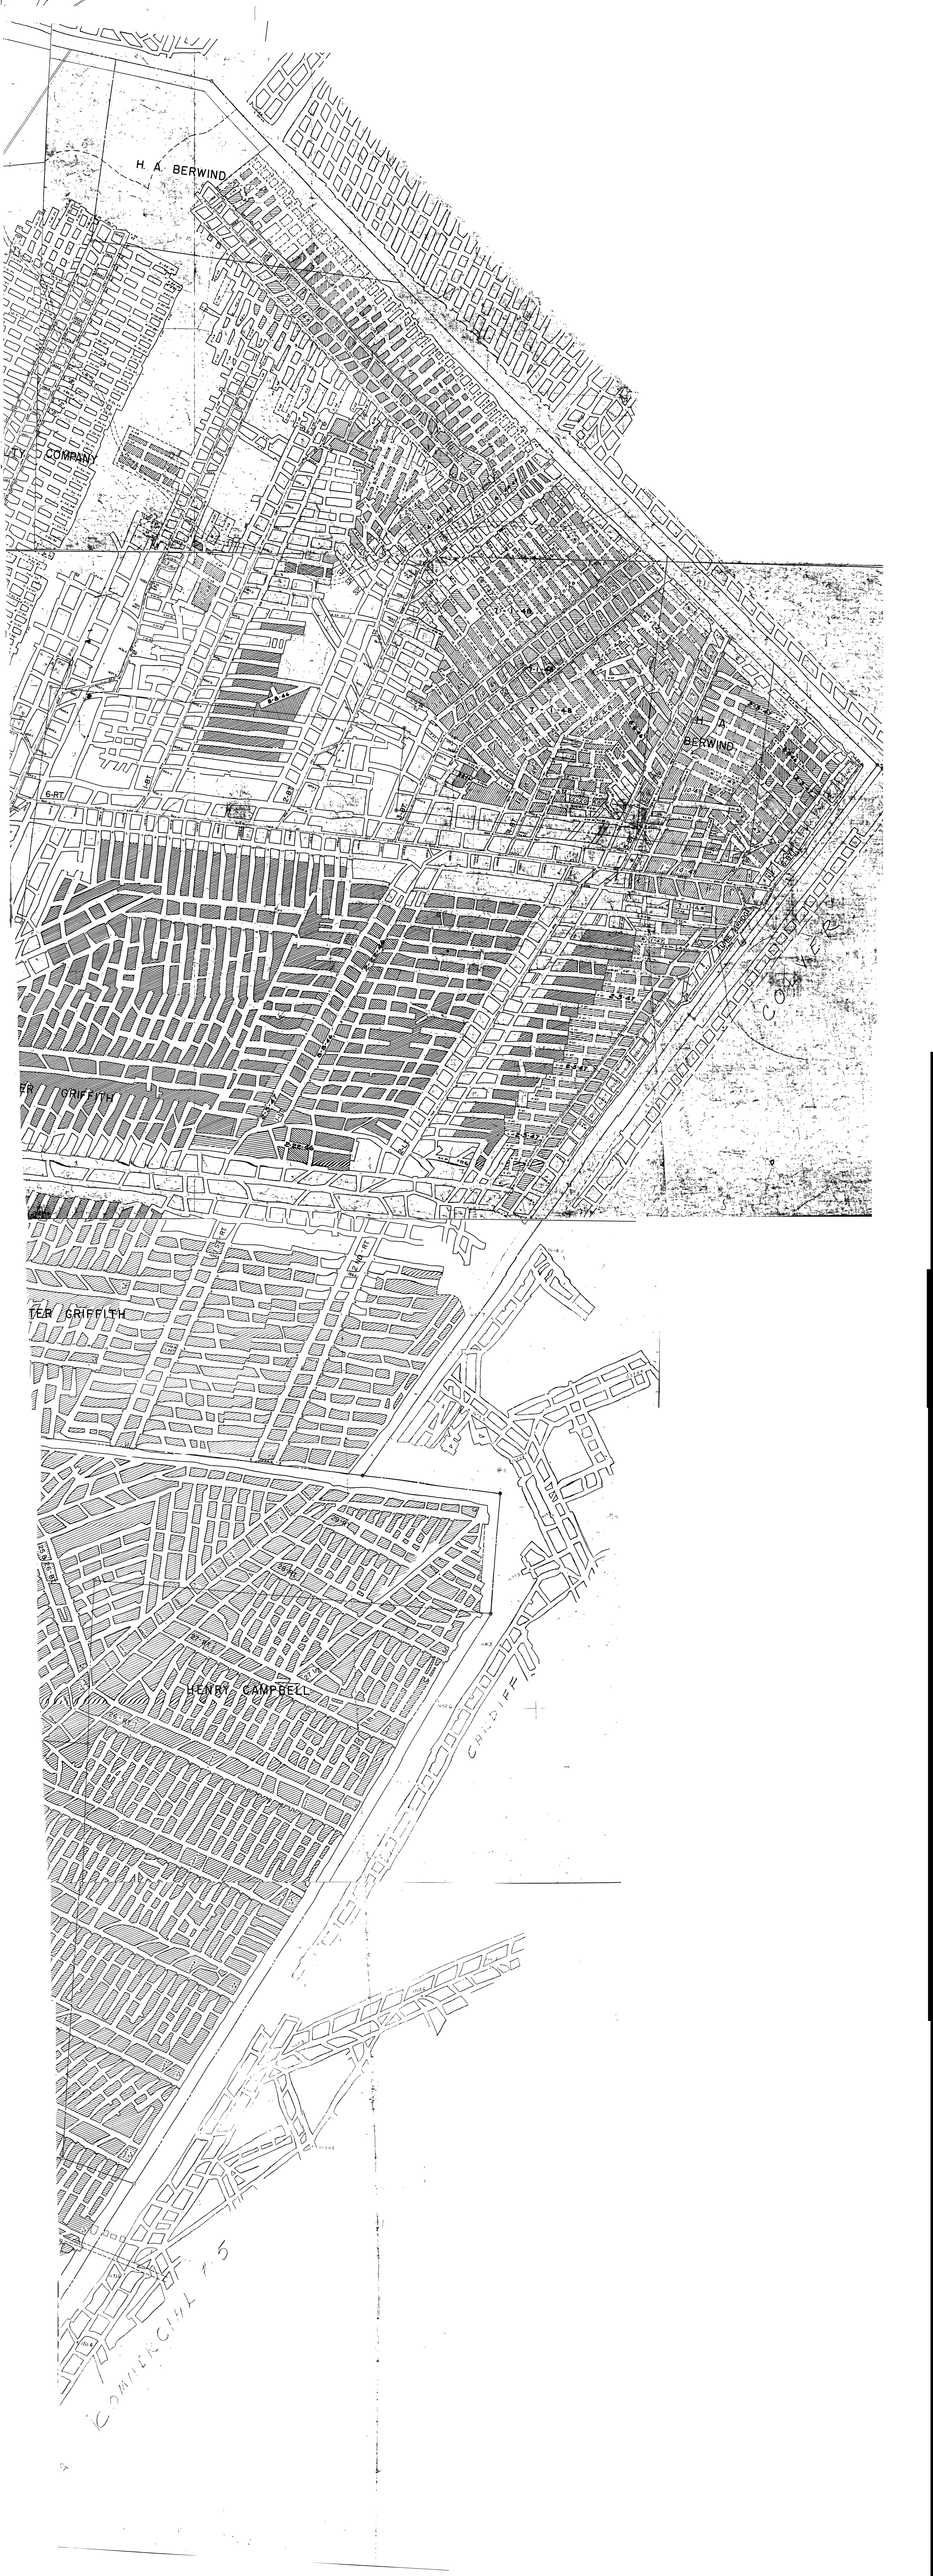
H. A. BERWIND
H. A. BERWIND
HENRY CAMPBELL
