


FIT TO SHEET No 2

13-D2221

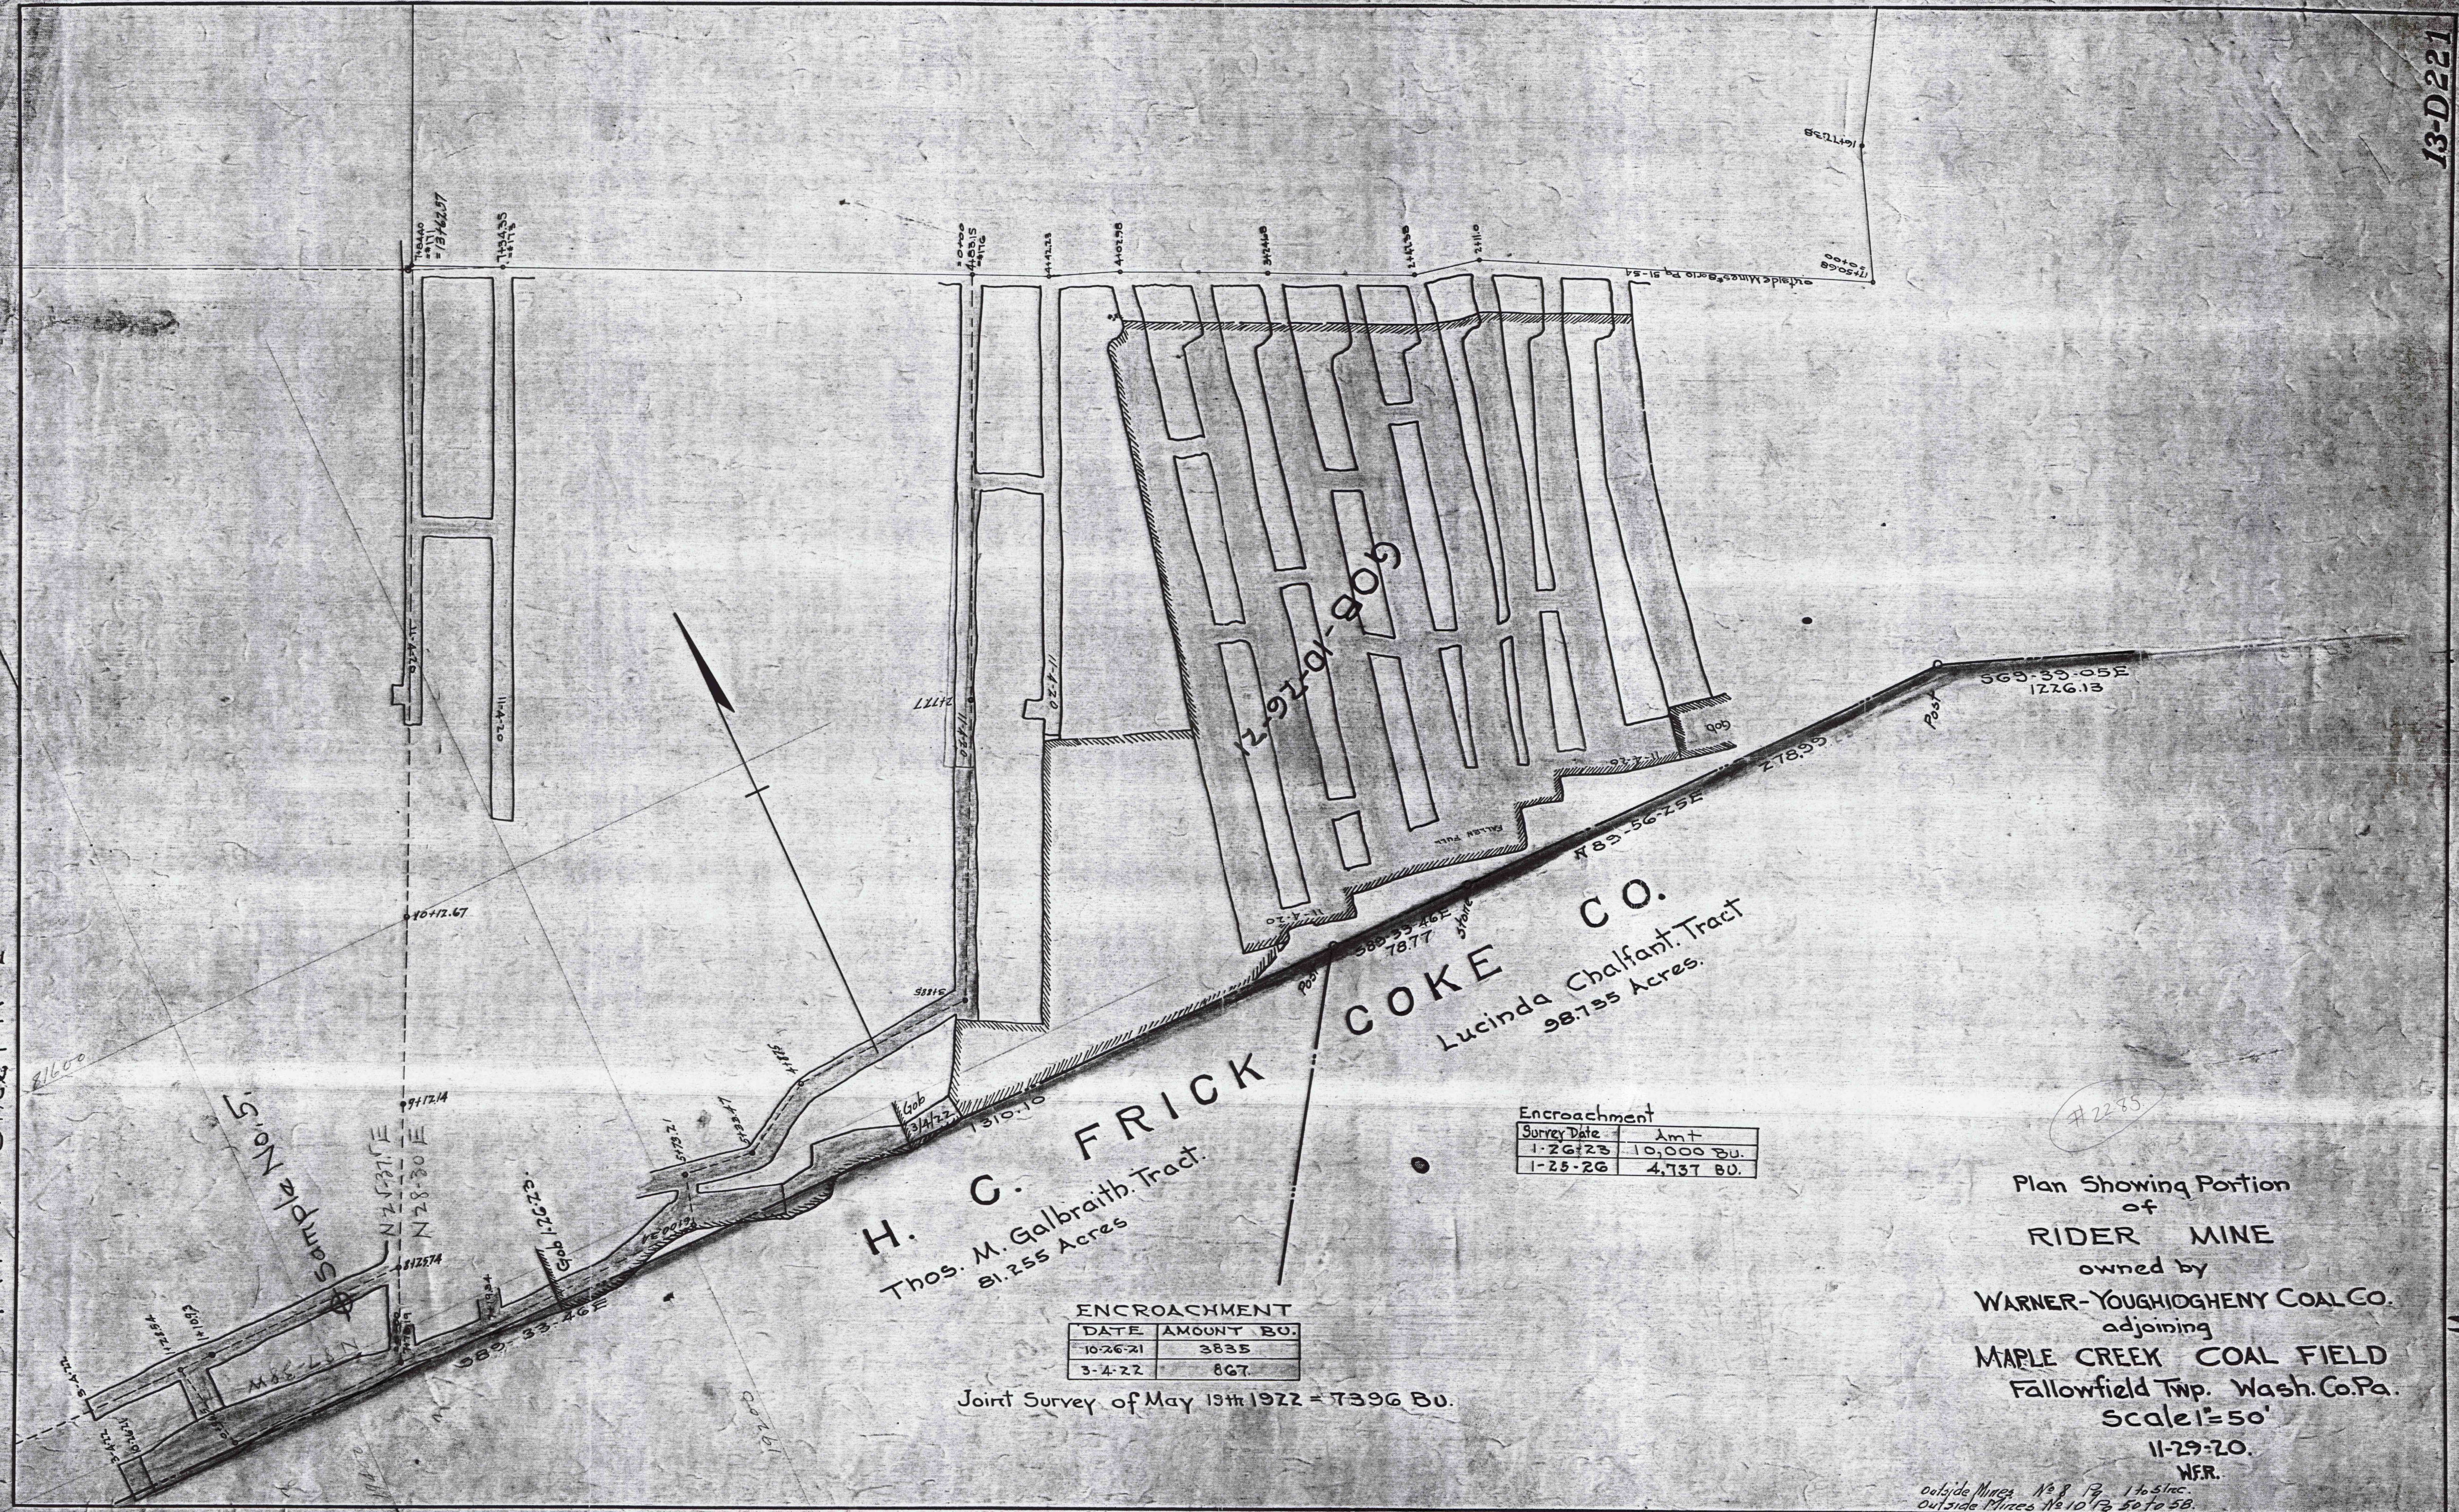

H. C. FRICK
Thos. M. Galbraith Tract
81.255 Acres

COKE C.O.
Lucinda Chalfant Tract
98.795 Acres

Encroachment	
Survey Date	Am't
1-26-23	10,000 BU.
1-25-26	4,737 BU.

ENCROACHMENT	
DATE	AMOUNT BU.
10-26-21	3835
3-4-22	867

Joint Survey of May 19th 1922 = 7396 BU.

Plan Showing Portion
of
RIDER MINE
owned by
WARNER-YOUGHIOGHENY COAL CO.
adjoining
MAPLE CREEK COAL FIELD
Fallowfield Twp. Wash. Co. Pa.
Scale 1"=50'

11-29-20.

W.F.R.

Outside Mines No 8 17 to 51 inc.
Outside Mines No 10 13 50 to 58.

Sheet No 1