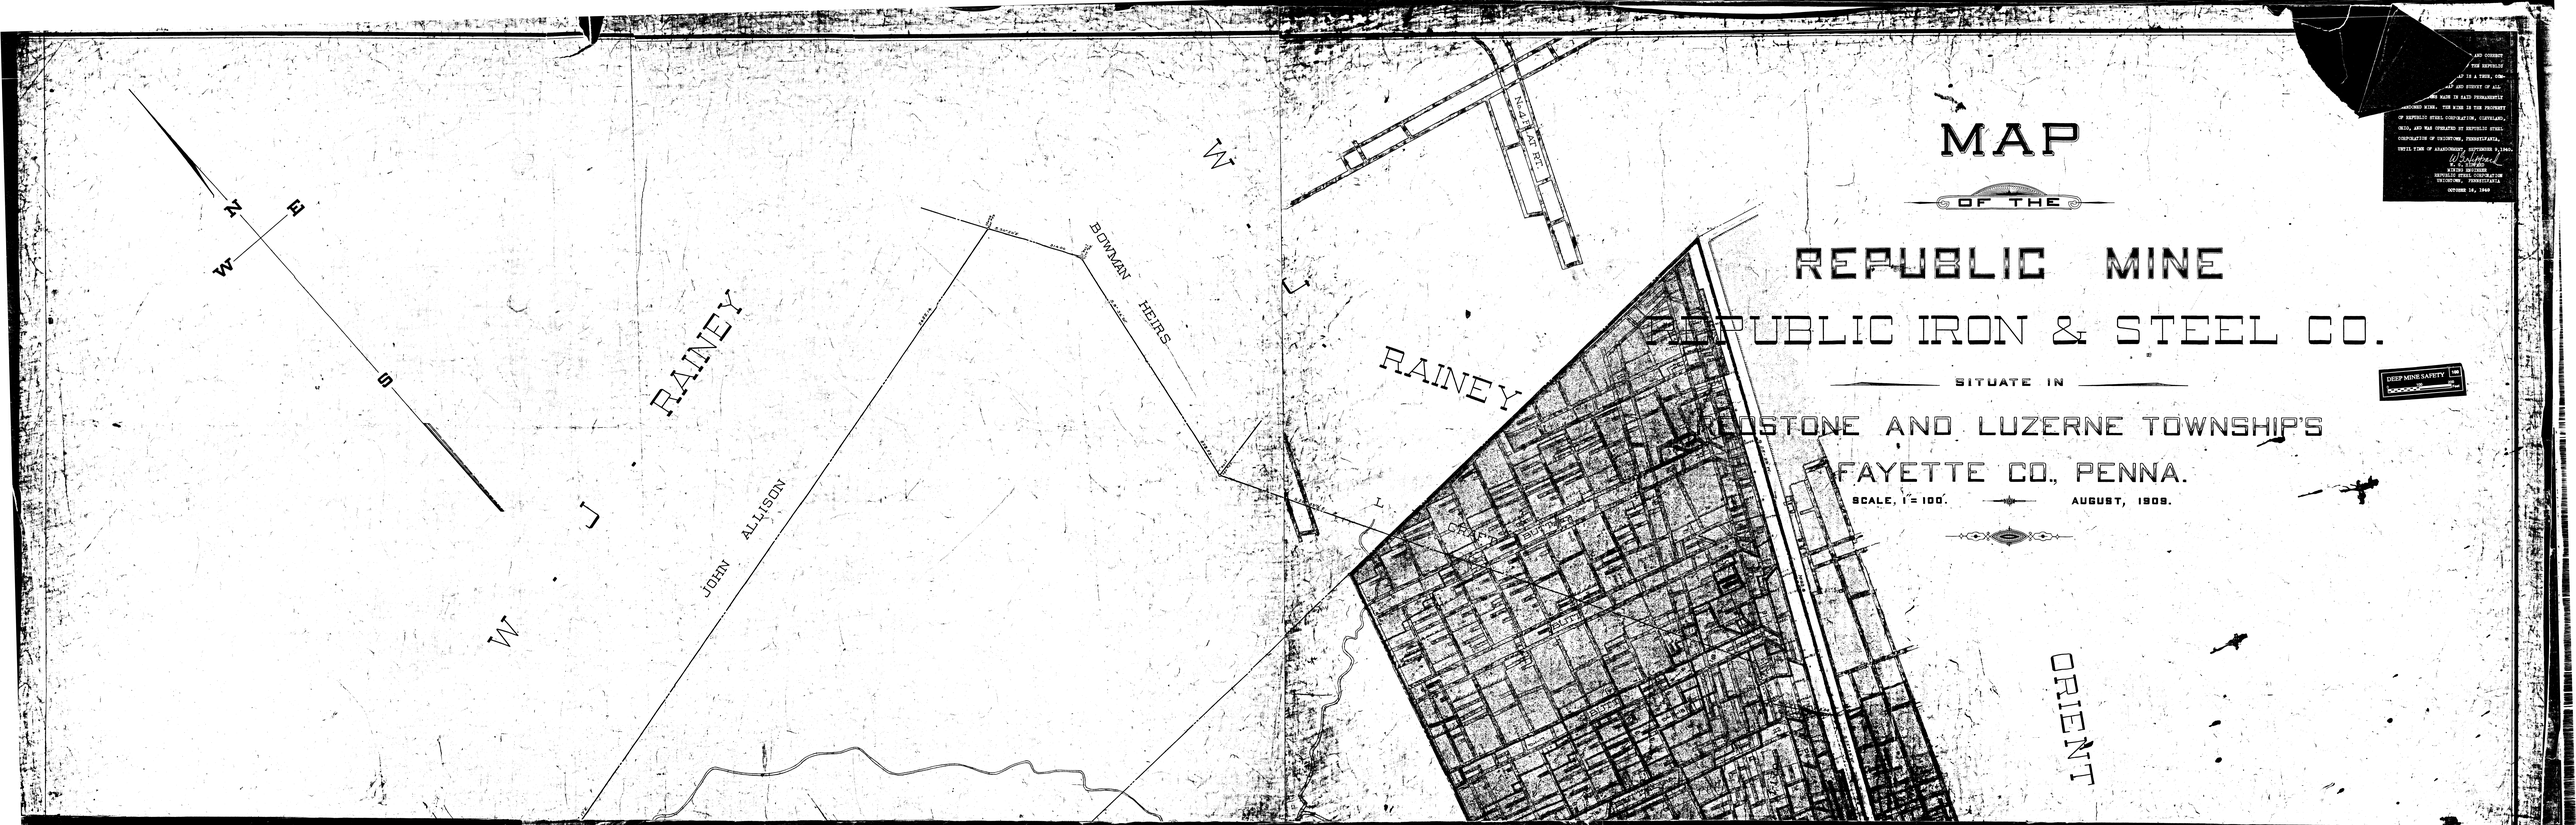
MAP
OF THE
REPUBLIC MINE
REPUBLIC IRON & STEEL CO.
SITUATE IN
REDSTONE AND LUZERNE TOWNSHIP'S
FAYETTE CO., PENNA.
SCALE, 1" = 100'.
AUGUST, 1909.
RAINEY
RAINEY
JOHN ALLISON
BOWMAN HEIRS
ORIENT
No. 1 MAT RR.
N
E
W
S
DEEP MINE SAFETY LAMP