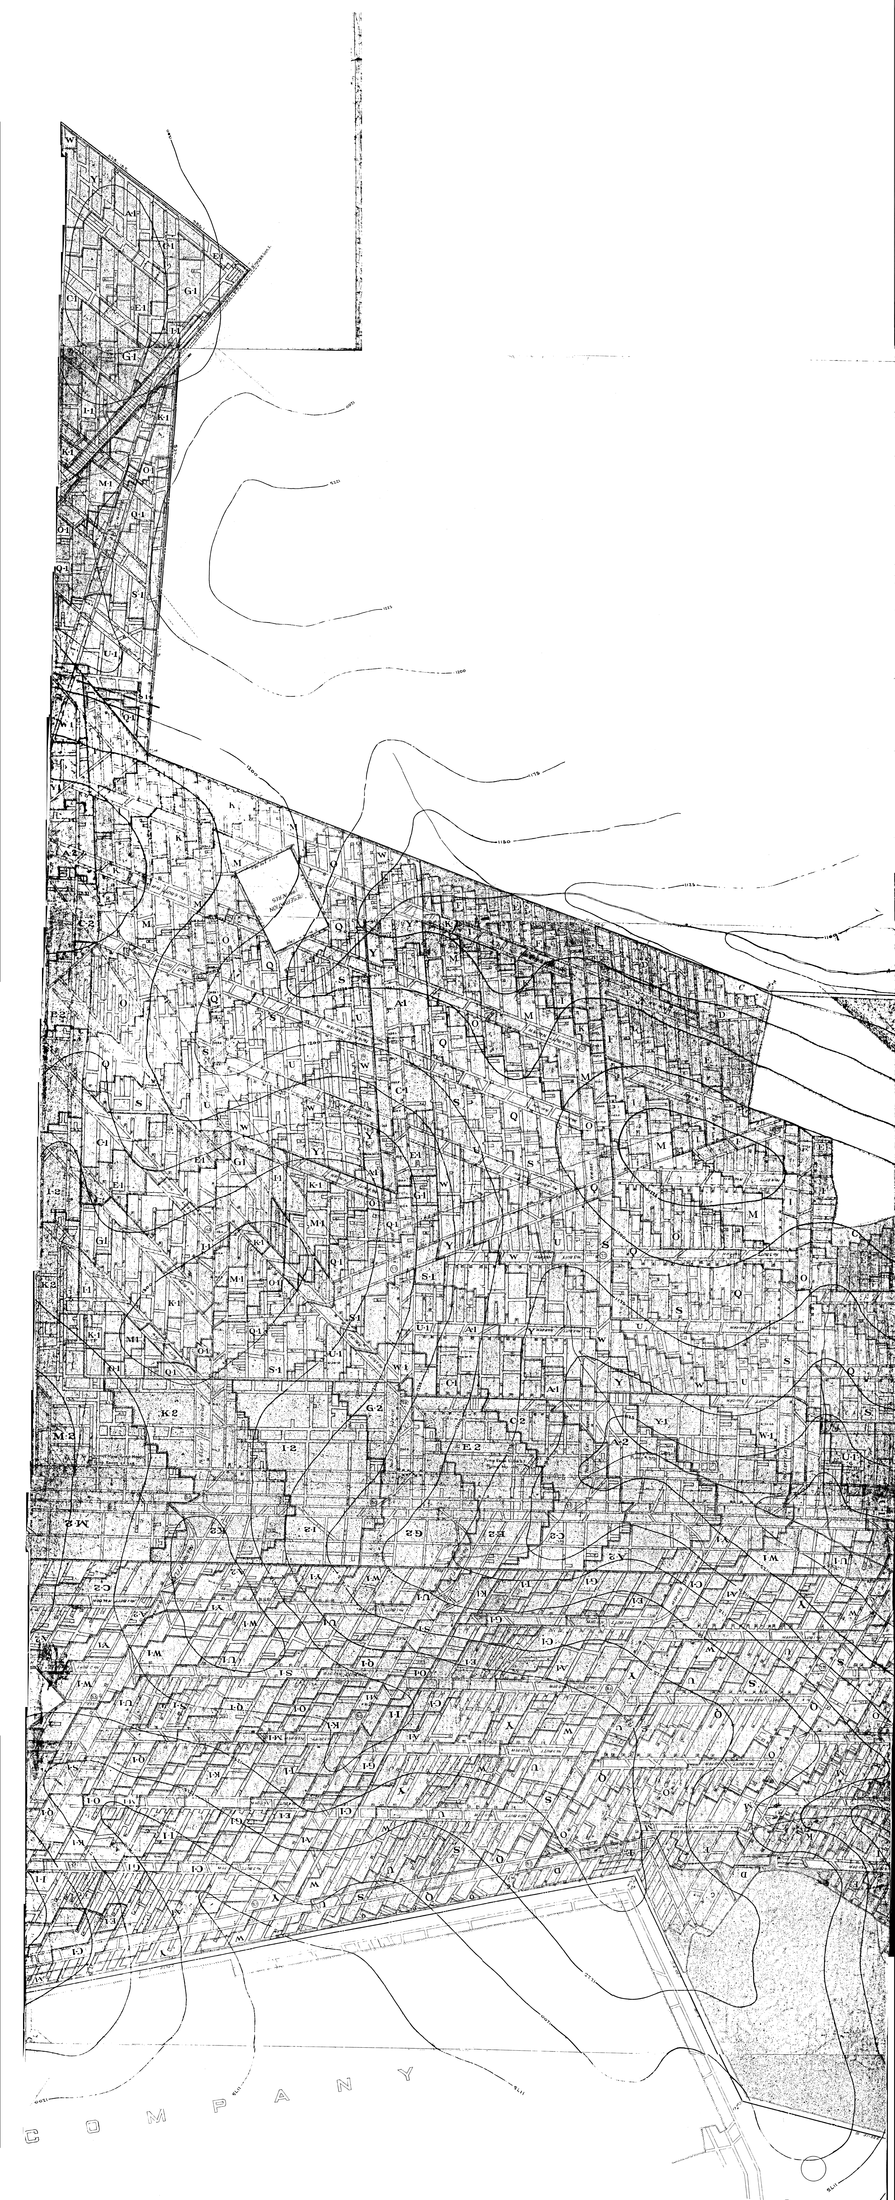


MAP OF
REVERE MINE
BELONGING TO
W. J. RAINEY

SOUTH UNION & GEORGES TWPS.

FAYETTE CO., PA.

Scale — 1 in. = 100 ft.

1913