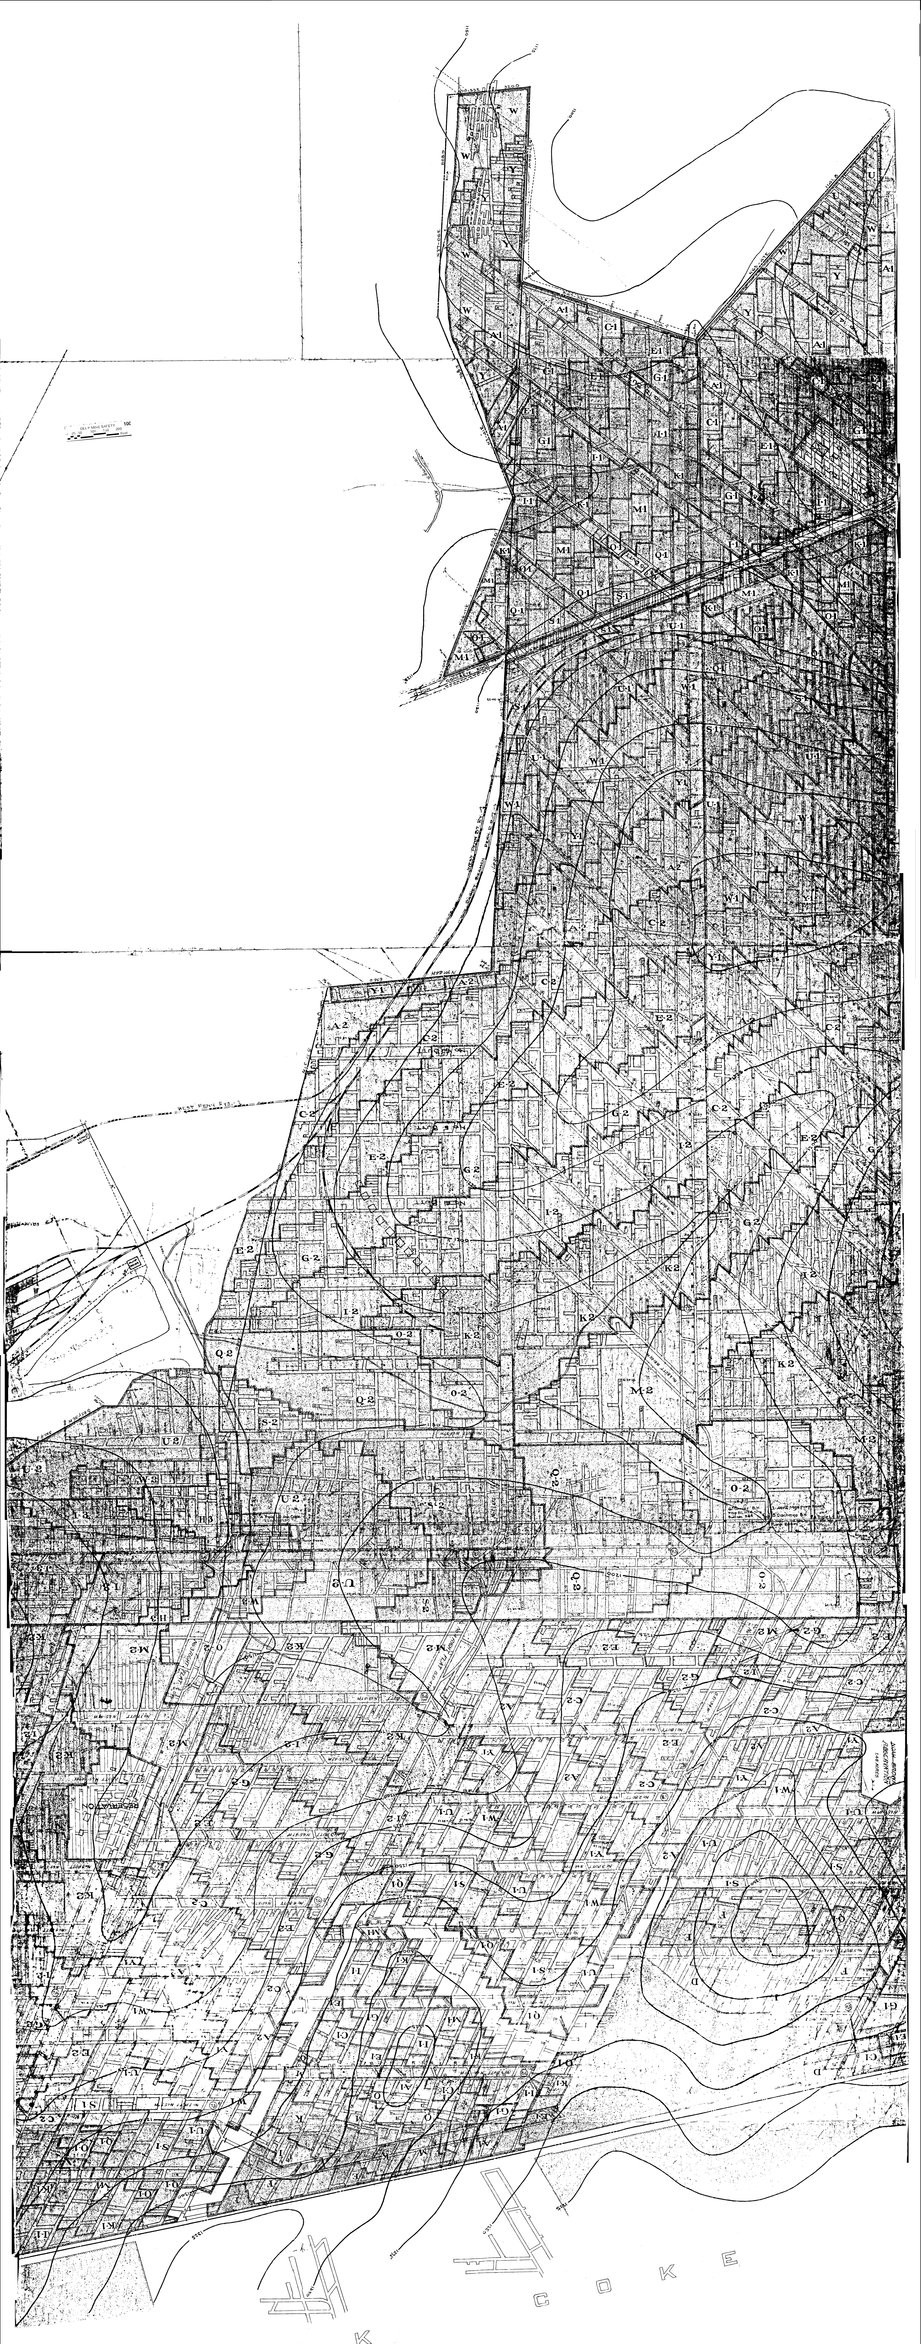


Date of Survey

A -		01 — DEC. — 30 — 1922	
B -		Q-1 — JUNE — 30 — 1923	
C-4 — DEC. — 83 — 1912		S1 — DEC. — 31 — 1923	
D - JUNE — 30 — 1913		U1 — JUNE — 30 — 1924	
E - DEC. — 31 — 1913		W1 — DEC. — 31 — 1924	
F - JUNE — 30 — 1914		Y1 — JUNE — 30 — 1925	
I - DEC. — 30 — 1914		AC — DEC. — 31 — 1925	
K - JUNE — 30 — 1915		C2 — JUNE — 30 — 1926	
M — DEC. — 31 — 1915		E2 - DEC. - 31 - 1926	
O — JUNE — 30 — 1916		G-2 - JUNE - 29 - 1927	
Q — DEC. — 30 — 1916		I-2 - DEC. - 31 - 1927	
S — JUNE — 30 — 1917		K-2 - JUNE - 30 - 1928	
U — DEC. — 30 — 1917		M-2 - JAN. — 1 — 1929	
W — JUNE — 30 — 1918			
Y — DEC. — 31 — 1918			
A1 — JUNE — 30 — 1919			
C1 — DEC. — 31 — 1919			
E1 — JUNE — 30 — 1920			
G1 — DEC. — 31 — 1920			
I1 — JUNE — 30 — 1921			
K1 — DEC. — 31 — 1921			
M1 — JUNE — 30 — 1922			