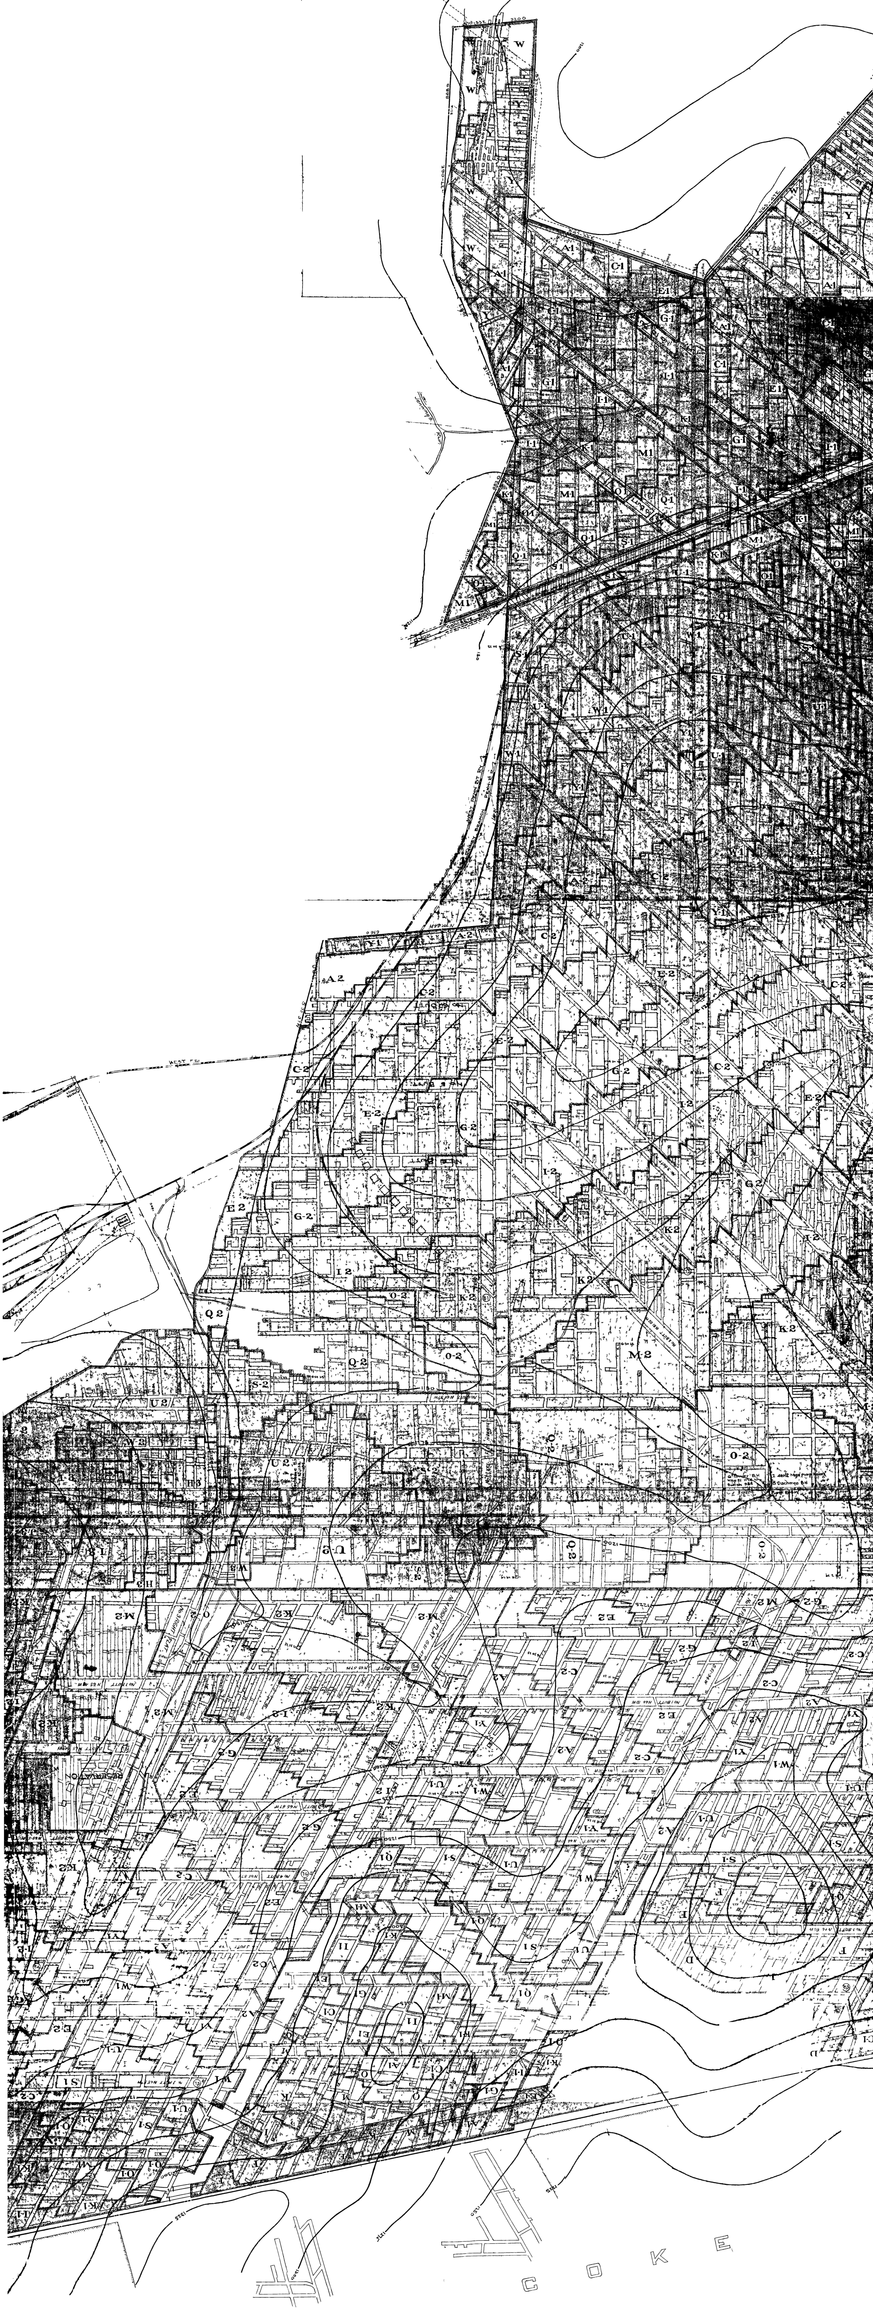


Date of Survey

A –		D-1 – DEC. 30 – 1922	
B –		Q-1 – JUNE 30 – 1923	
C – DEC. 23 – 1912		B1 – DEC. 31 – 1923	
D – JUNE 30 – 1913		U1 – JUNE 30 – 1924	
E – DEC. 31 – 1913		W1 – DEC. 31 – 1924	
F – JUNE 30 – 1914		V1 – JUNE 30 – 1925	
I – DEC. 30 – 1914		A2 – DEC. 31 – 1925	
K – JUNE 30 – 1915		Q2 – JUNE 30 – 1926	
M – DEC. 31 – 1915		E2 – DEC. 31 – 1926	
O – JUNE 30 – 1916		G-2 – JUNE 30 – 1927	
Q – DEC. 30 – 1916		J-2 – DEC. 31 – 1927	
S – JUNE 30 – 1917		K2 – JUNE 30 – 1928	
U – DEC. 30 – 1917		M2 – JAN. 1 – 1929	
W – JUNE 30 – 1918			
Y – DEC. 31 – 1918			
A1 – JUNE 30 – 1919			
C1 – DEC. 31 – 1919			
E1 – JUNE 30 – 1920			
G1 – DEC. 31 – 1920			
I1 – JUNE 30 – 1921			
K1 – DEC. 31 – 1921			
M1 – JUNE 30 – 1922			