


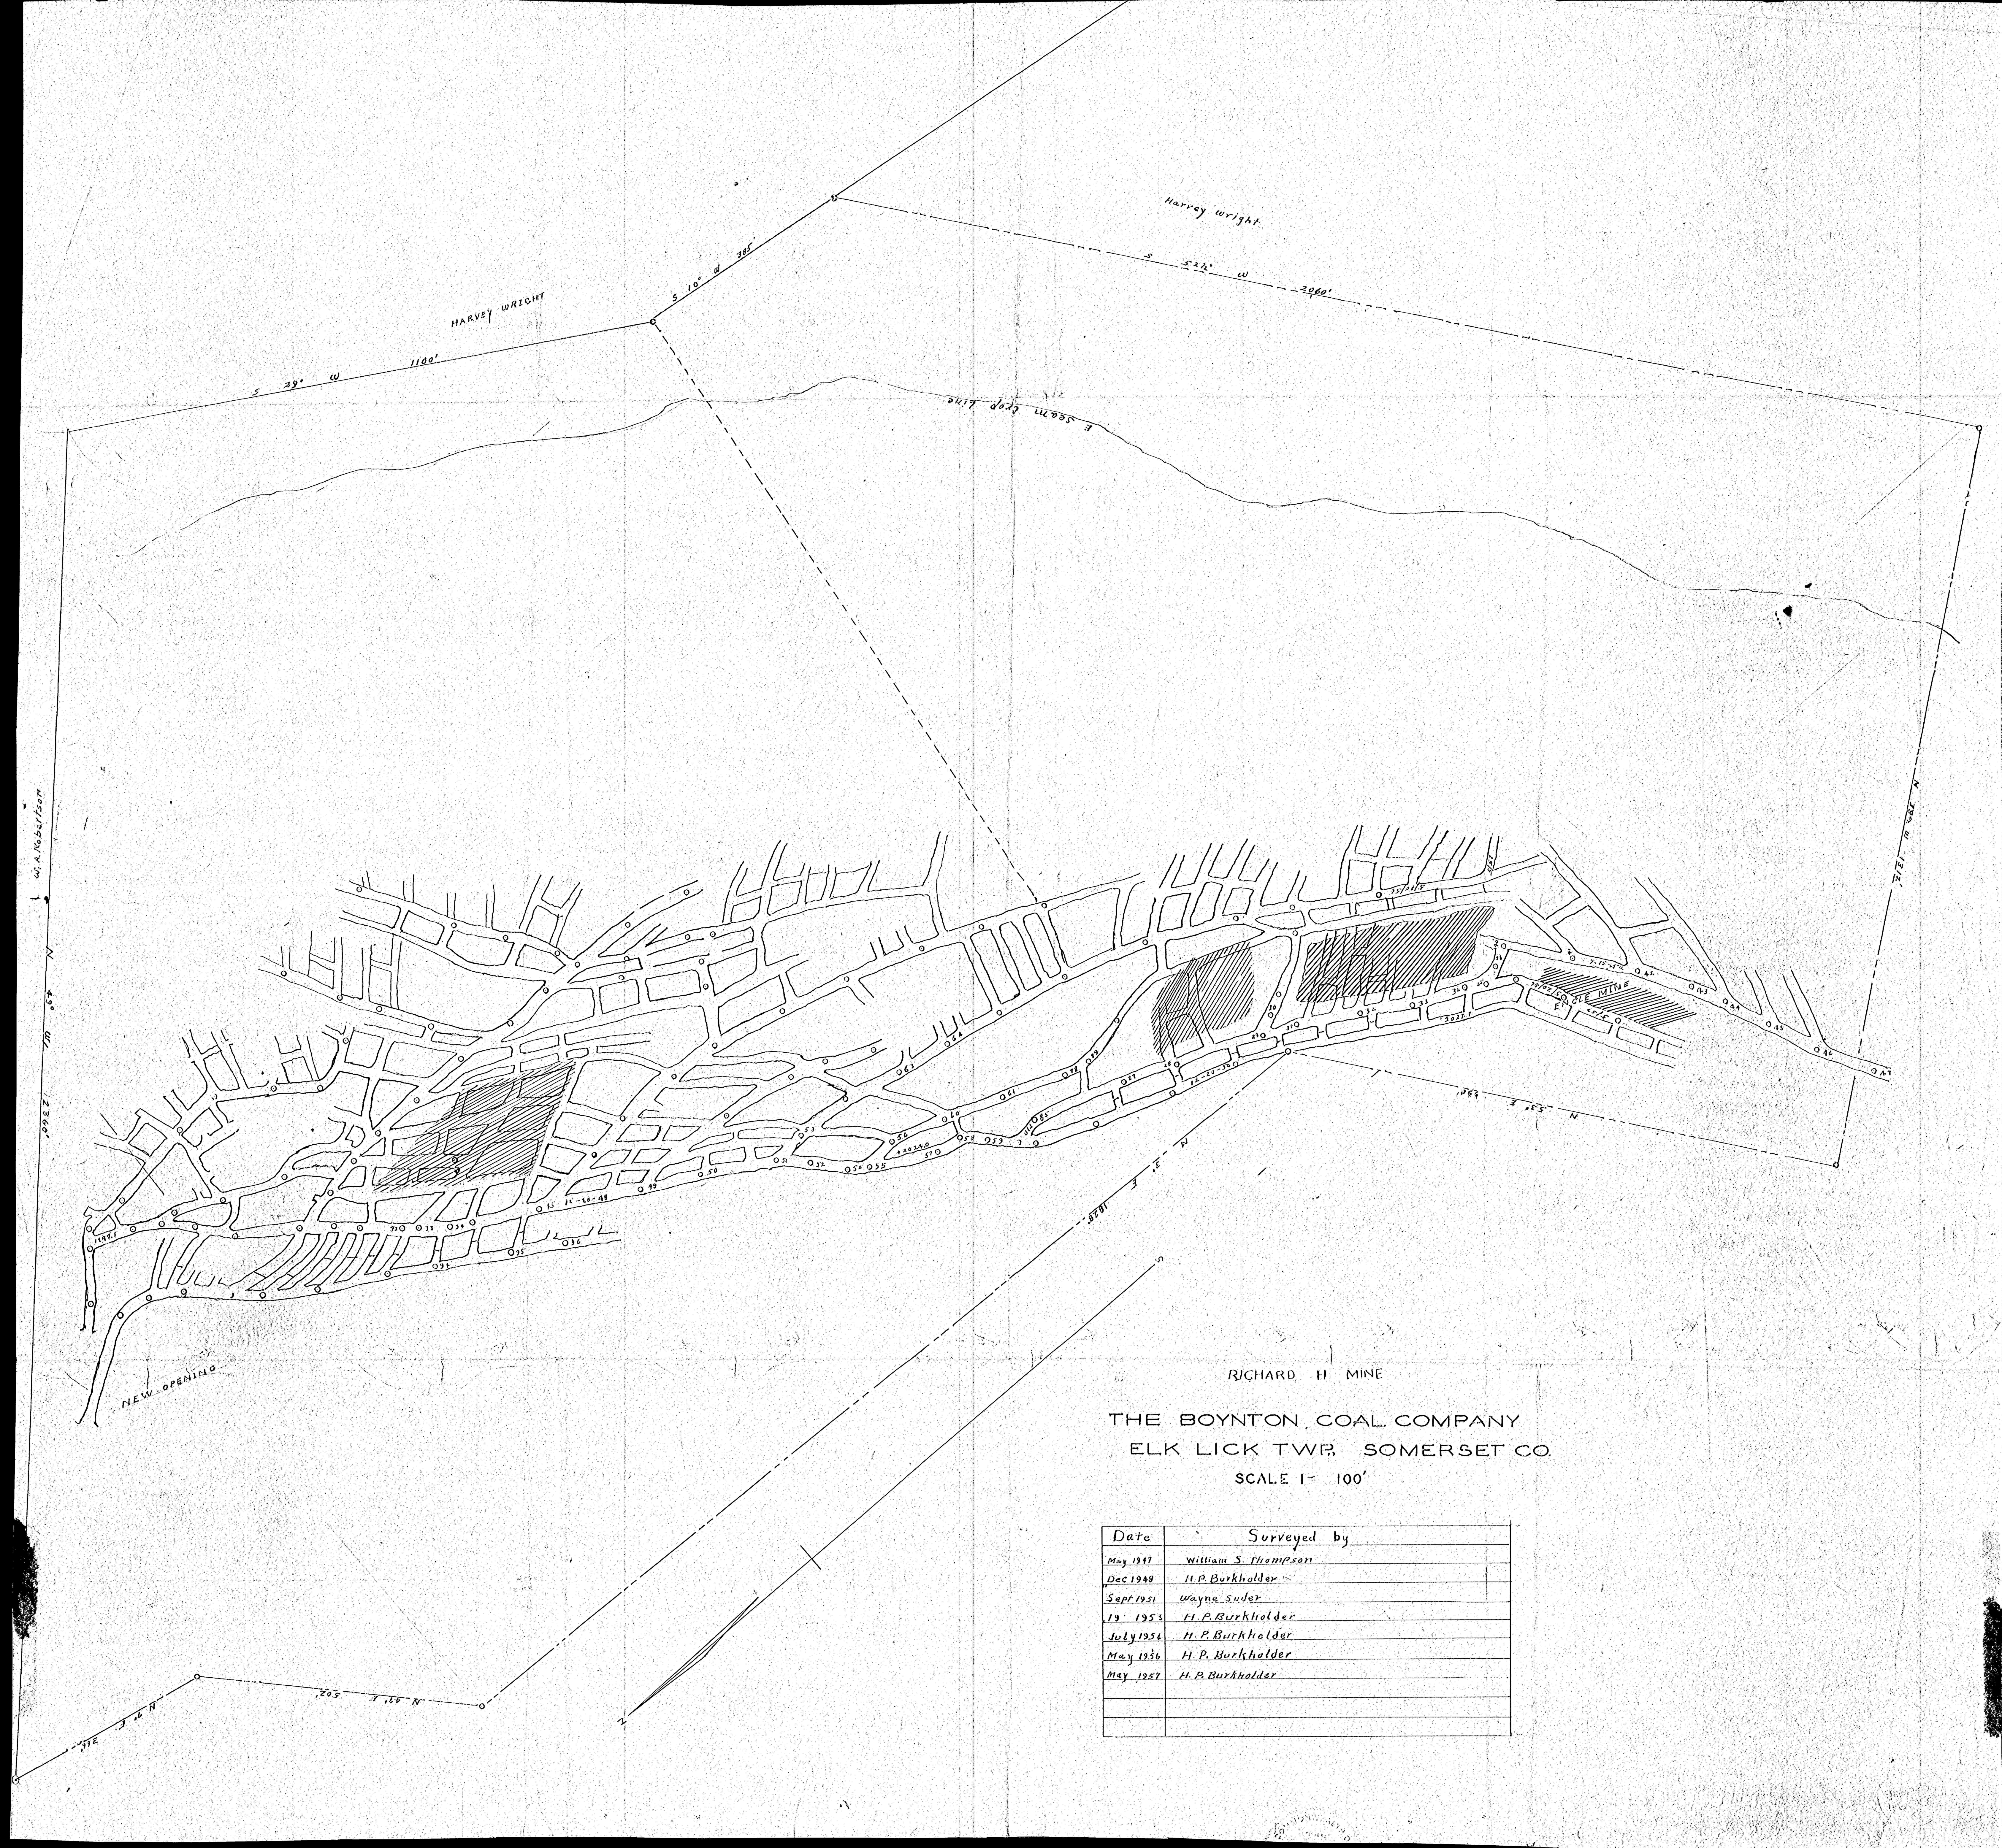

RICHARD H. MINE
THE BOYNTON COAL COMPANY
ELK LICK TWP, SOMERSET CO.
SCALE 1 = 100'

Date	Surveyed by
May 1947	William S. Thompson
Dec 1948	H. P. Burkholder
Sept 1951	Wayne Suder
19 1953	H. P. Burkholder
July 1954	H. P. Burkholder
May 1956	H. P. Burkholder
May 1957	H. P. Burkholder