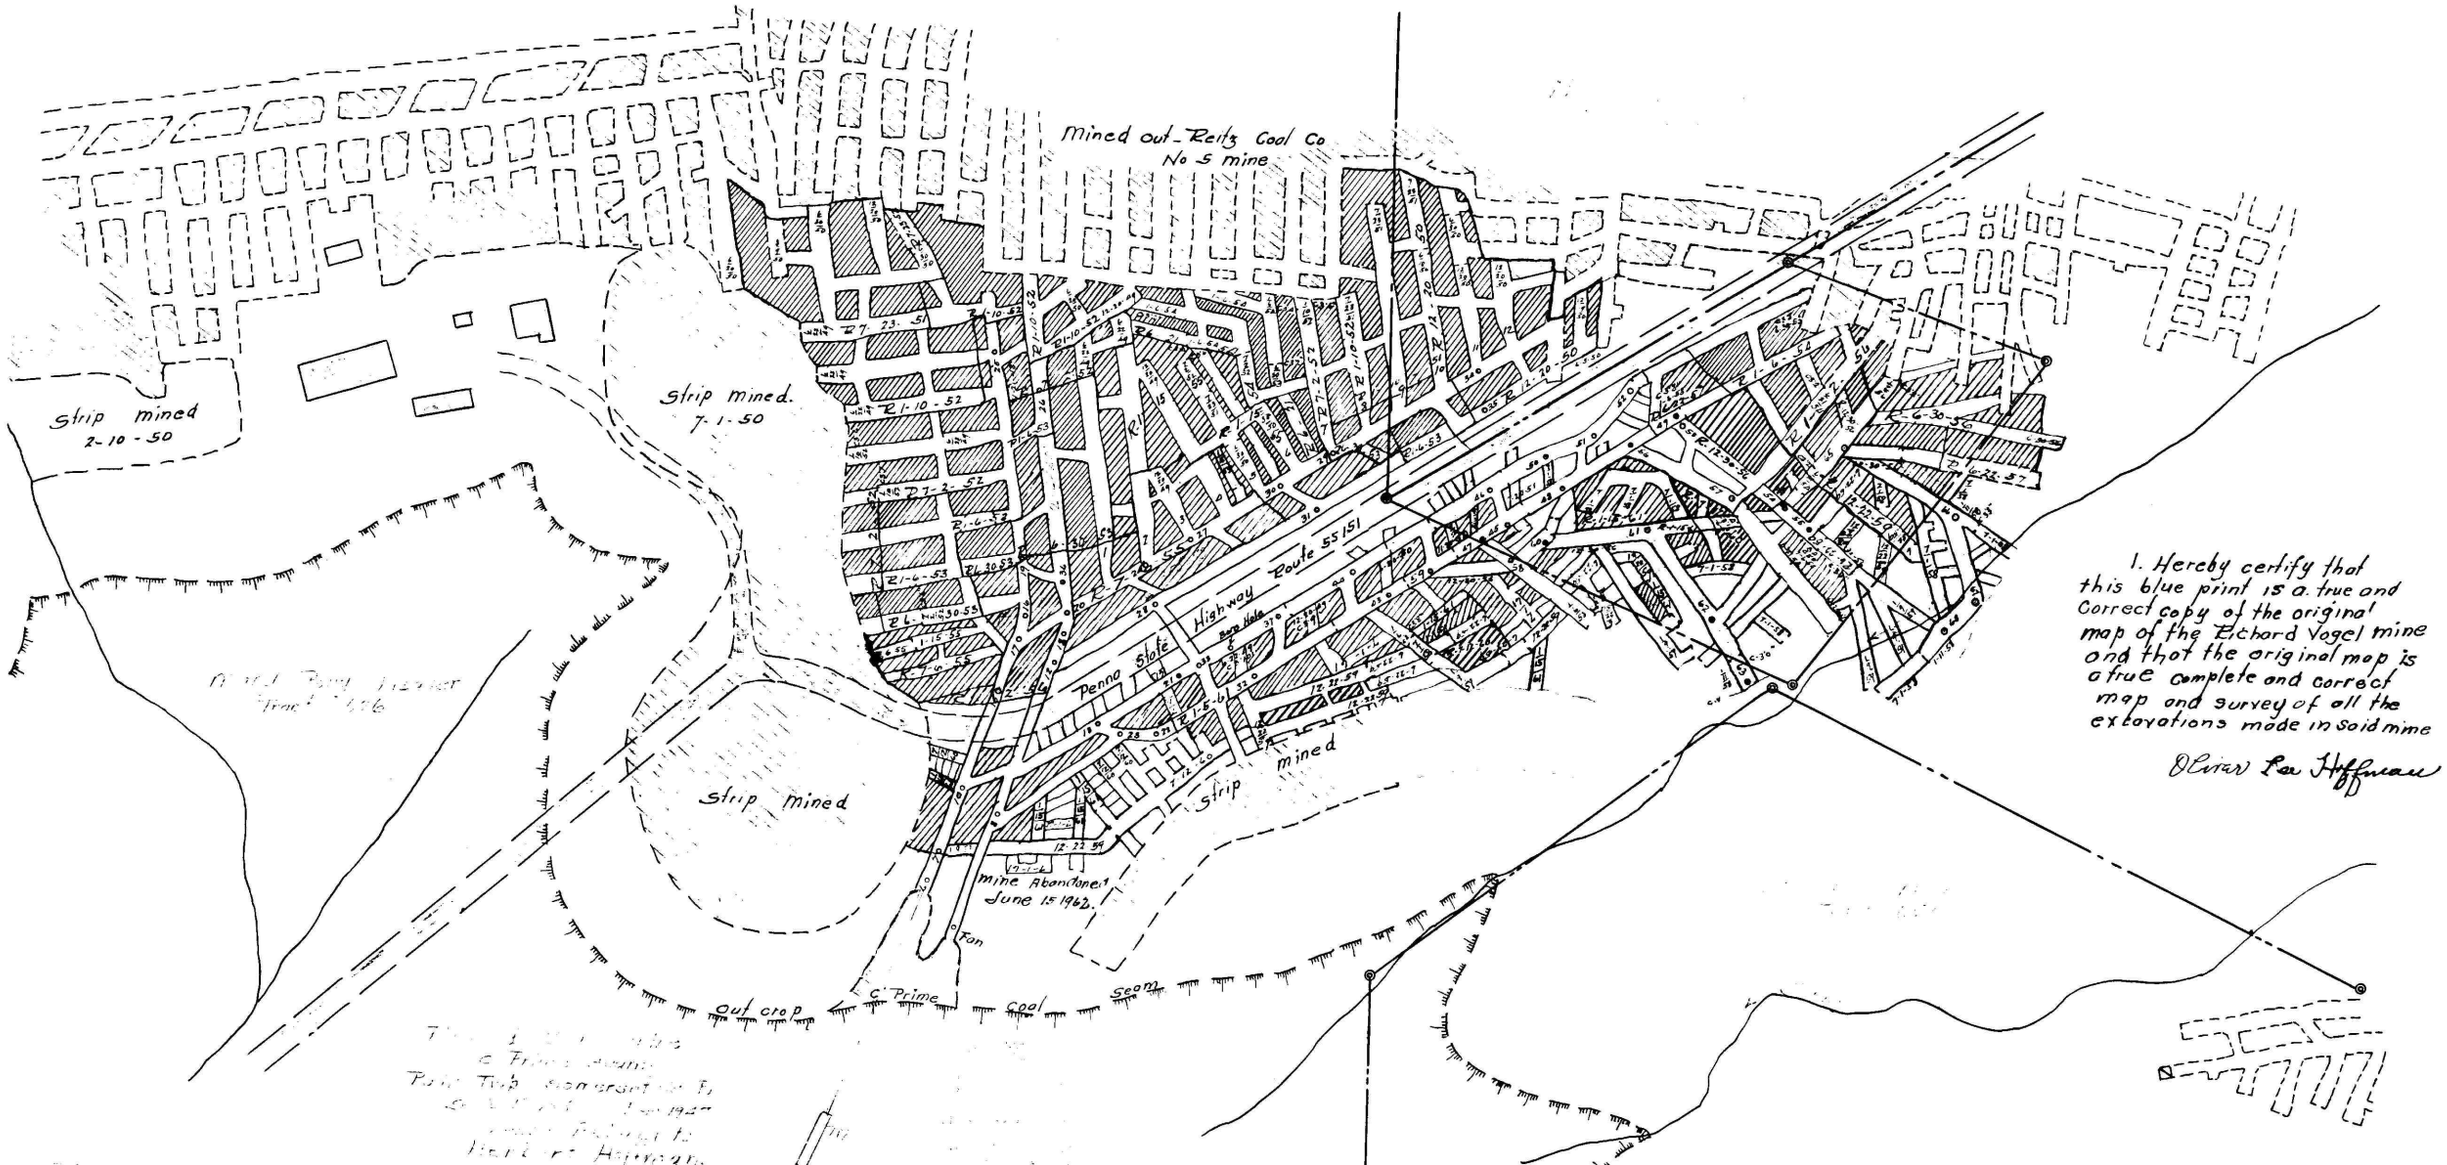
Mined out - Reitz Coal Co
No 5 mine
Strip mined
2-10-50
Strip mined.
7-1-50
Strip mined
Strip mined
Penna State Highway Route 55 151
Mine Abandoned
June 15 1962.
Out crop
C Prime Coal Seam
1. Hereby certify that this blue print is a true and Correct copy of the original map of the Richard Vogel mine and that the original map is a true complete and correct map and survey of all the excavations made in said mine
Oliver Lee Hoffman