



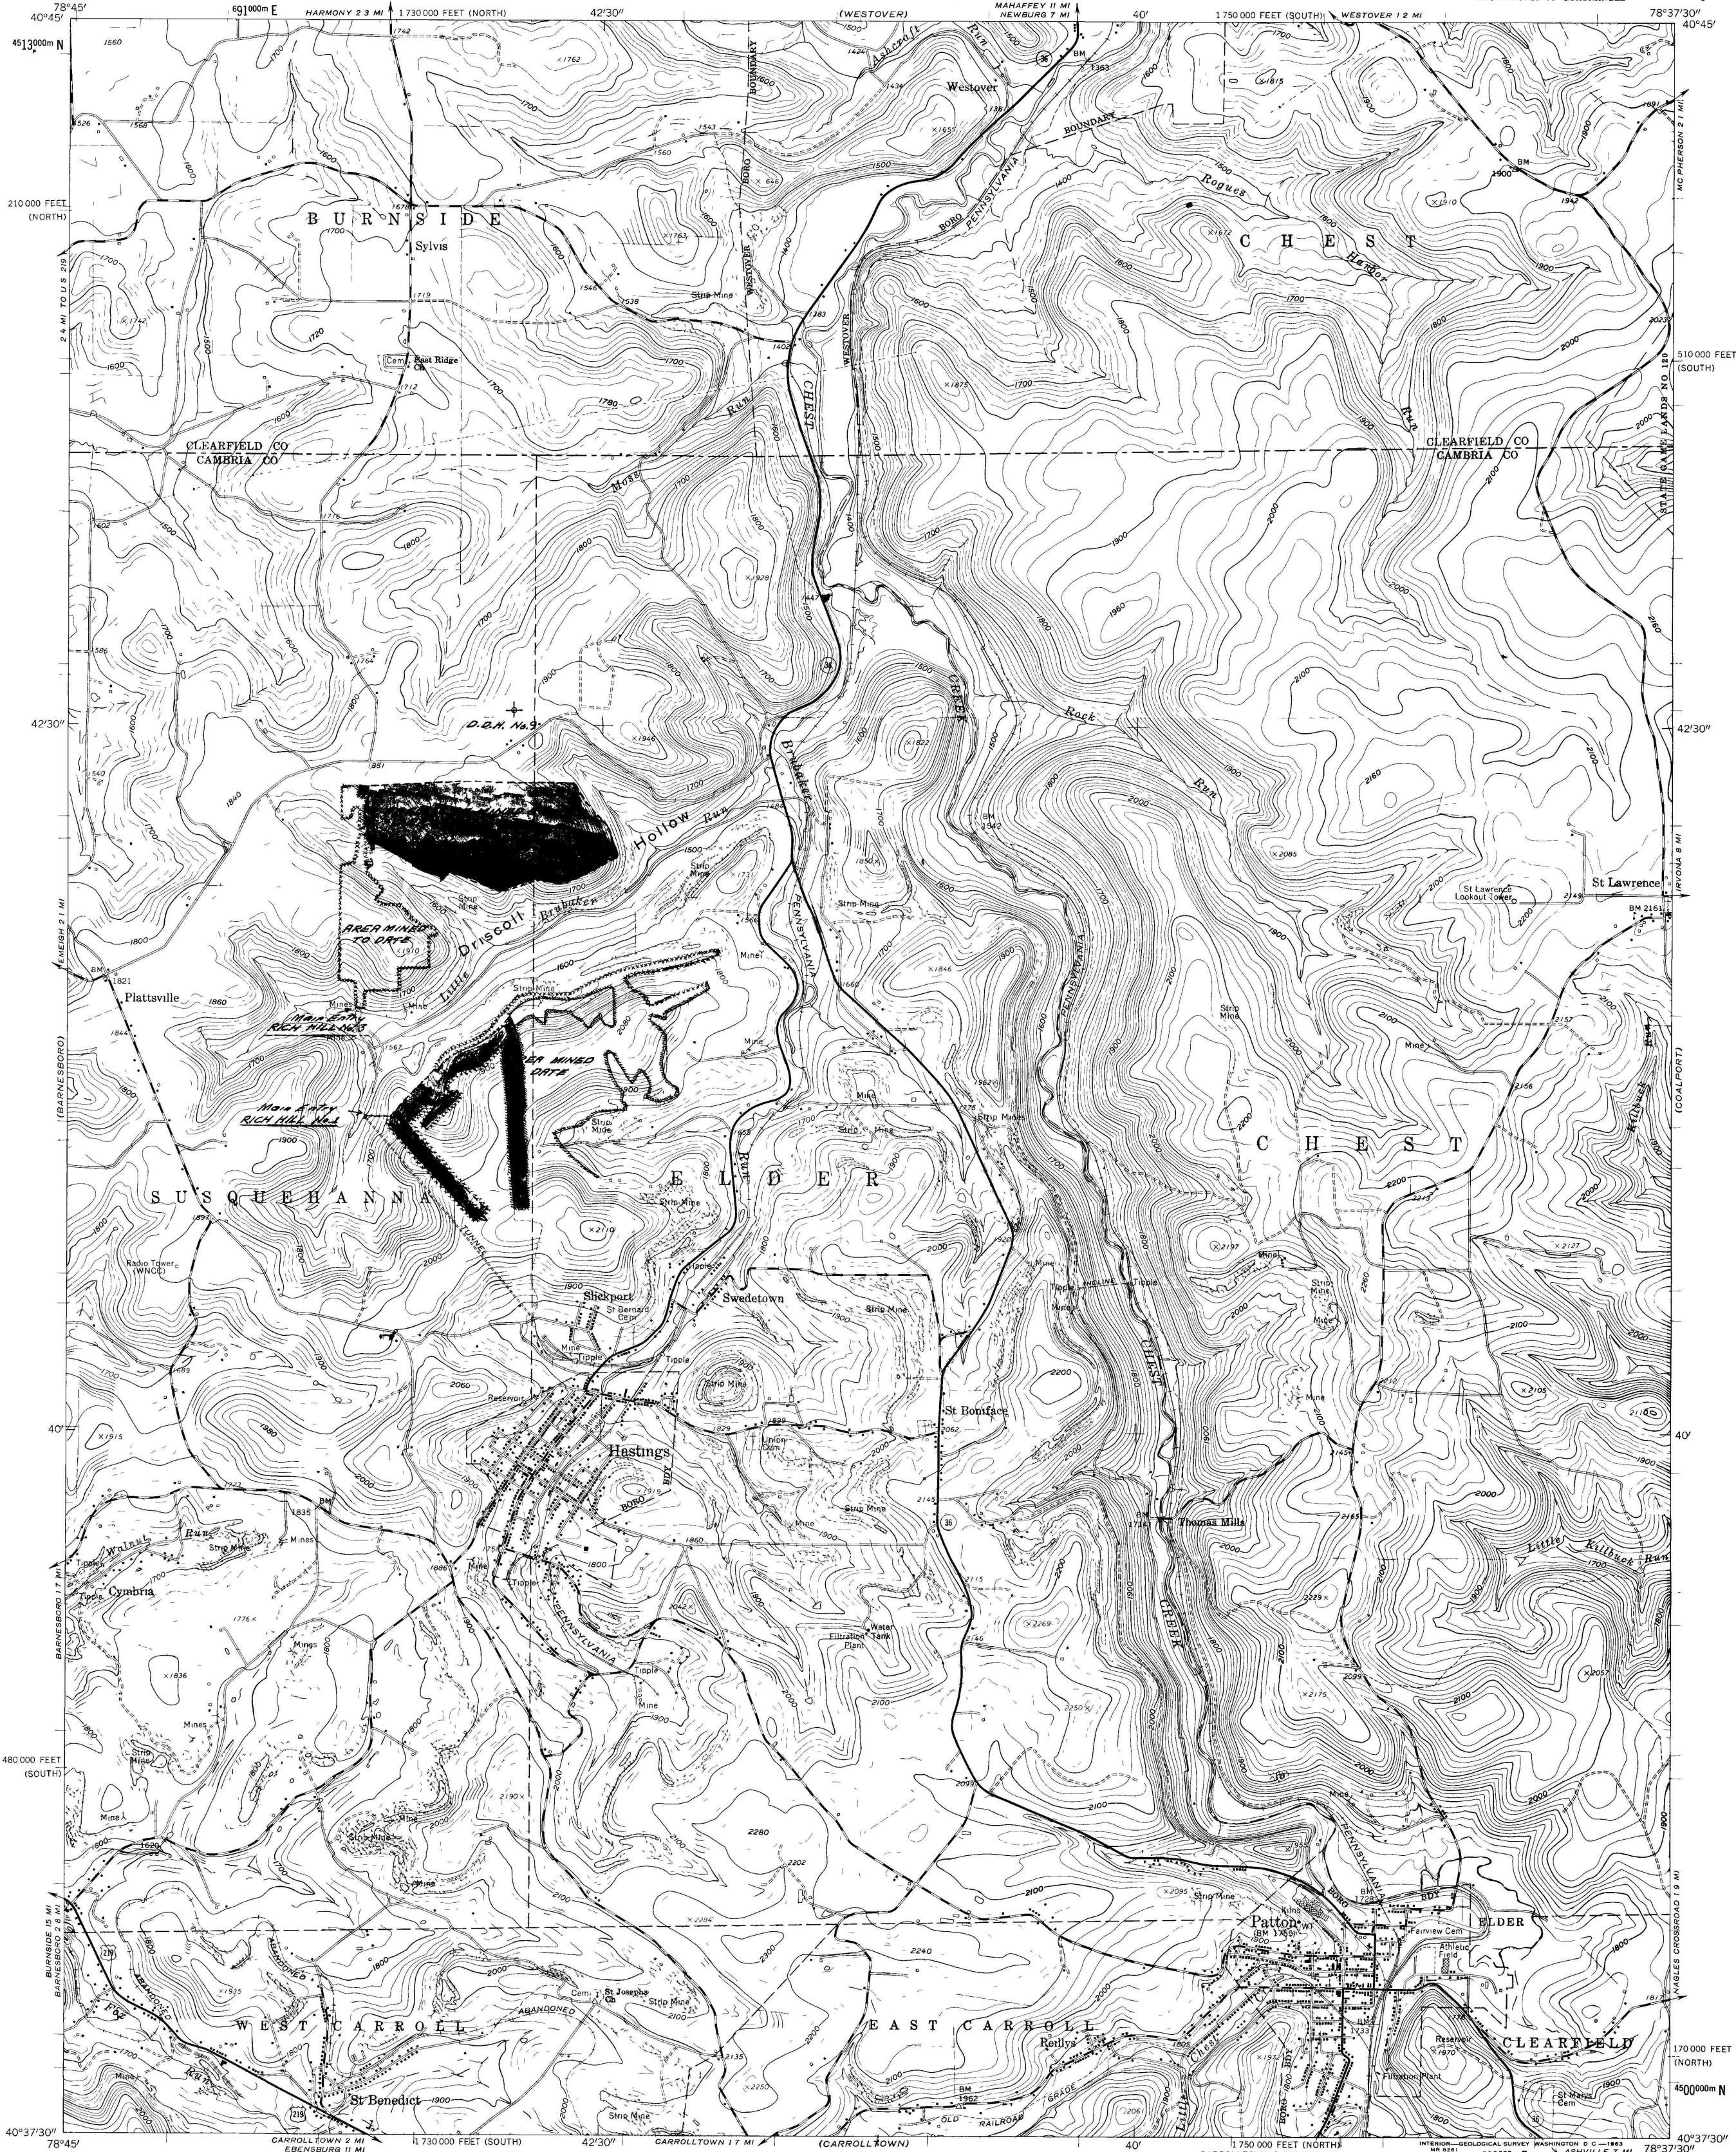

Mapped, edited, and published by the Geological Survey
Control by USGS and USC&GS
Topography by photogrammetric methods from aerial
photographs taken 1958 Field checked 1961
Polyconic projection 1927 North American datum
10,000 foot grids based on Pennsylvania coordinate system,
south and north zones
1000 meter Universal Transverse Mercator grid ticks,
zone 17, shown in blue
Fine red dashed lines indicate selected fence and field lines where
generally visible on aerial photographs This information is unchecked

TRAIL NORTH
MAGNETIC NORTH
APPROXIMATE MEAN
DECLINATION, 1961

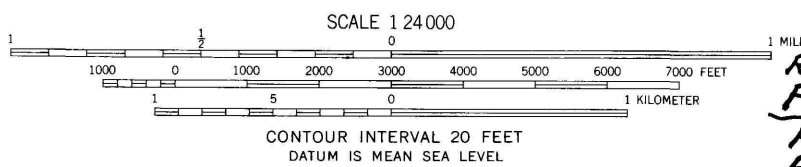

RICH HILL No. 1 MINE
PERMIT NUMBER-203-2
RICH HILL No. 3 MINE
PERMIT NUMBER-203-3

ROAD CLASSIFICATION
Heavy duty ——— Light duty ———
Medium duty ——— Unimproved dirt ———
U Route State Route

HASTINGS, PA
NW 4 PATTON 15' QUADRANGLE
N 4037 5—W 7837 5/7 5

THIS MAP COMPLIES WITH NATIONAL MAP ACCURACY STANDARDS
FOR SALE BY U S GEOLOGICAL SURVEY, WASHINGTON 25, D C
A FOLDER DESCRIBING TOPOGRAPHIC MAPS AND SYMBOLS IS AVAILABLE ON REQUEST

RICH HILL COAL MINING CORPORATION
UPPER FREEPORT COAL AREAS TO BE MINED
8-25-66 - No 1 & No 3 Mines Klemstone

1961

Benjamin R. Auld