


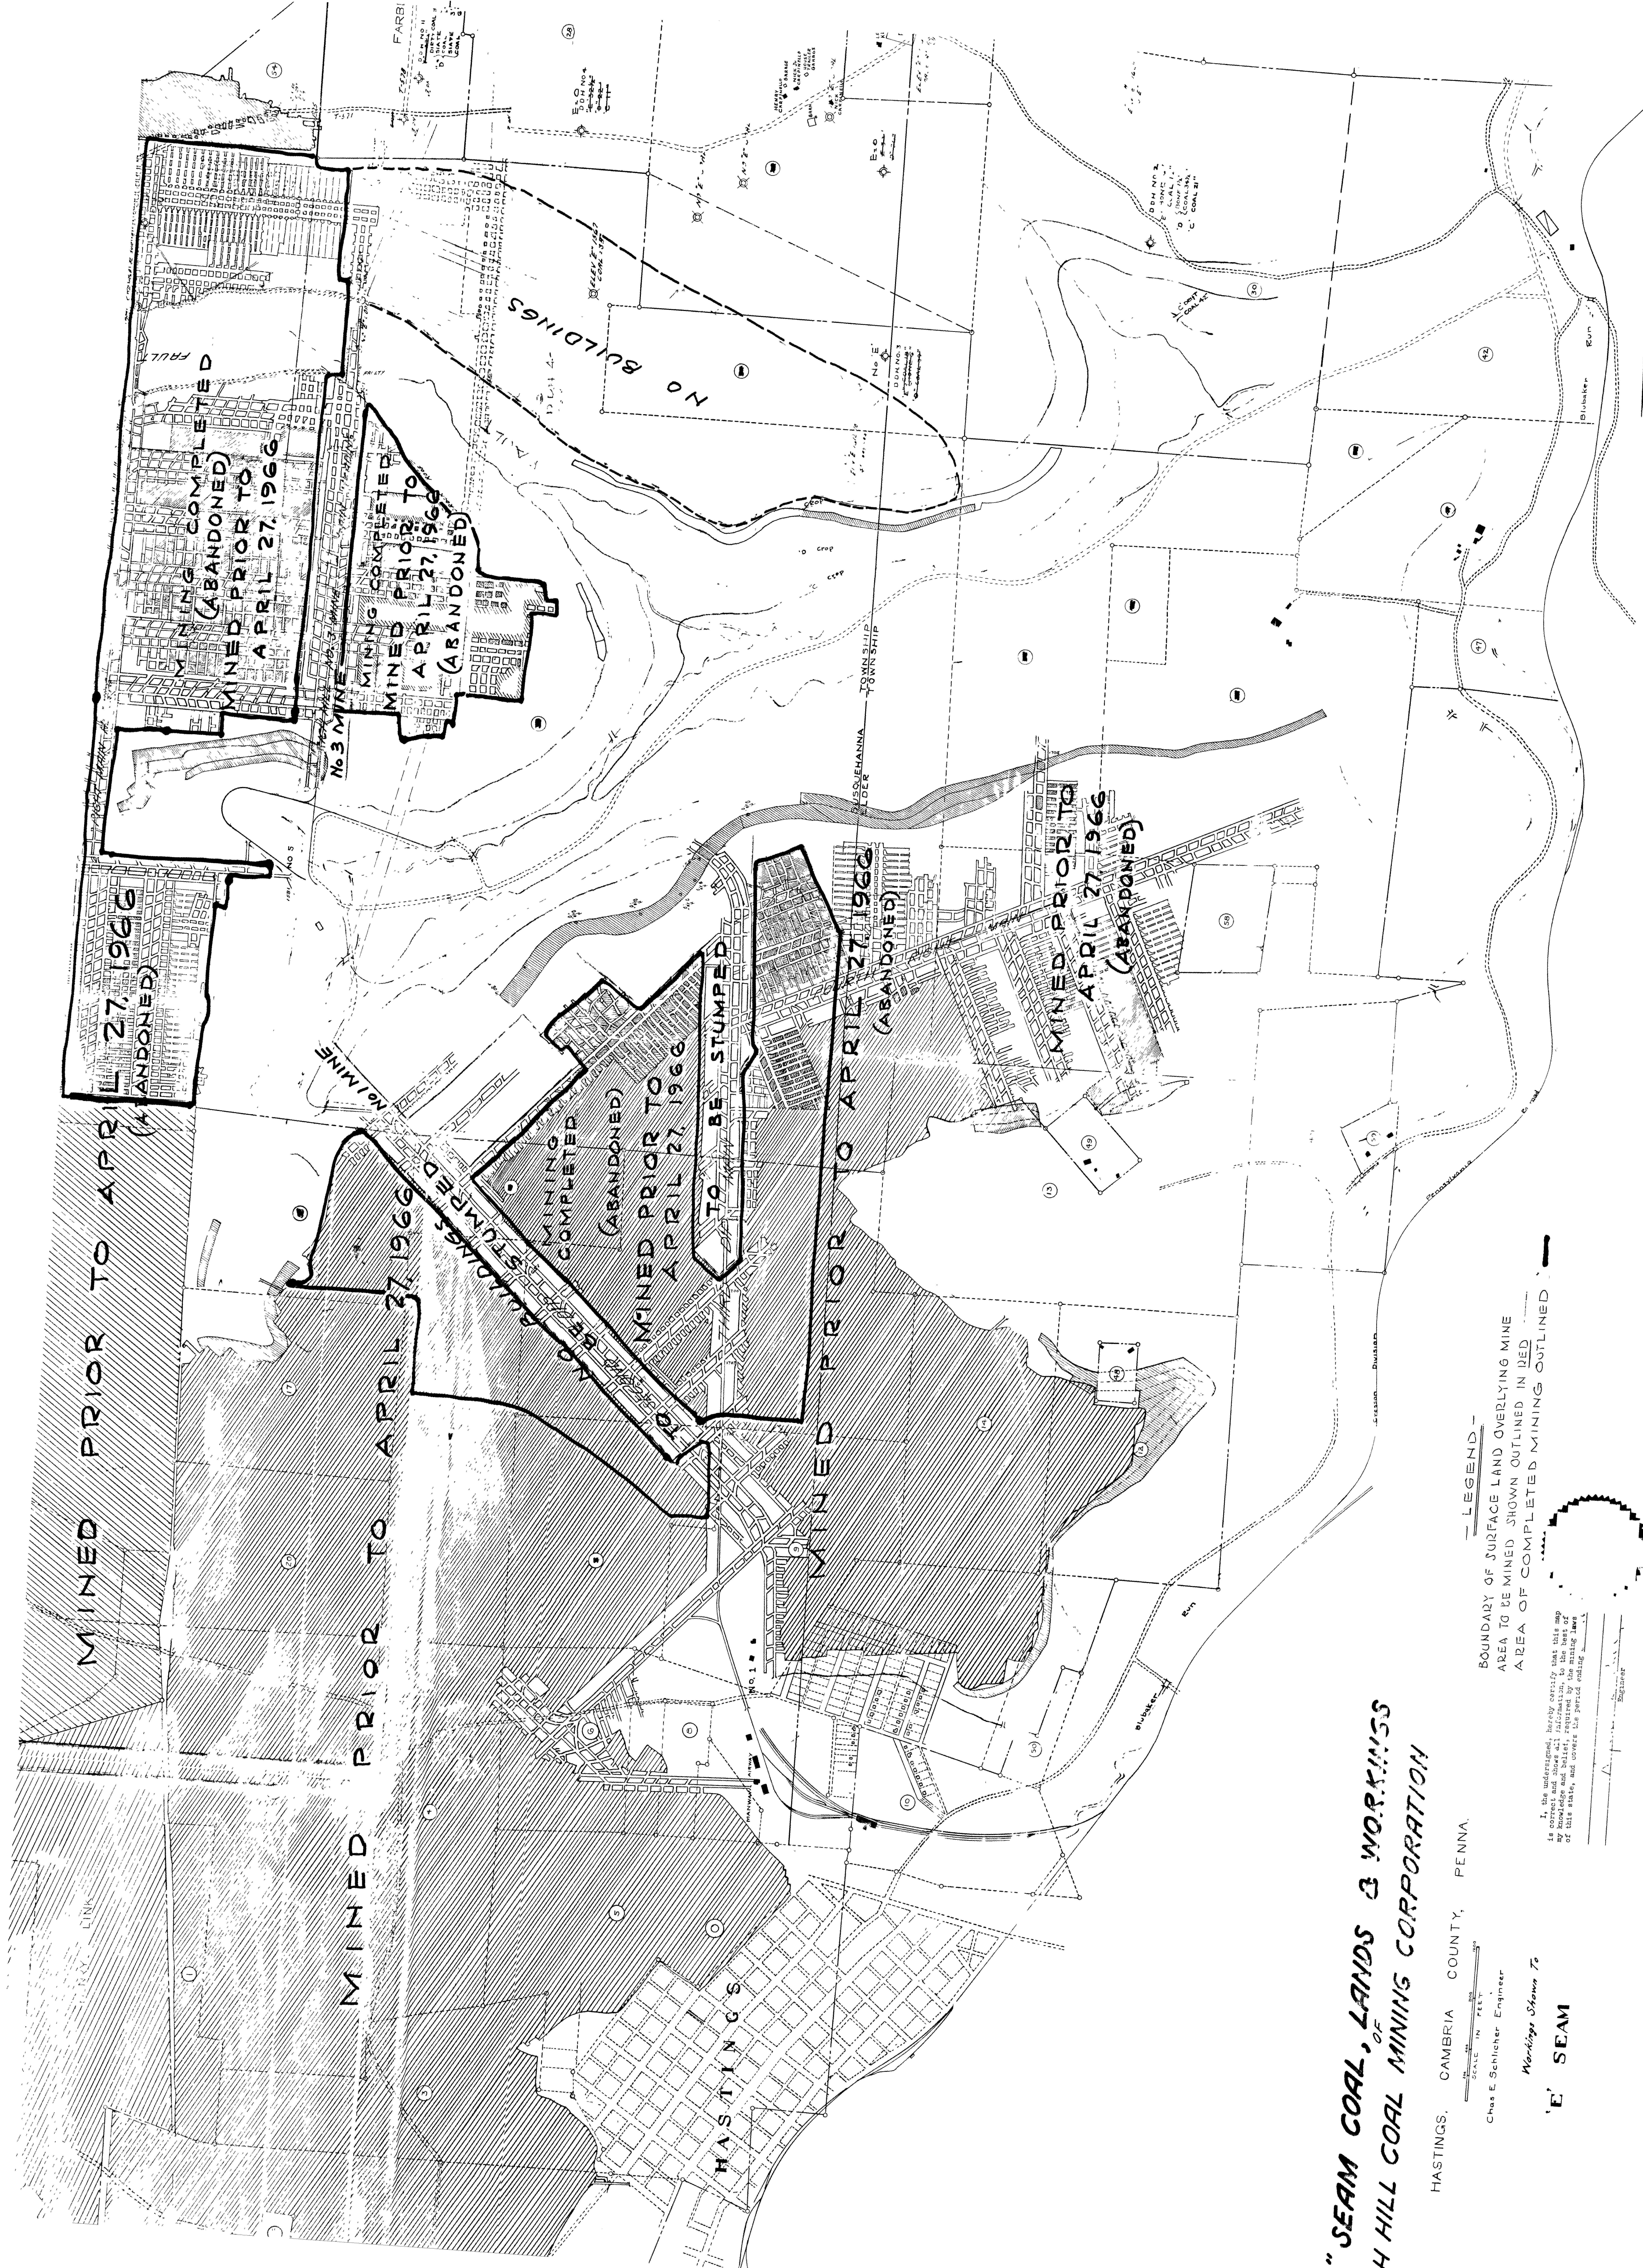

**"E" SEAM COAL LANDS & WORKINGS
OF
RICH HILL COAL MINING CORPORATION**

HASTINGS, CAMBRIA COUNTY, PENNA.

SCALE IN FEET
0 1000
Chas. E. Schlichter, Engineer

Working Status To
'E' SEAM

LEGEND
BOUNDARY OF SURFACE LAND OVERLYING MINE
AREA TO BE MINED SHOWN OUTLINED IN RED
AREA OF COMPLETED MINING OUTLINED

In the underground, hereby certify that this map is correct and shows all information known or believed to be true, and that it was prepared by the mining law of this state, and under the provisions of the same.

RICH HILL - "E" SEAM
MINES 1 & 3 1:2400