


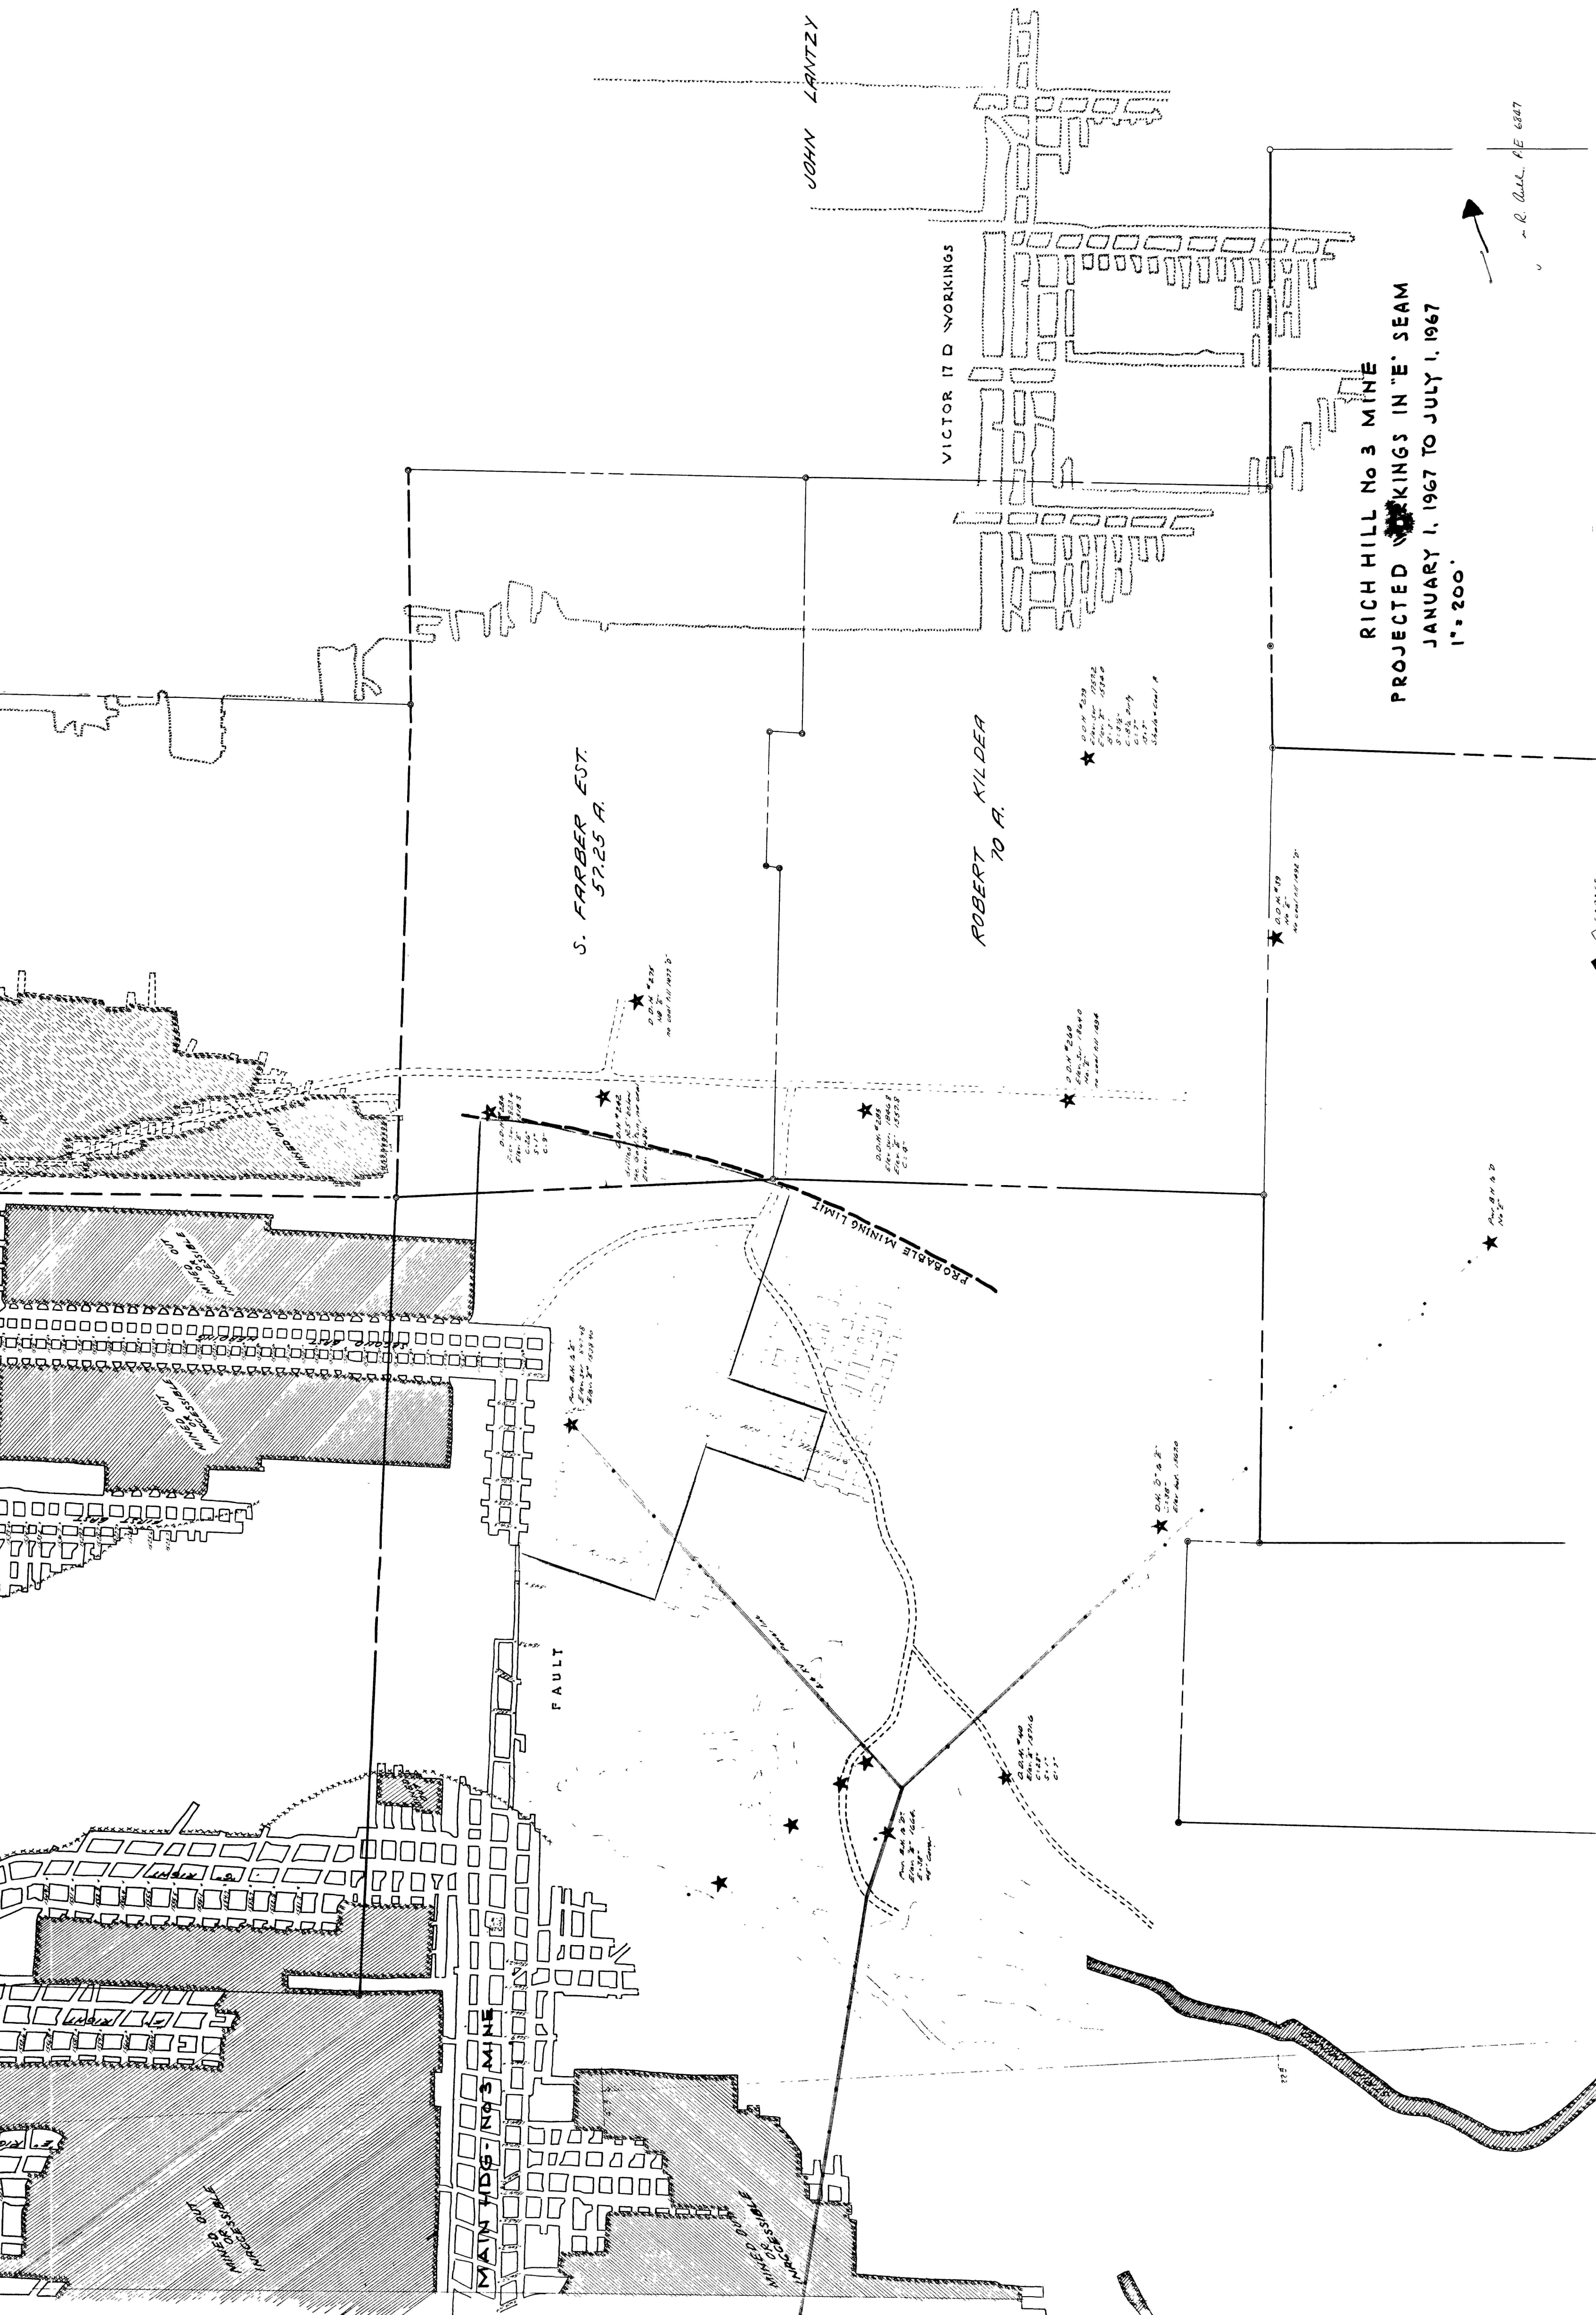

RICH HILL No 3 MINE
PROJECTED WORKINGS IN "E" SEAM
JANUARY 1, 1967 TO JULY 1, 1967
1" = 200'

R. A. L. A. E 6847