


— H.C. Stineman Lease —

— Cambria Steel Co. Lease —

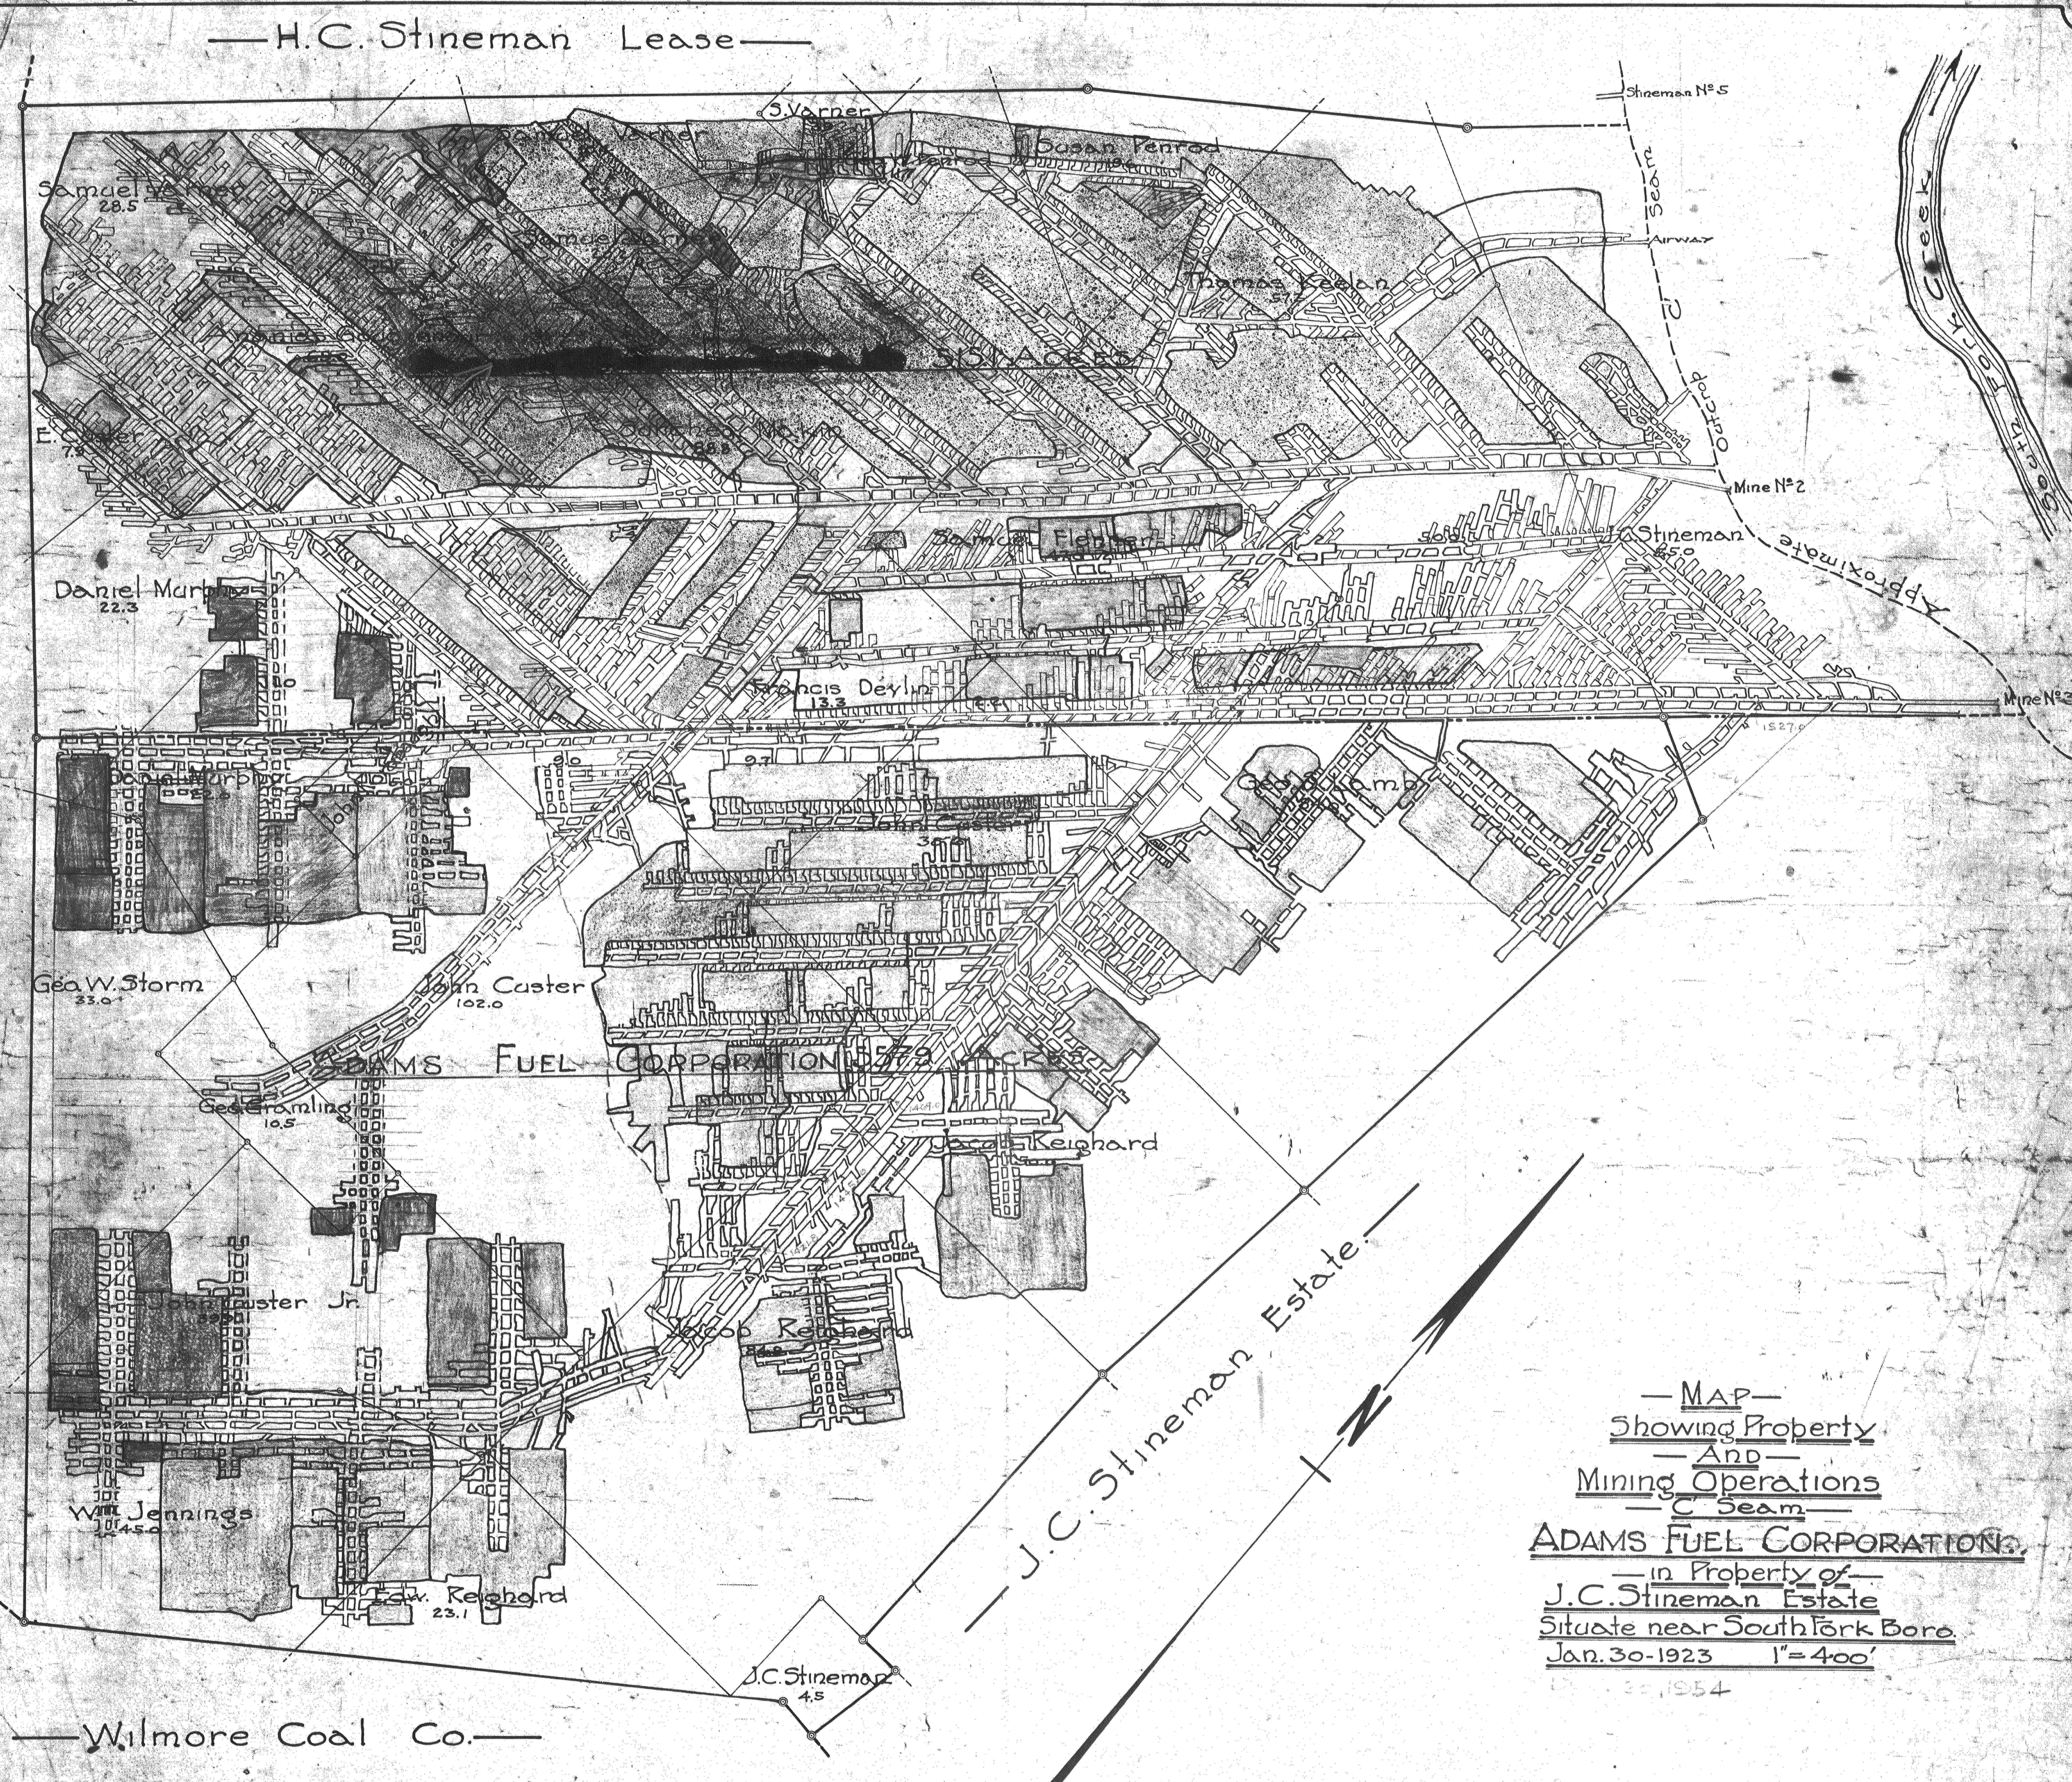

— MAP —
Showing Property
— And —
Mining Operations
— C Seam —
ADAMS FUEL CORPORATION,
— in Property of —
J.C. Stineman Estate
Situate near South Fork Boro.
Jan. 30-1923 1"=400'

30-1924