



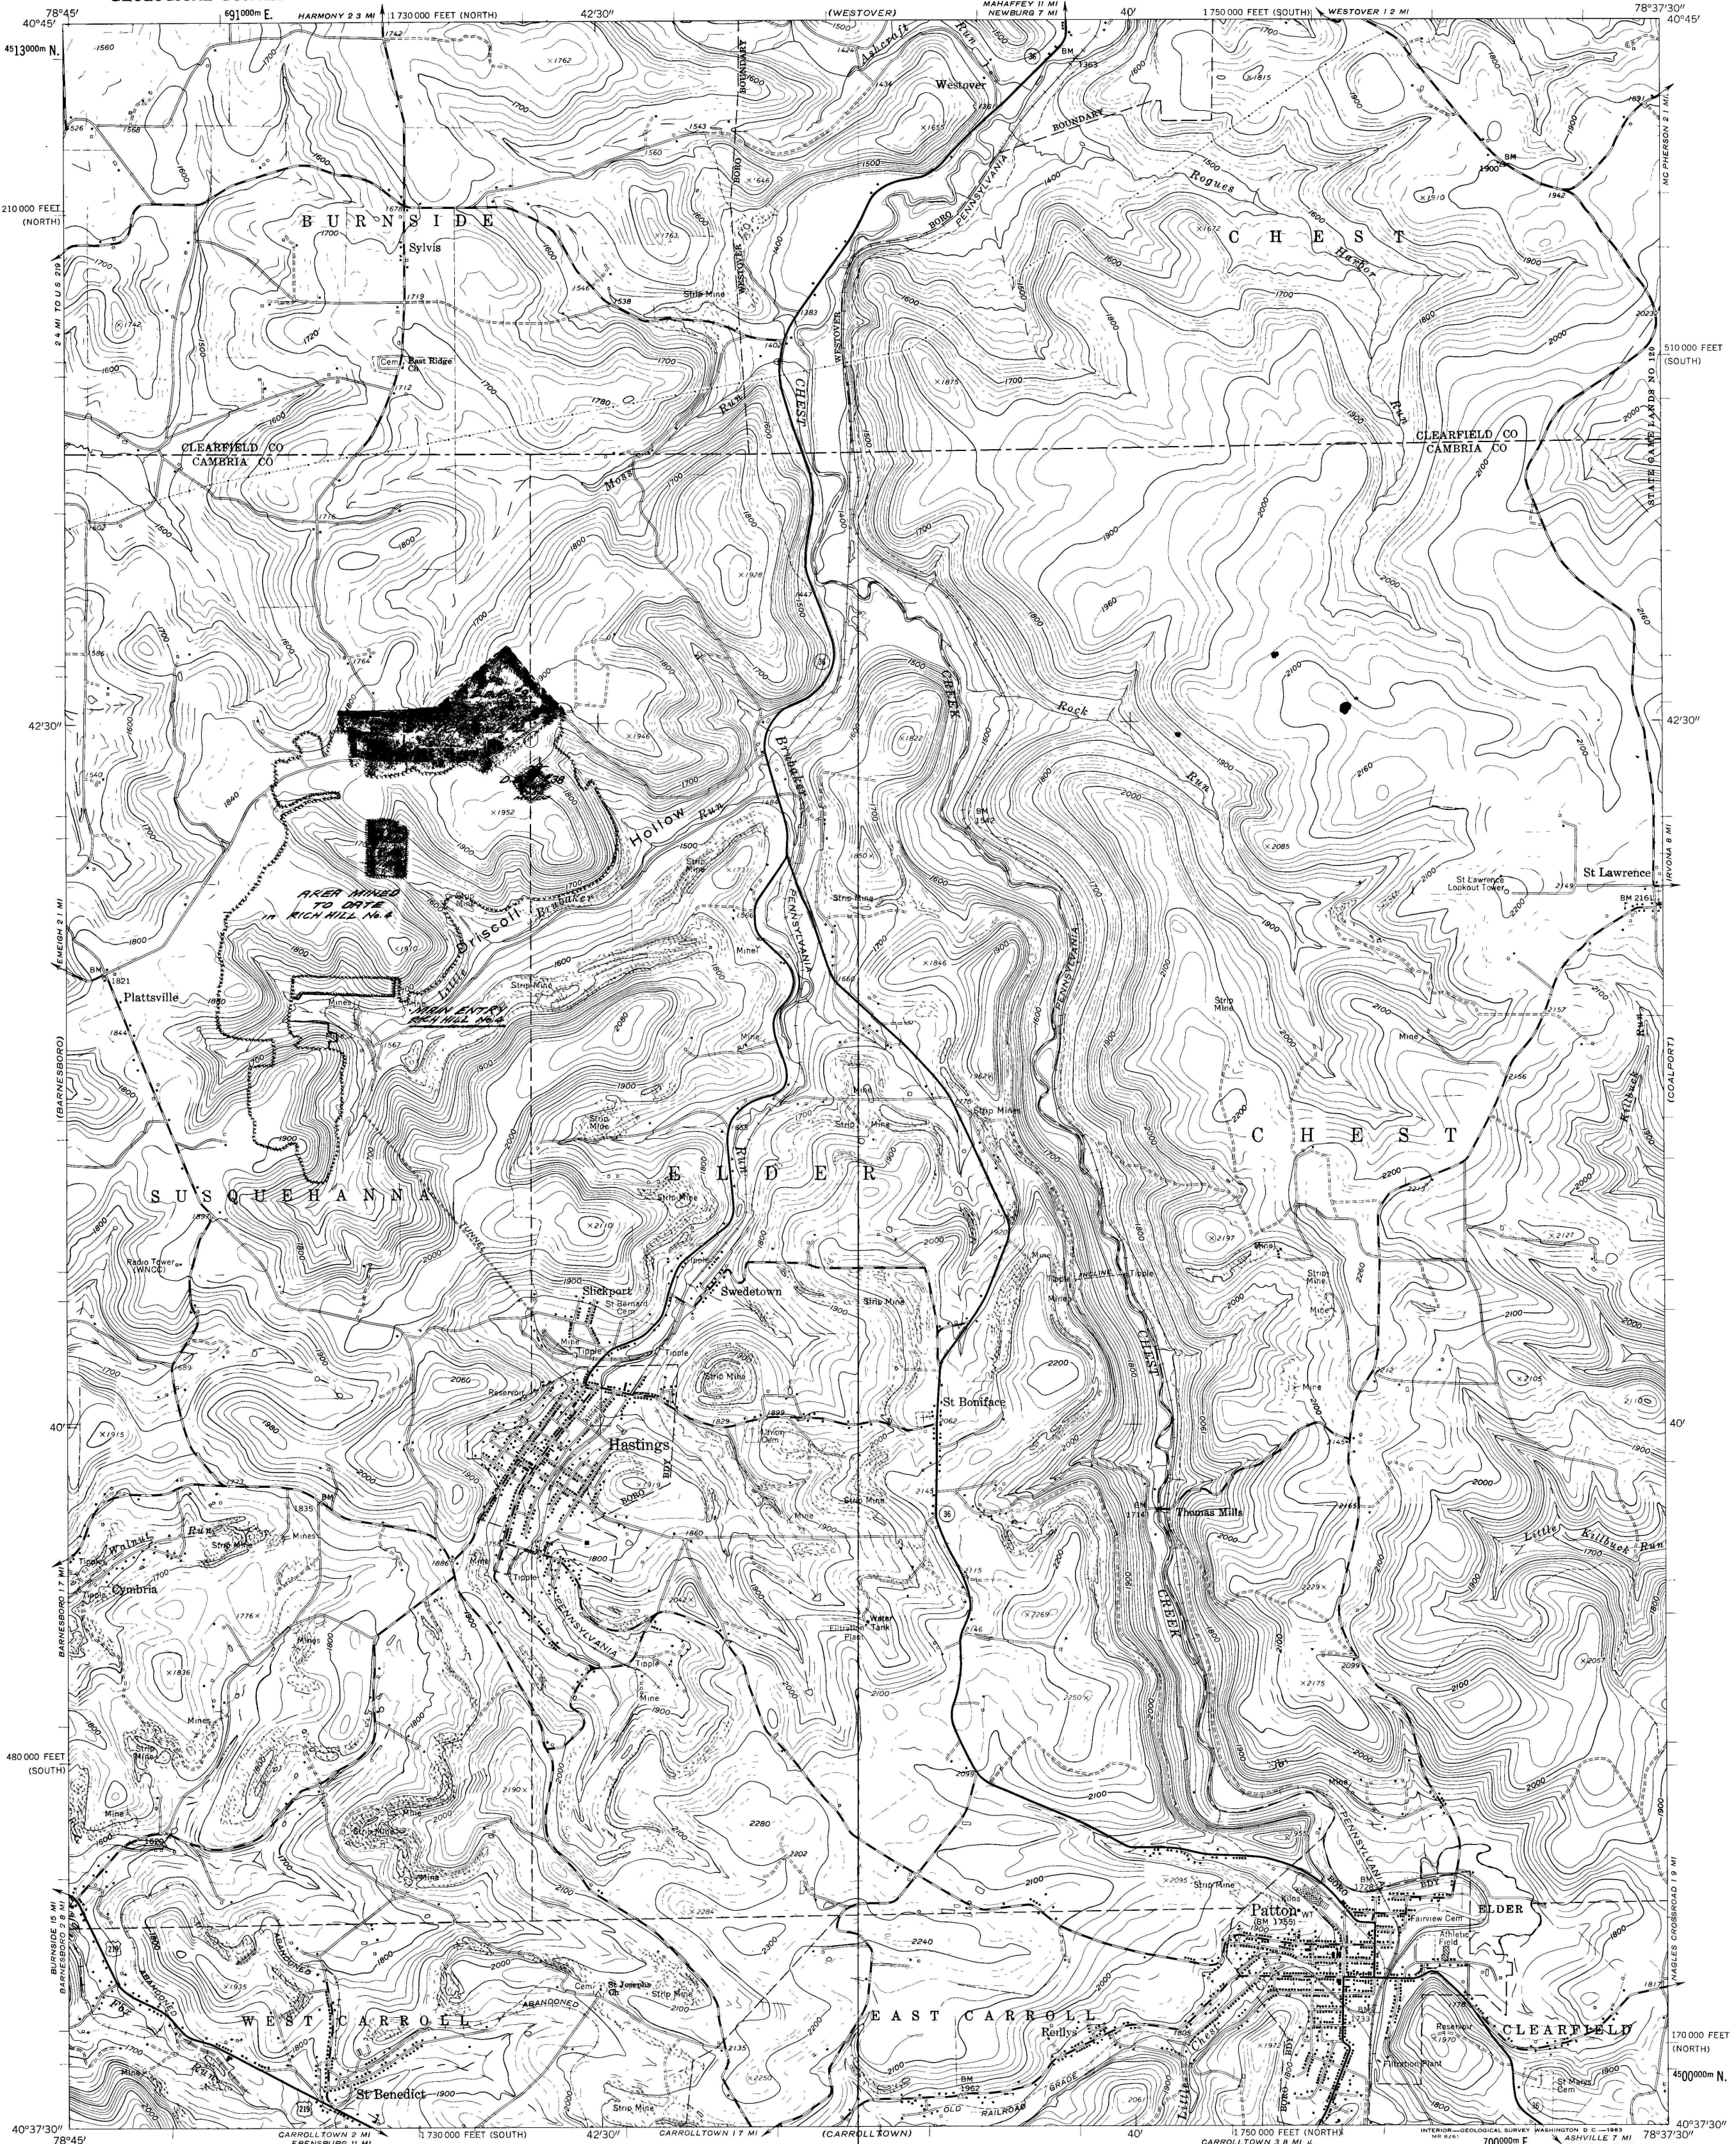


Mapped, edited, and published by the Geological Survey
Control by USGS and USC&GS

Topography by photogrammetric methods from aerial
photographs taken 1958 Field checked 1961

Polyconic projection. 1927 North American datum
10,000-foot grids based on Pennsylvania coordinate system,
south and north zones
1000-meter Universal Transverse Mercator grid ticks,
zone 17, shown in blue

Fine red dashed lines indicate selected fence and field lines where
generally visible on aerial photographs This information is unchecked

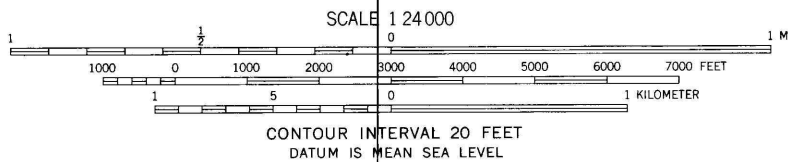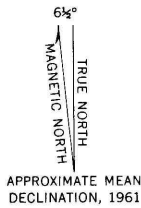

ROAD CLASSIFICATION
Heavy-duty ——— Light duty ———
Medium-duty ——— Unimproved dirt ———
U S Route ——— State Route ———



HASTINGS, PA.
NW 1/4 PATTON 15' QUADRANGLE
N4037 5-W7837 5/7 5

THIS MAP COMPLIES WITH NATIONAL MAP ACCURACY STANDARDS
FOR SALE BY U. S. GEOLOGICAL SURVEY, WASHINGTON 25, D. C.
A FOLDER DESCRIBING TOPOGRAPHIC MAPS AND SYMBOLS IS AVAILABLE ON REQUEST

RICH HILL COAL MINING CORPORATION
LOWER FREEPORT COAL AREAS TO BE MINED 1961
NO 4 MINE
PERMIT NUMBER - 203-4

Benjamin R. Auld