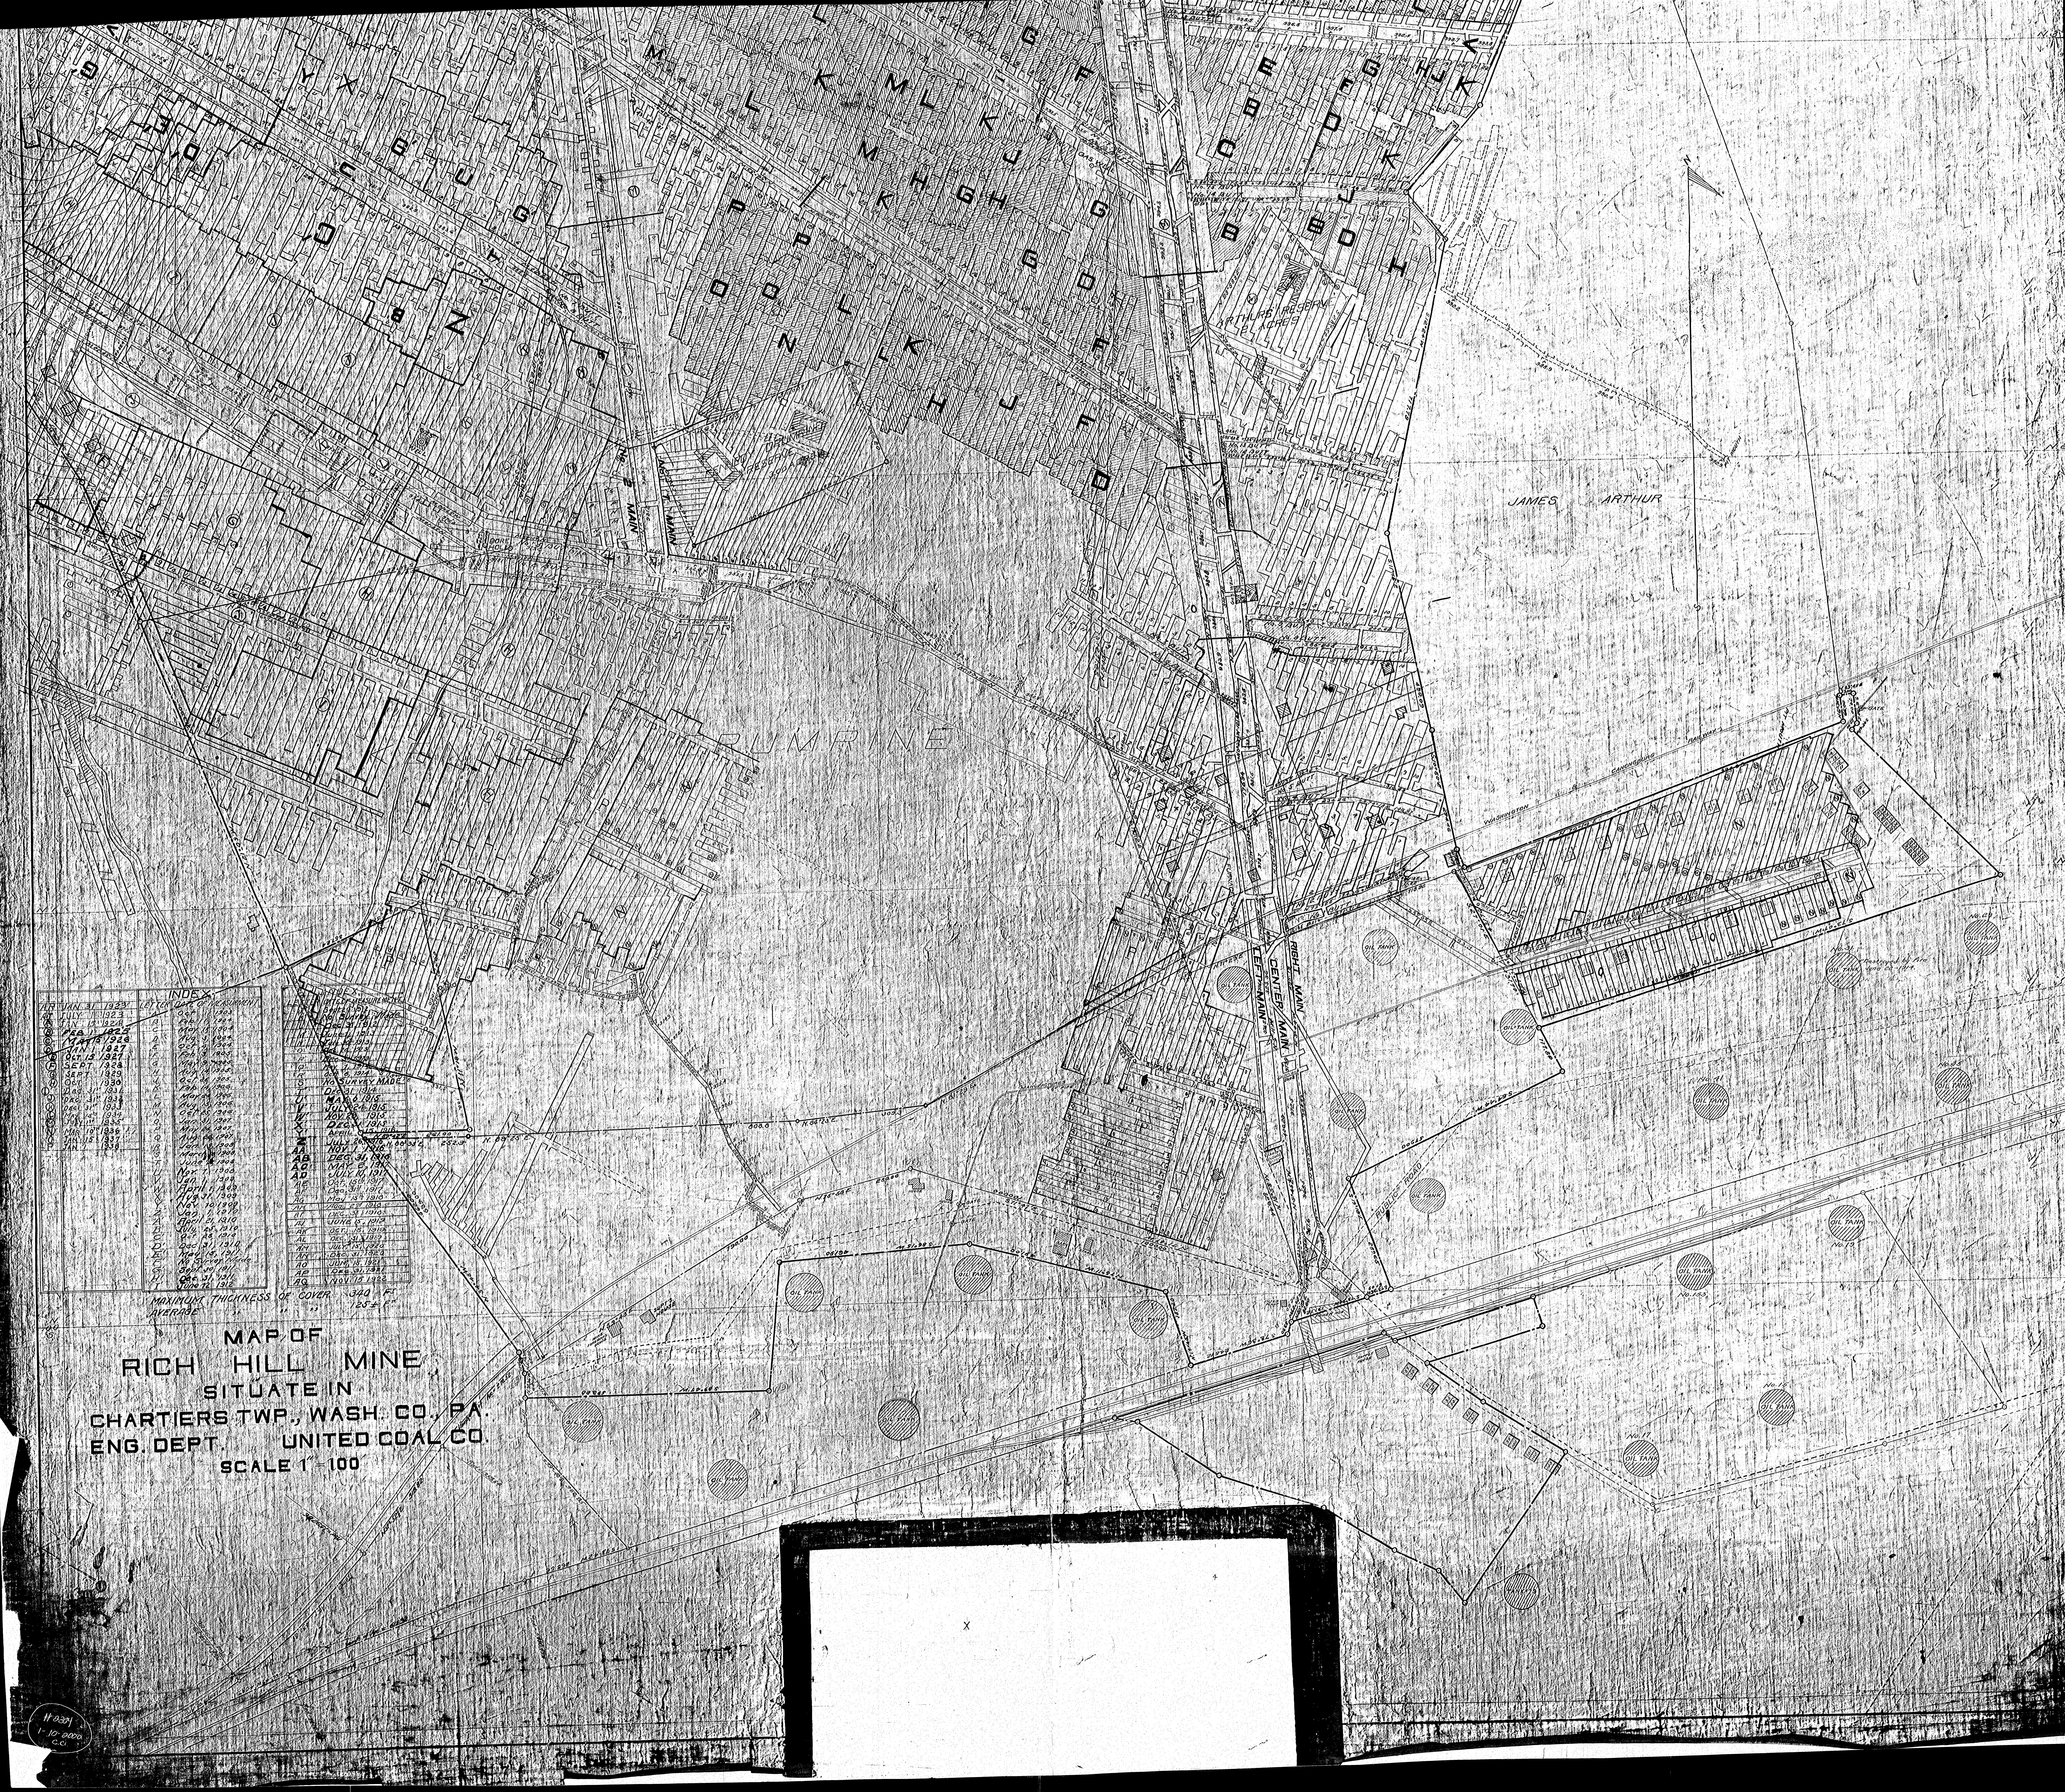

AR	JAN 31 1923
AT	JULY 1 1923
Ⓐ	JAN 15 1924
Ⓑ	FEB 1 1925
Ⓒ	MAY 15 1926
Ⓓ	JAN 1 1927
Ⓔ	OCT 15 1927
Ⓕ	SEPT 1928
Ⓖ	SEPT 1929
Ⓗ	OCT 1930
Ⓘ	DEC 31st 1931
Ⓙ	DEC 31st 1932
Ⓚ	DEC 31st 1933
Ⓛ	MAY 15th 1934
Ⓜ	JULY 1st 1935
Ⓝ	MAR 10th 1936
O	JAN 15 1937
P	JAN 1 1938

INDEX.

LETTER	DATE OF MEASURMENT
A	Oct 1 1903
B	Feb 11 1904
C	May 11 1904
D	Aug 3 1904
E	Oct 4 1904
F	Feb 3 1905
G	May 9 1905
H	Aug 14 1905
J	Oct 26 1905
K	Feb 14 1906
L	May 24 1906
M	Aug 13 1906
N	Oct 25 1906
O	Jan 31 1907
P	May 24 1907
Q	Aug 26 1907
R	Jan 15 1908
S	March 1908
T	June 1908
U	Nov 7 1908
V	Jan 1 1909
W	April 1 1909
X	Aug 31 1909
Y	Nov 10 1909
Z	Jan 1 1910
A'	April 21 1910
B'	July 25 1910
C'	Oct 28 1910
D'	Dec 31 1910
E'	May 15 1911
F'	No Survey Made
G'	Sept 30 1911
H'	Dec 31 1911
I'	June 12 1912

INDEX.

LETTER	DATE OF MEASUREMENT
J'	Sept 20 1912
K'	No Survey Made
L'	Dec 31 1912
M'	June 1 1913
N'	July 30 1913
O'	Dec 29 1913
P'	Dec 31 1913
Q'	May 1 1914
R'	Oct 6 1914
S'	NO SURVEY MADE
T'	DEC 31 1914
U'	MAY 6 1915
V'	JULY 24 1915
W'	NOV 29 1915
X'	DEC 31 1915
Y'	APRIL 15 1916
Z'	JULY 26 1916
AA	NOV 1 1916
AB	DEC 31 1916
AC	MAY 2 1917
AD	JULY 10 1917
AE	Oct 15th 1917
AF	Dec 31st 1917
AG	May 15th 1918
AH	Aug 2nd 1918
AI	DEC 31 1918
AJ	JUNE 15 1919
AK	OCT 15 1919
AL	DEC 31 1919
AM	JULY 15 1920
AN	DEC 31 1920
AO	JUN 15 1921
AP	DEC 31 1921
AQ	NOV 15 1922

MAXIMUM THICKNESS OF COVER 340 FT
AVERAGE " " " 125 ± FT

MAP OF
RICH HILL MINE,
SITUATE IN
CHARTIERS TWP., WASH. CO., PA.
ENG. DEPT. UNITED COAL CO.
SCALE 1" = 100

#2204
1-10-2000
C.C.