


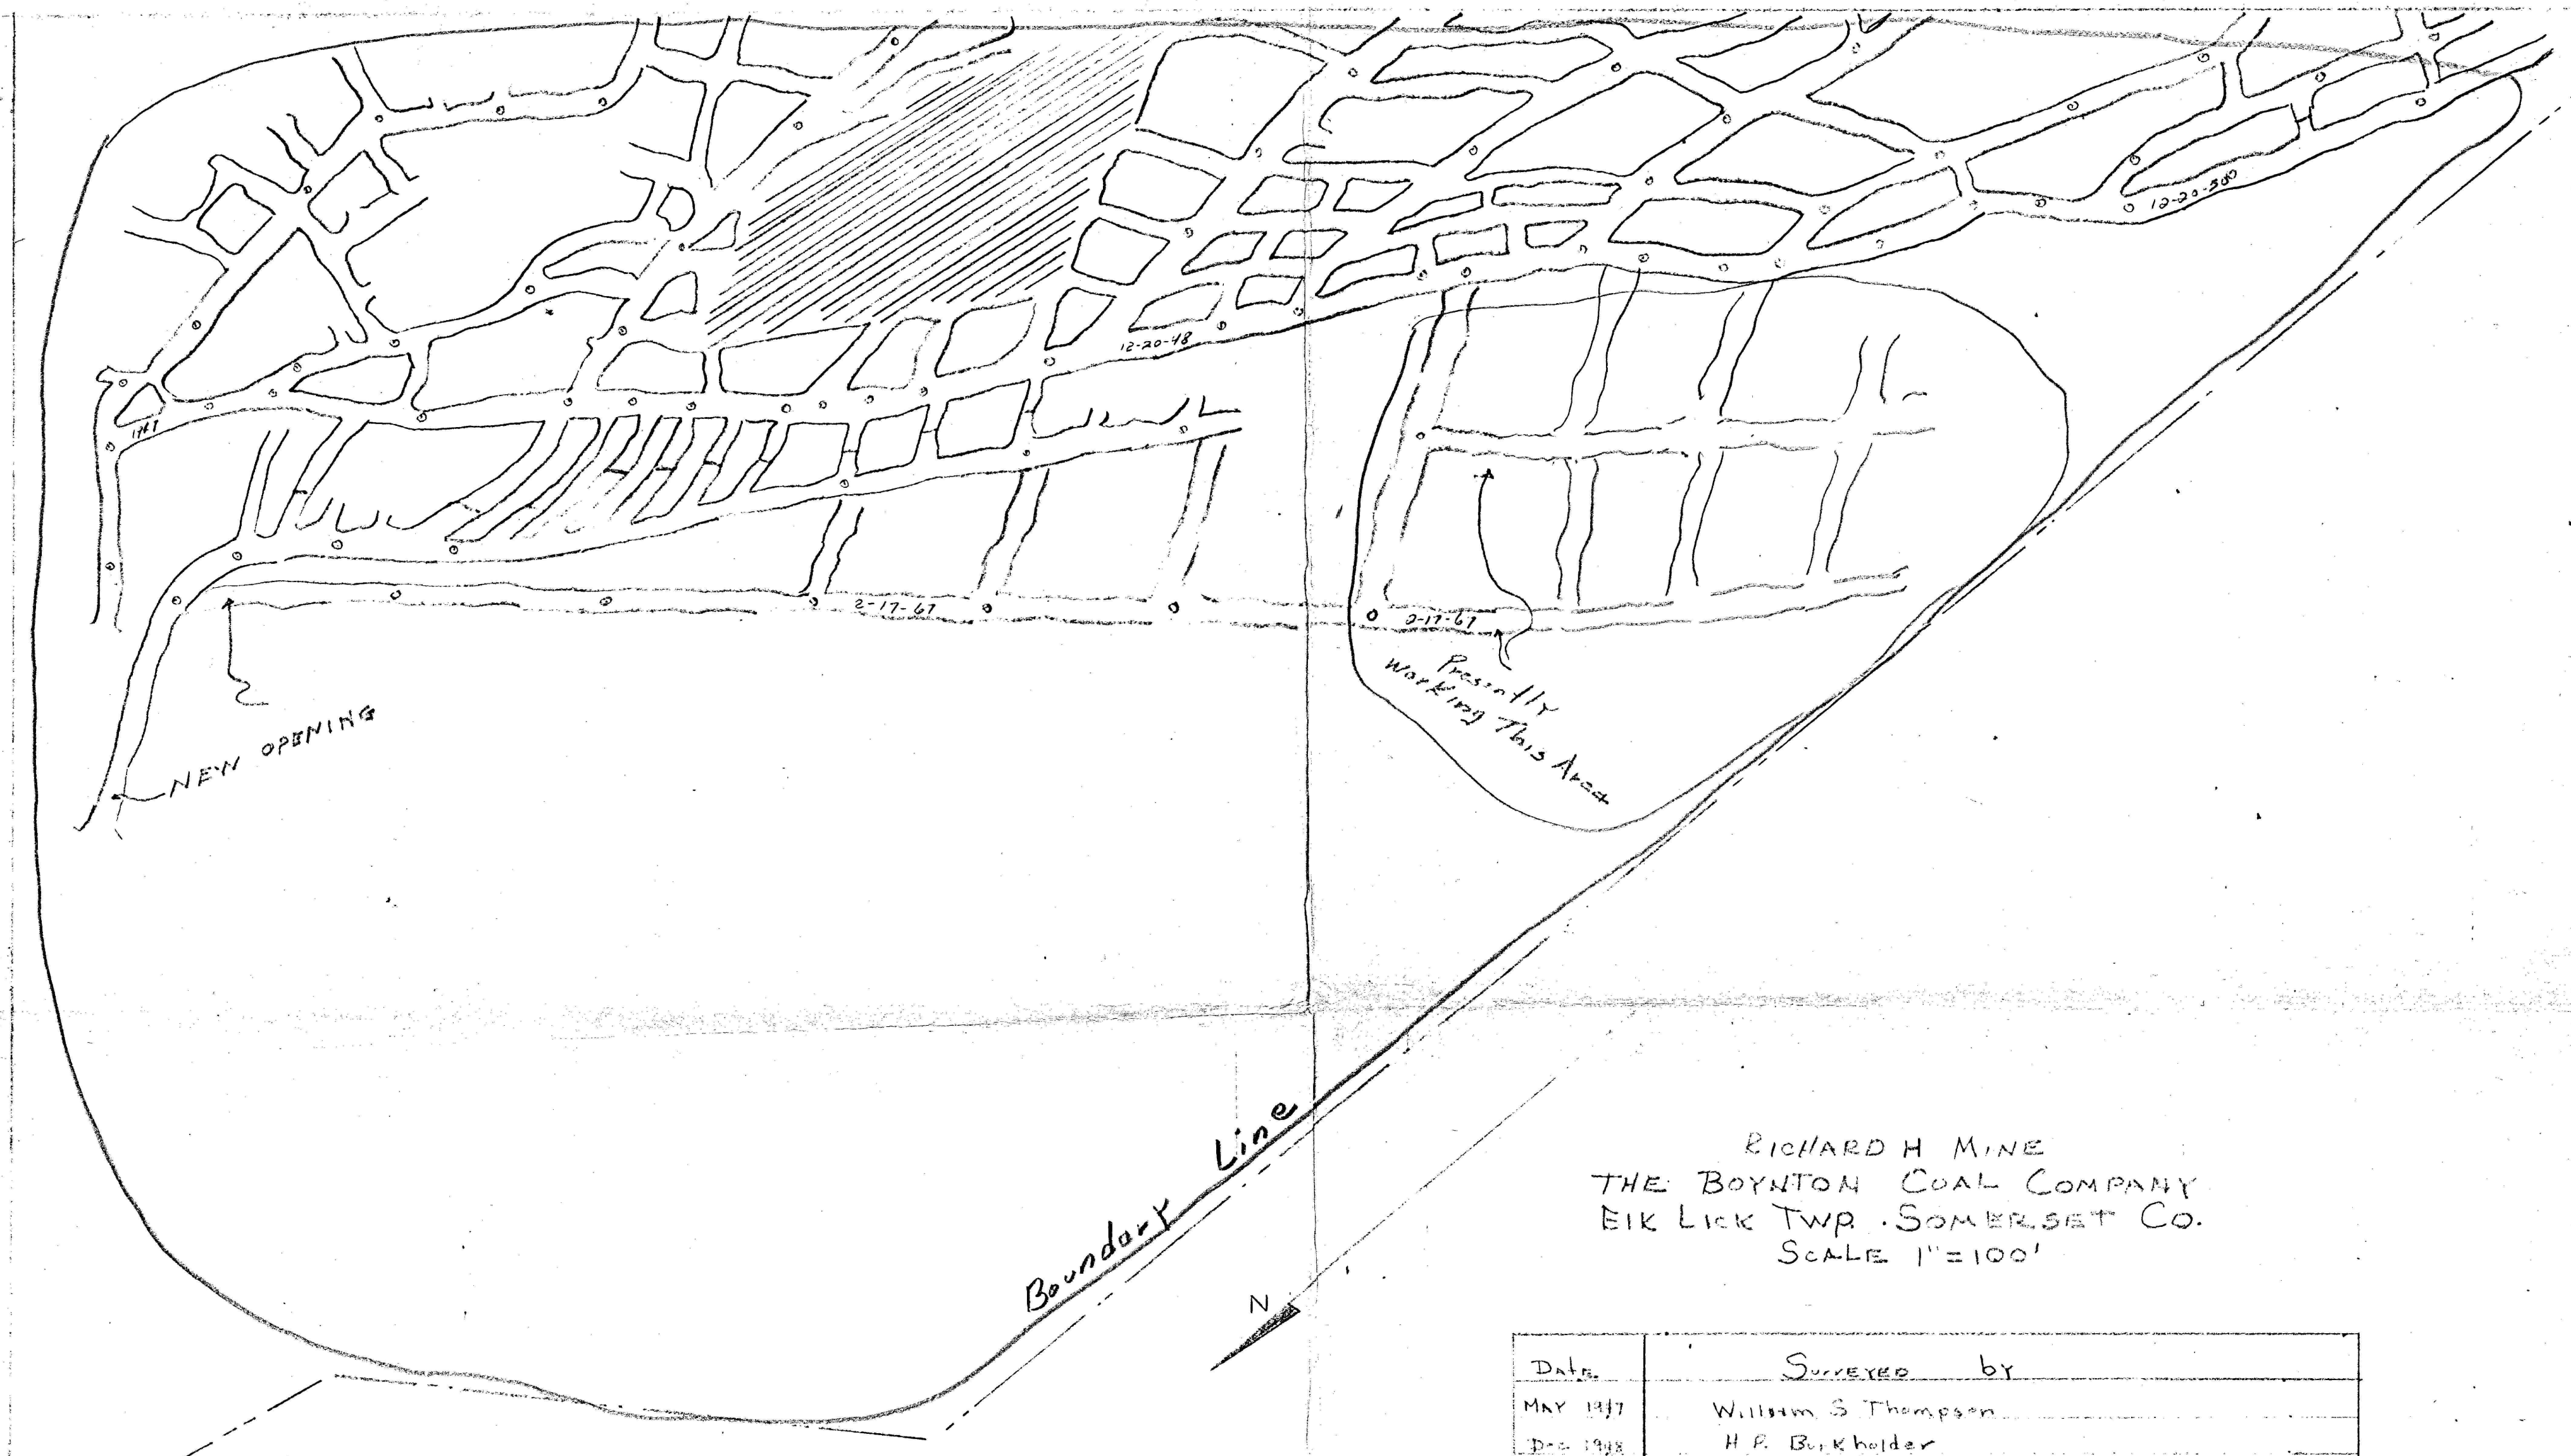

RICHARD H MINE
 THE BOYNTON COAL COMPANY
 Elk Lick Twp. Somerset Co.
 Scale 1"=100'

Date	Surveyed by
MAY 1947	William S Thompson
Dec 1948	H P Burkholder
Sept 1951	Wayne Sider
1953	H P Burkholder
July 1954	H P Burkholder
MAY 1956	H P Burkholder
Feb 1957	E A Bowman

FOR PERMIT COVERAGE
 COAL TO BE MINED
 2/17/67 to 8/12/67

Eugene Albert Bowman

#2305
 1-6-8000
 C.C.