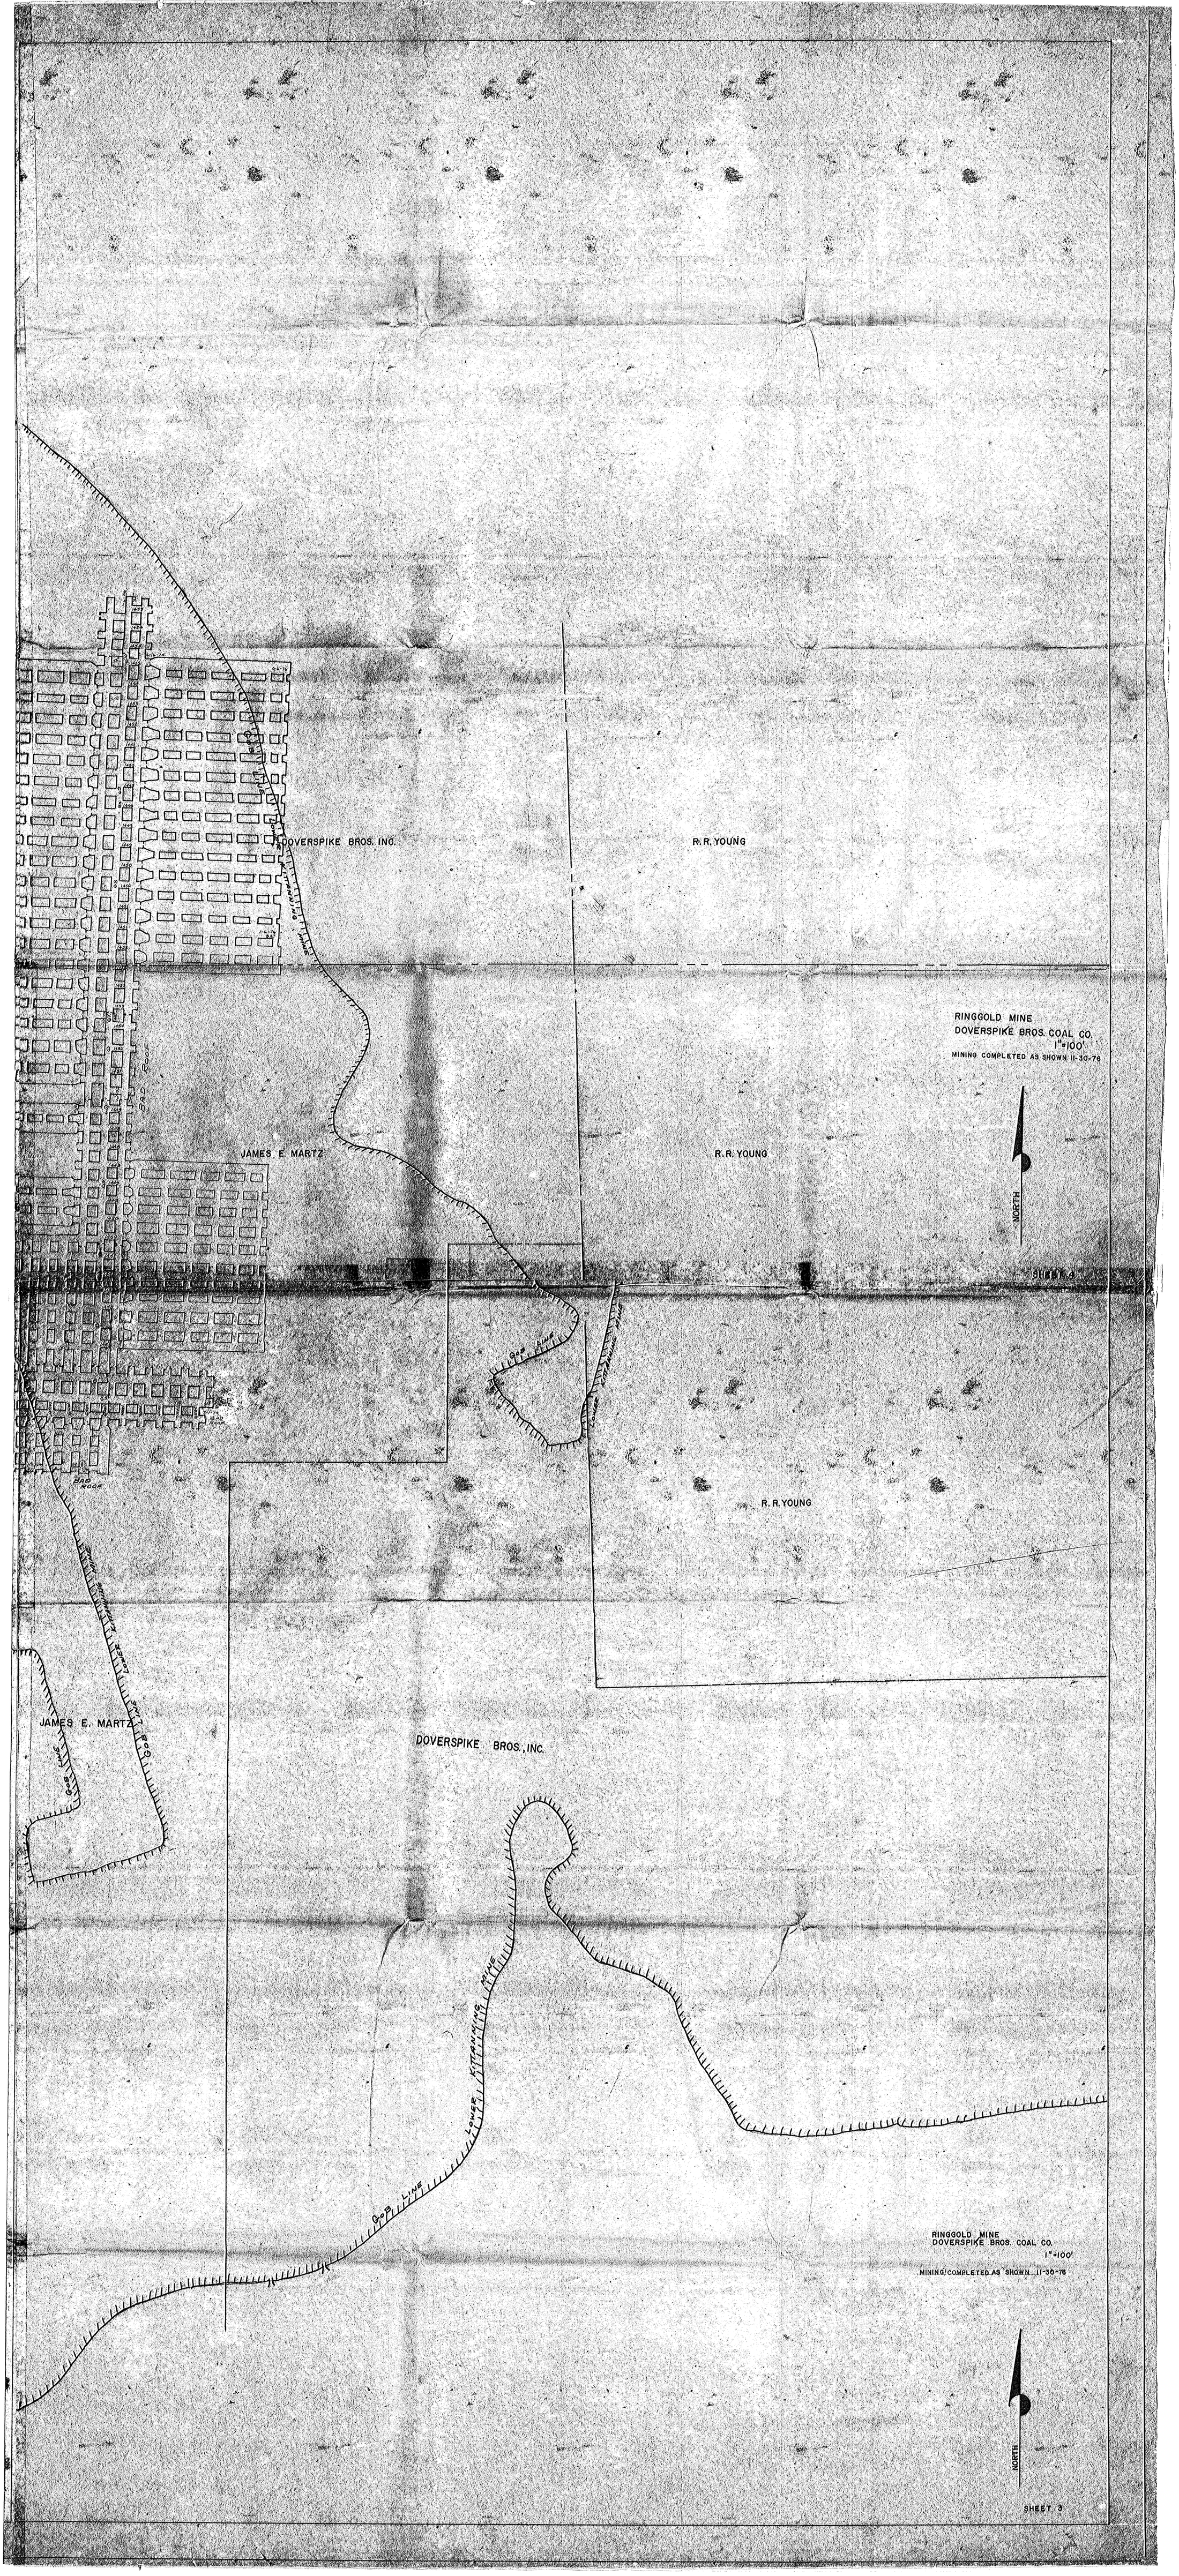

DOVERSPIKE BROS. INC.
R. R. YOUNG
RINGGOLD MINE
DOVERSPIKE BROS. COAL CO.
1"=100'
MINING COMPLETED AS SHOWN 11-30-78
NORTH
JAMES E. MARTZ
R. R. YOUNG
SHEET 2
R. R. YOUNG
JAMES E. MARTZ
DOVERSPIKE BROS., INC.
RINGGOLD MINE
DOVERSPIKE BROS. COAL CO.
1"=100'
MINING COMPLETED AS SHOWN 11-30-78
NORTH
SHEET 3