


5TH PROTECTION
OFFICE COPY

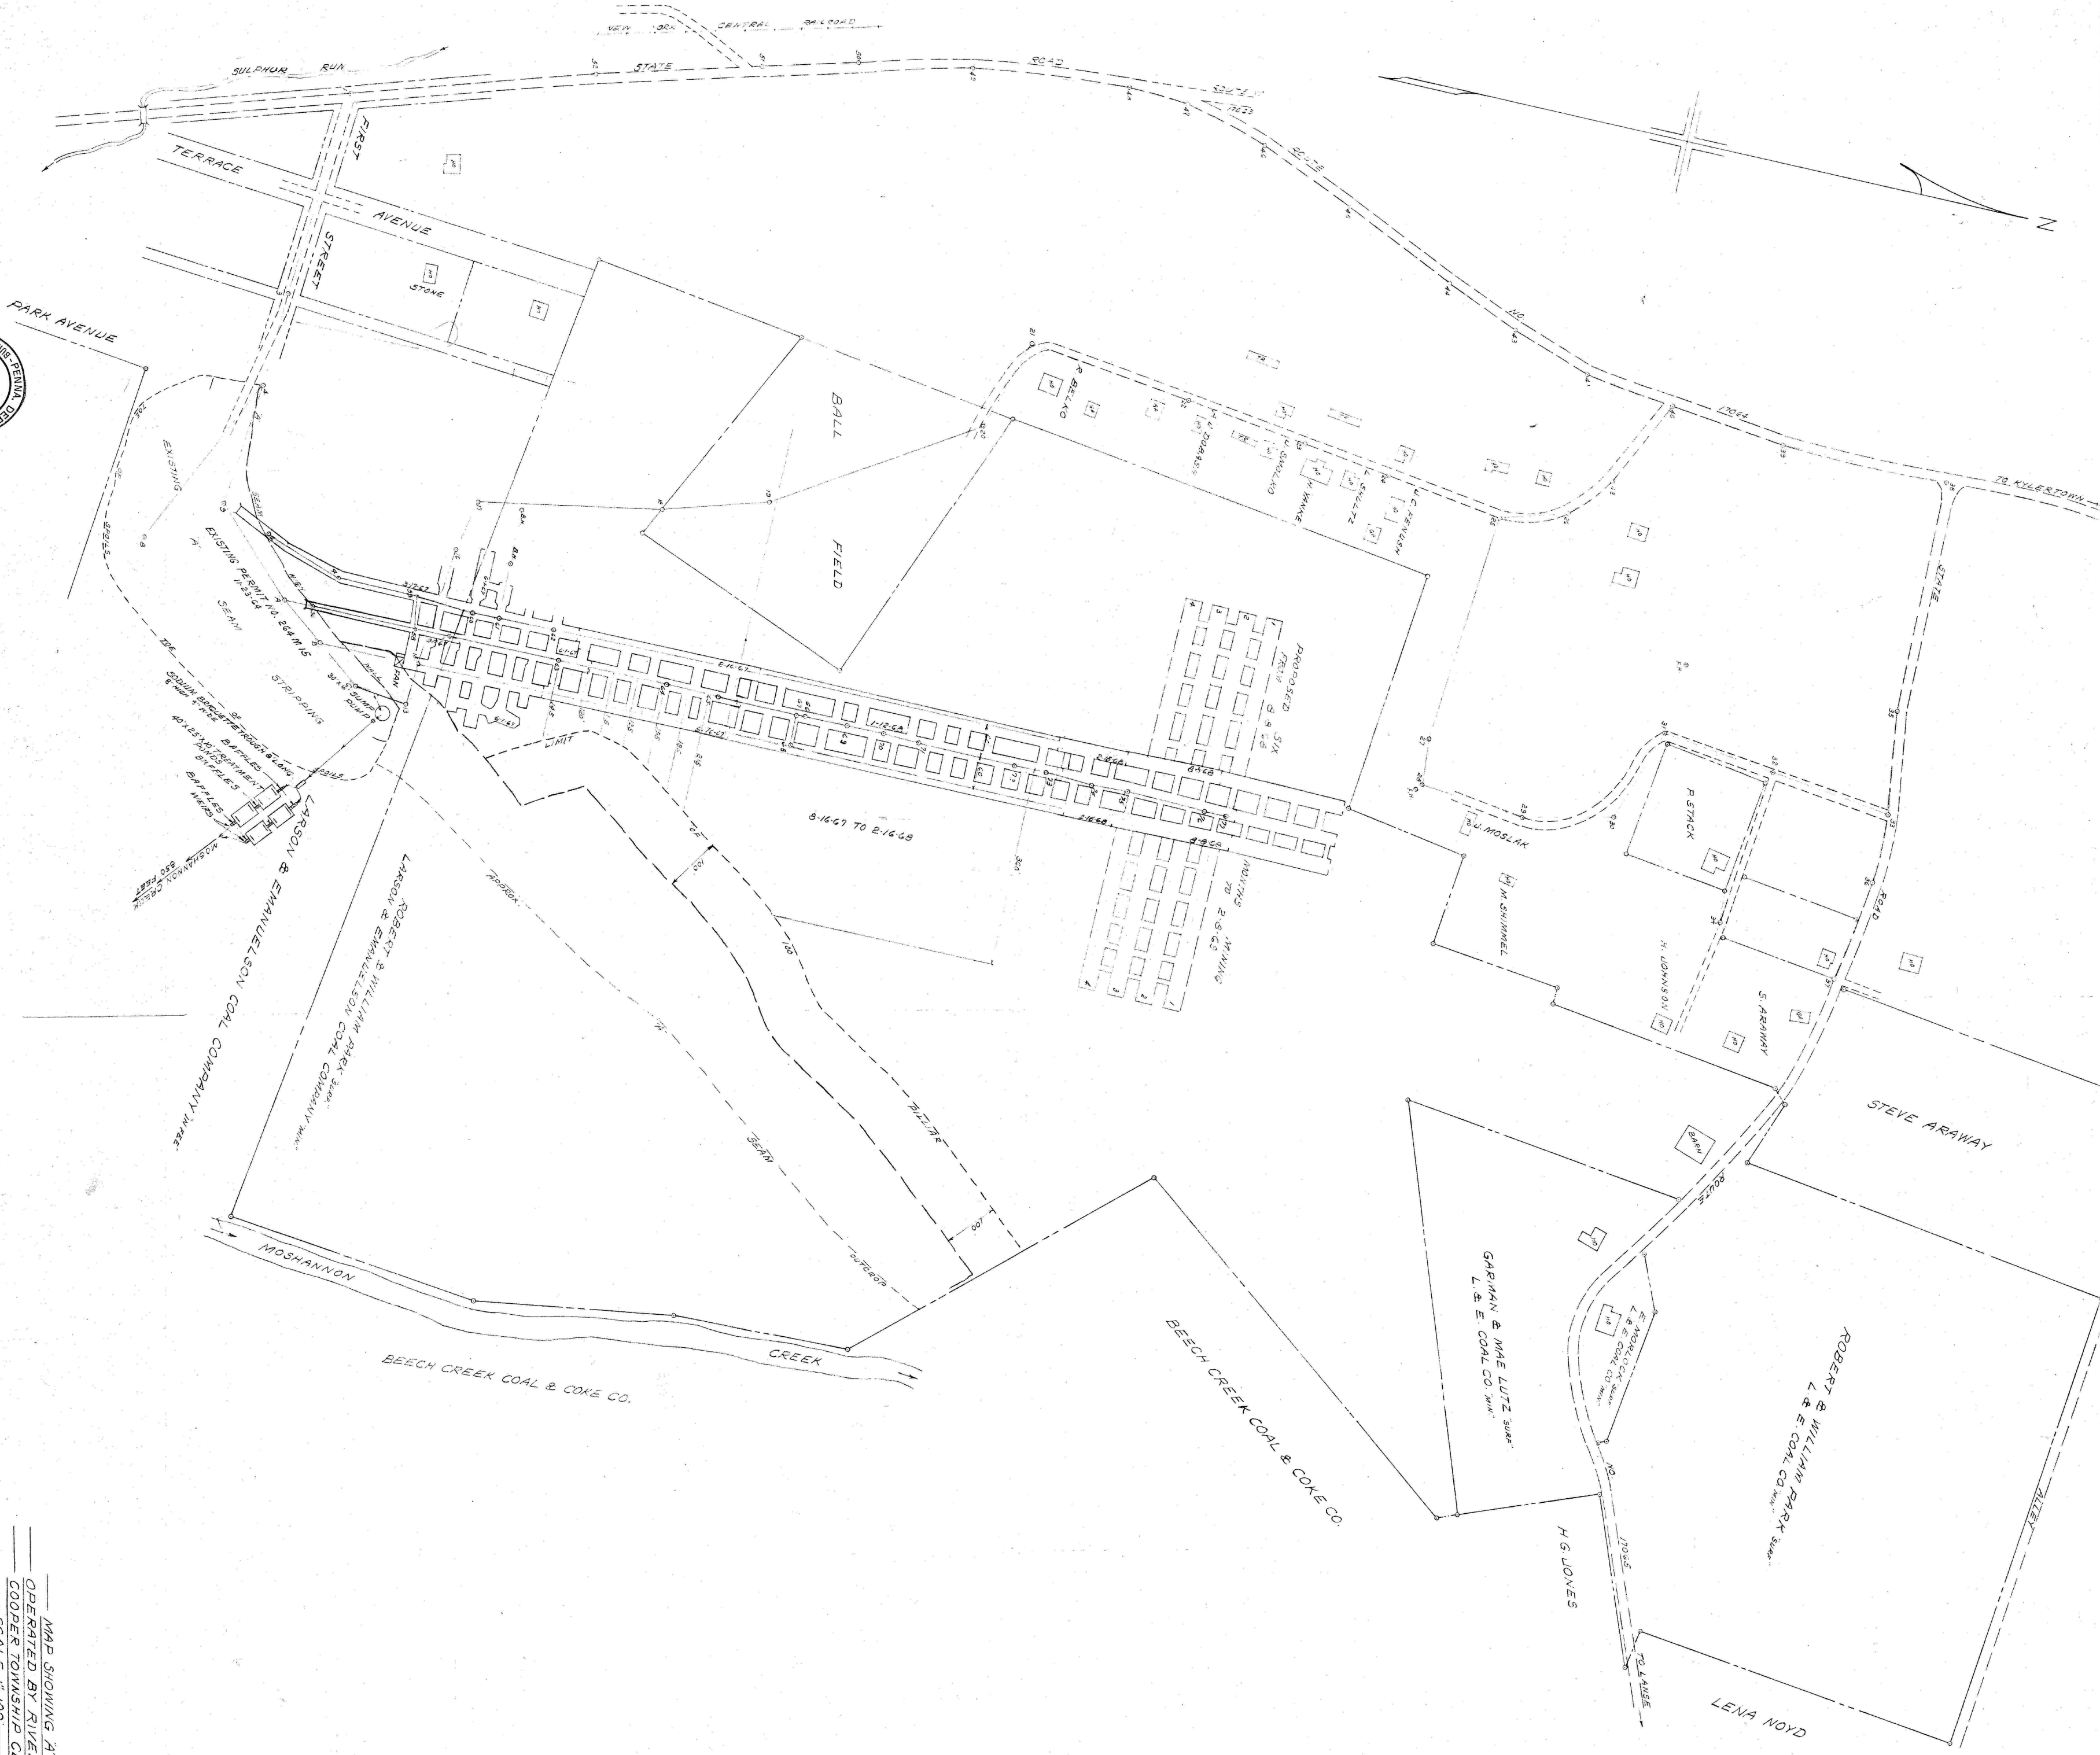

MAP SHOWING A SEAM DEEP MINE NO. 3
OPERATED BY RIVERHILL COAL COMPANY INC.
COOPER TOWNSHIP CLEARFIELD COUNTY PENNA.
SCALE 1/2" = 100'
BERNARD LUCAS ASSOCIATES
JULY 7, 1966

