


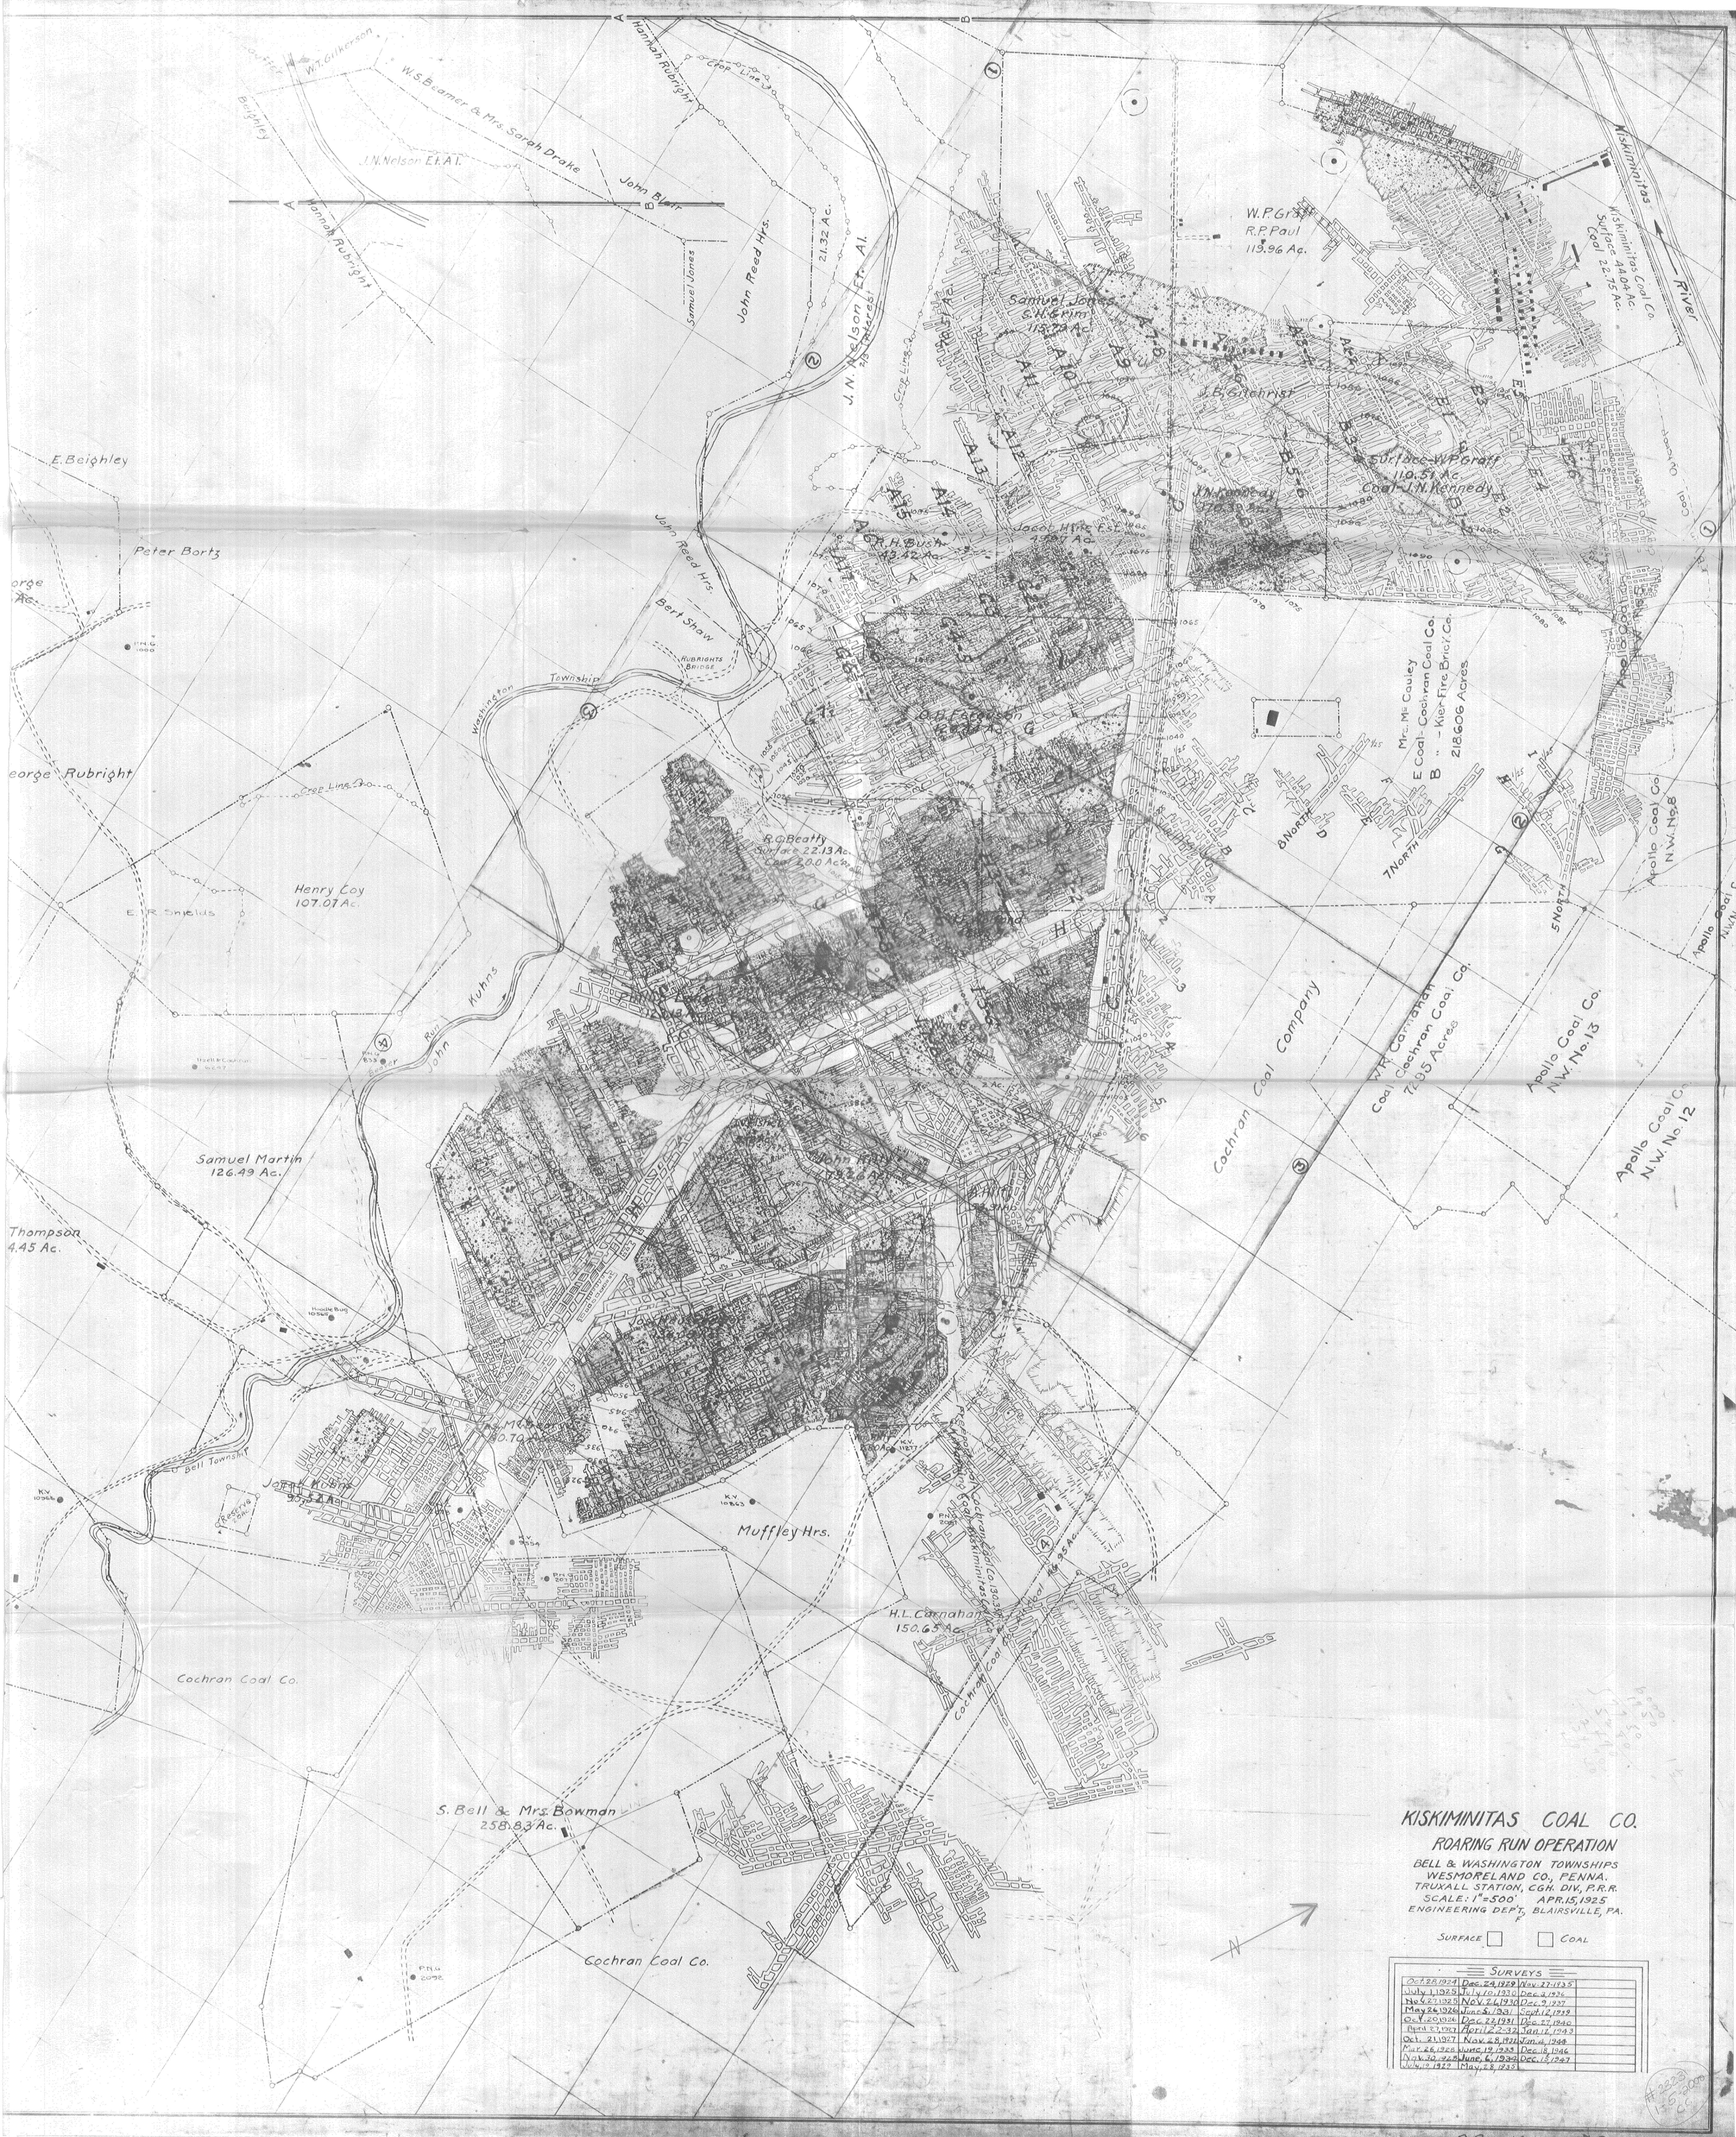

KISKIMINITAS COAL CO.

ROARING RUN OPERATION

BELL & WASHINGTON TOWNSHIPS
WESMORELAND CO., PENNA.
TRUXALL STATION, CGH. DIV., P.R.R.
SCALE: 1"=500' APR 15, 1925
ENGINEERING DEPT., BLAIRSVILLE, PA.

SURFACE ☐ COAL ☐

SURVEYS			
2-122-1924	Dec. 24, 1924	Nov. 27, 1925	
July 1, 1925	July 1, 1925	Dec. 2, 1925	
Nov. 2, 1925	Nov. 2, 1925	Dec. 2, 1925	
May 26, 1926	June 4, 1926	Sept. 12, 1926	
Oct. 1, 1926	Dec. 2, 1926	Jan. 27, 1927	
April 2, 1927	April 2, 1927	Jan. 12, 1927	
Oct. 21, 1927	Nov. 28, 1927	Jan. 12, 1928	
Nov. 28, 1928	Nov. 28, 1928	Dec. 18, 1928	
Nov. 30, 1928	Nov. 30, 1928	Dec. 18, 1928	
Nov. 30, 1928	Nov. 30, 1928	Dec. 18, 1928	
Nov. 30, 1928	Nov. 30, 1928	Dec. 18, 1928	

175' 30" 60'