


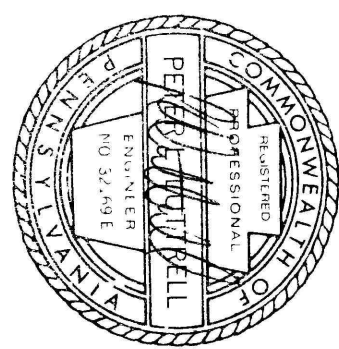

CONSOL
Consolidation Coal Company
Eastern Region Office
Washington, Pennsylvania 15301
(412) 462-3000

The following mine openings were sealed by Consolidation Coal Company in January 1984:

Colvin Shaft
Robena Slope Shaft
Willow Slope Shaft
Meadow Run Shaft
Bailey Shaft
Garards Fort Shaft
Long Shaft
Robena Slope

In addition to the listed shafts and slope approximately seventy (70) boreholes were sealed.
Kirby Shaft, Frosty Run Shaft, Blaker Shaft, and Bowlin Shaft were sealed by United States Steel prior to January 1, 1984.



ROBENA MINE - FINAL MAP
SCALE 1" = 500'
APRIL 1984

4-23-84
1-12-2006
C.C.

