
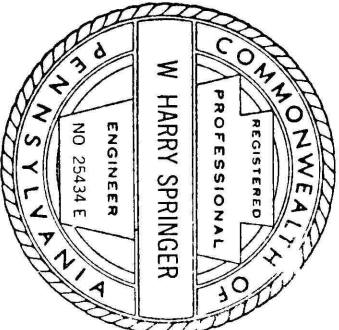


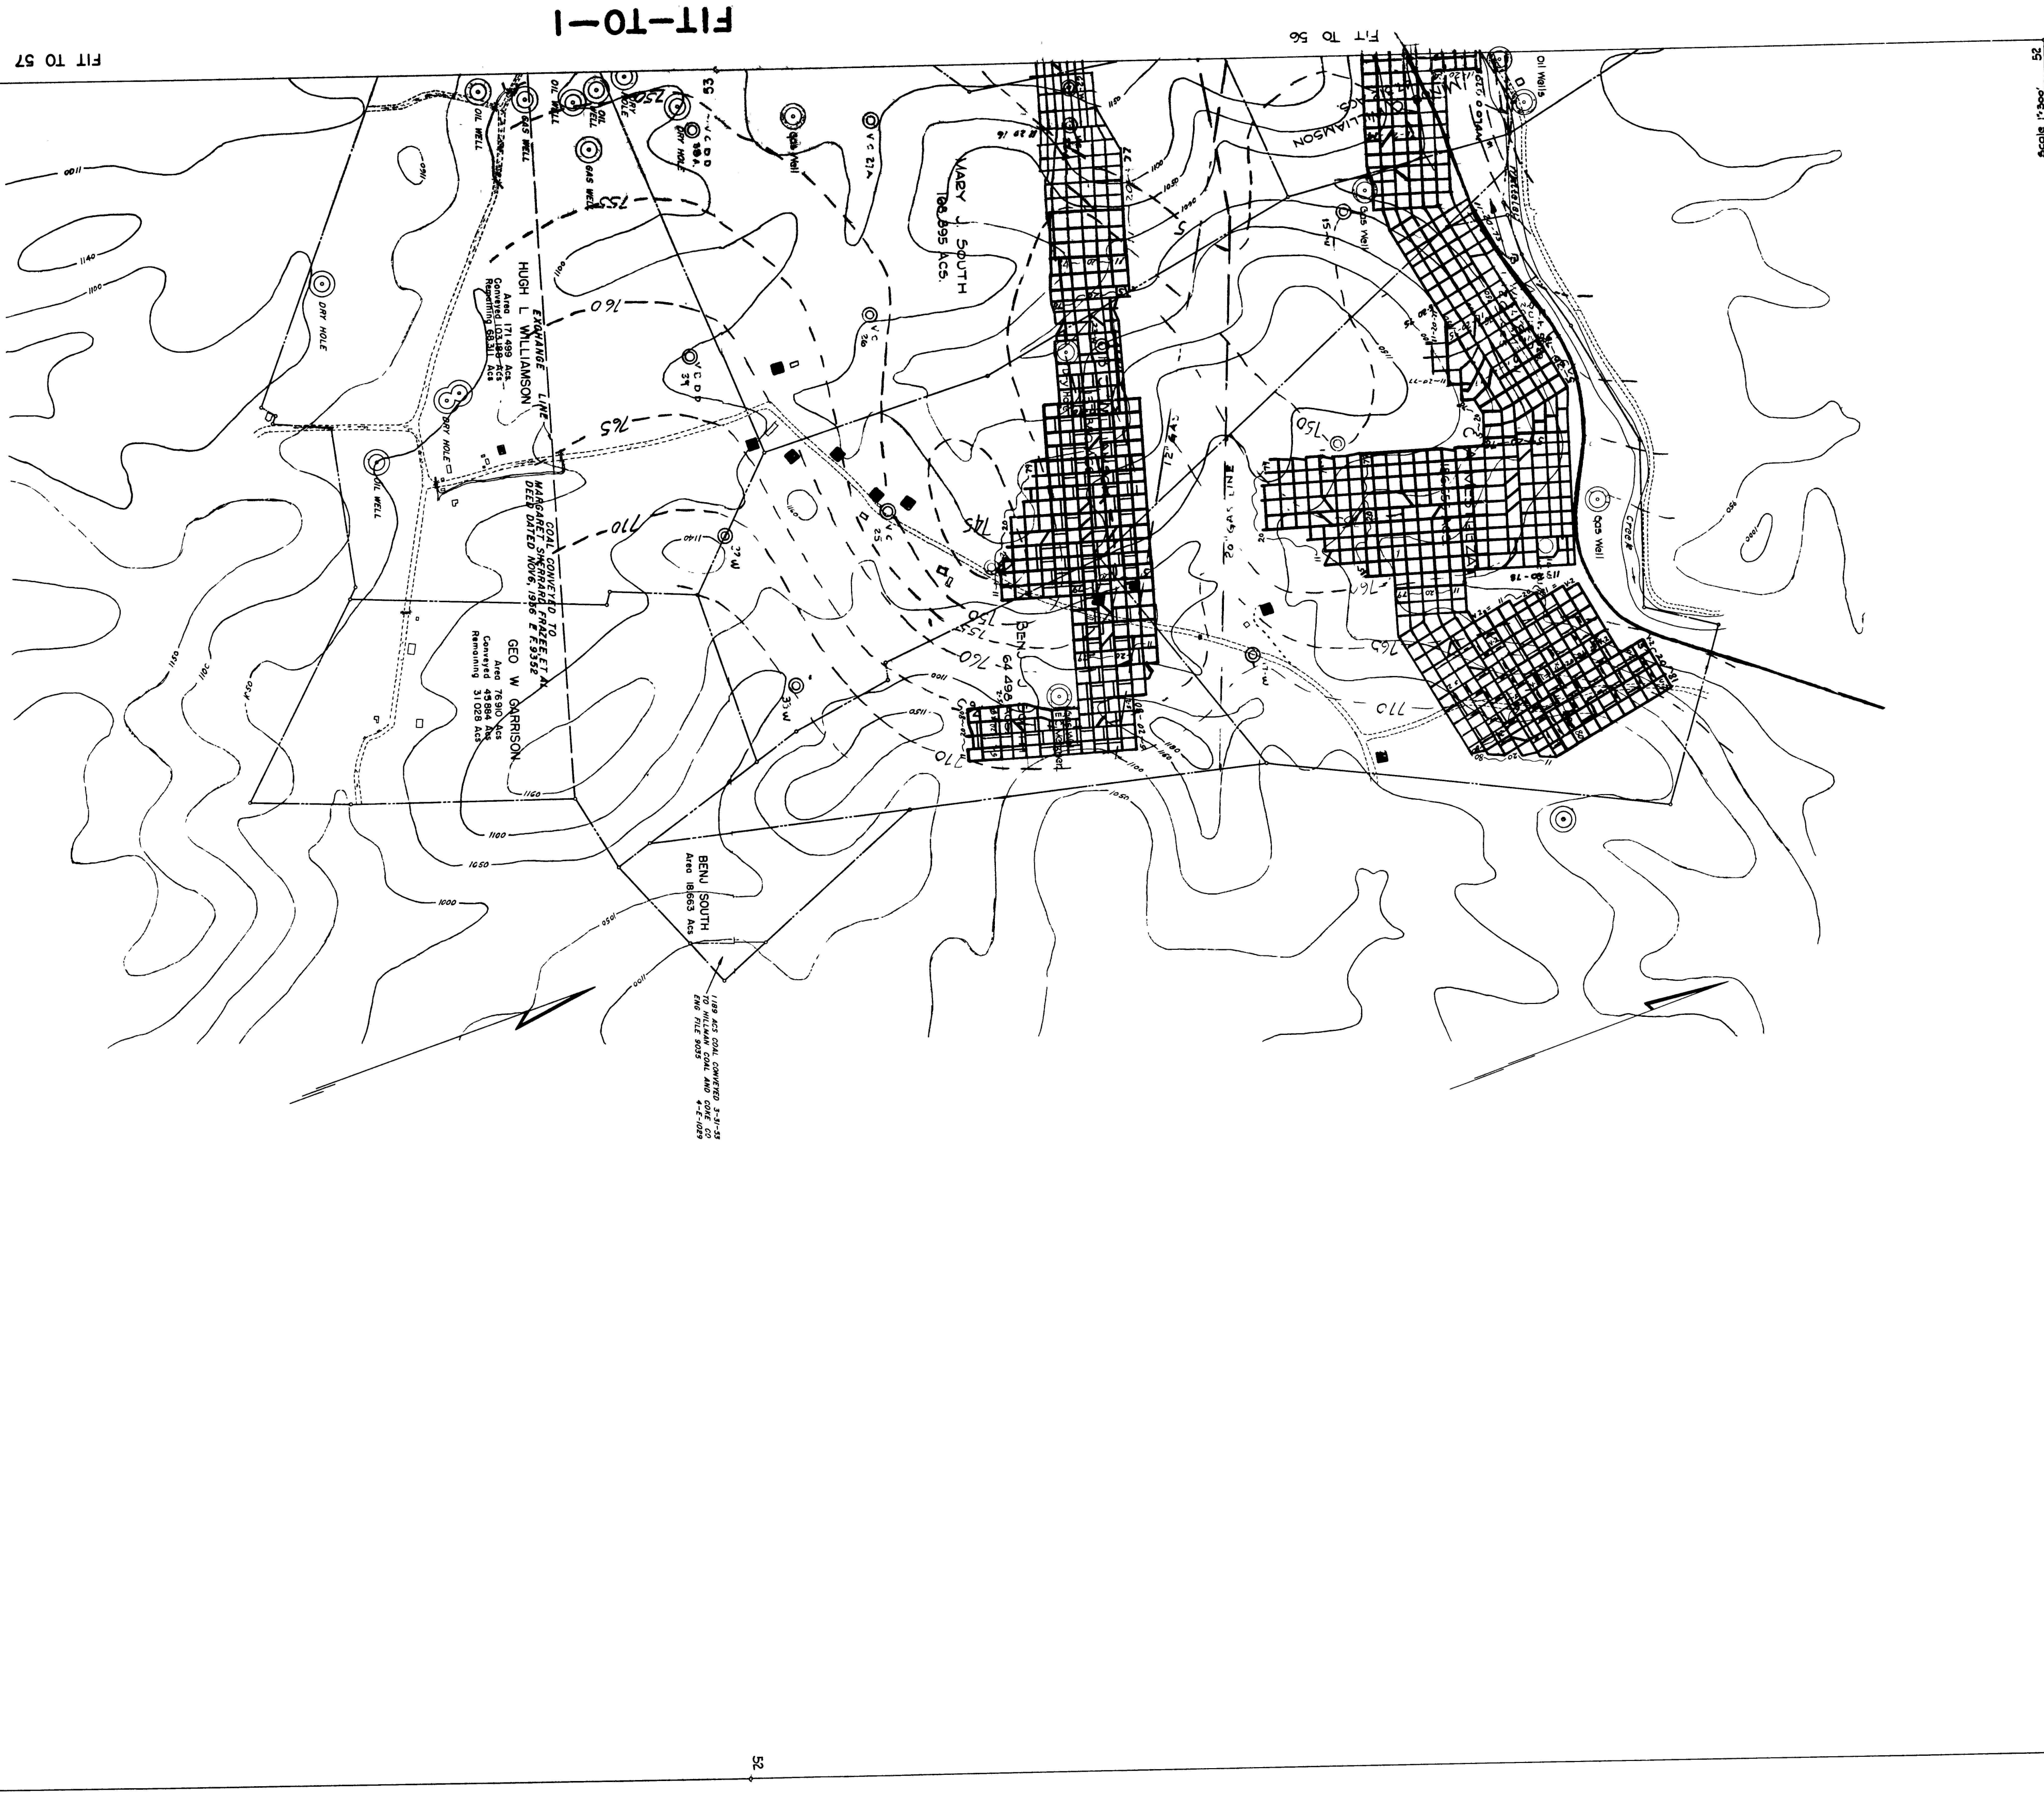

W. Harry Springer
4-24-84