



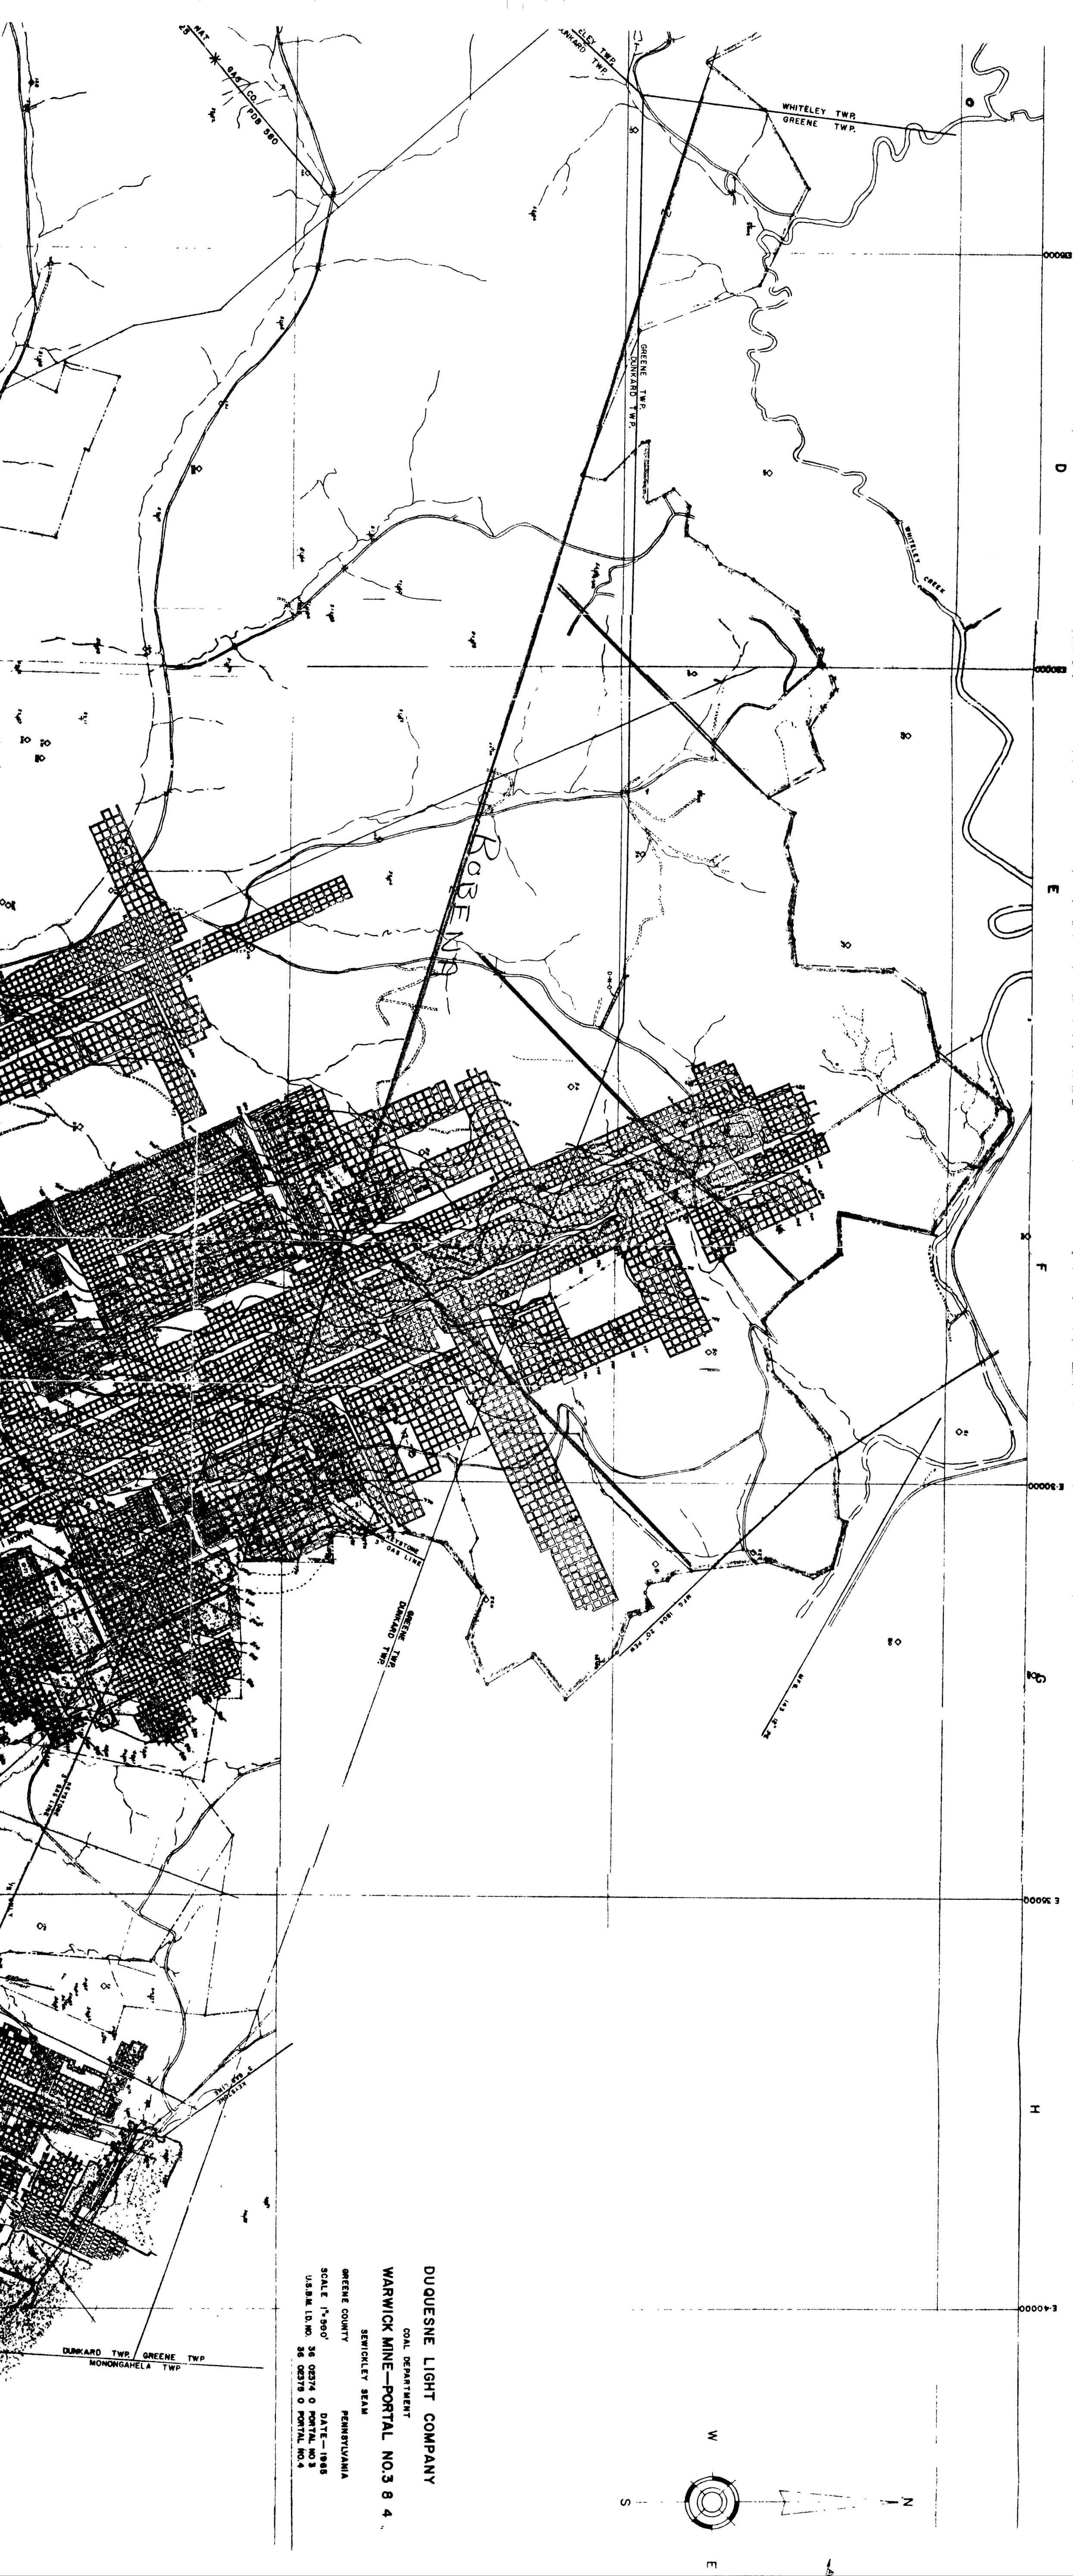

DUQUESNE LIGHT COMPANY
COAL DEPARTMENT
WARWICK MINE—PORTAL NO. 3 8 4

GREENE COUNTY PENNSYLVANIA
SEWICKLEY SEAM
SCALE 1"=500'
U.S.M. ID. NO. 36 02374 0 PORTAL NO. 3
26 02375 0 PORTAL NO. 4
DATE—1965

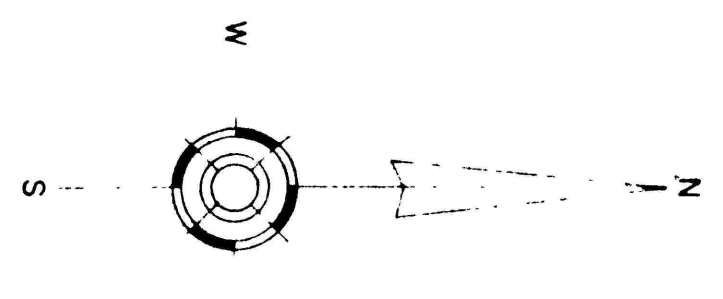

DUNKARD TWP. GREENE TWP.
MONONGAHELA TWP.