


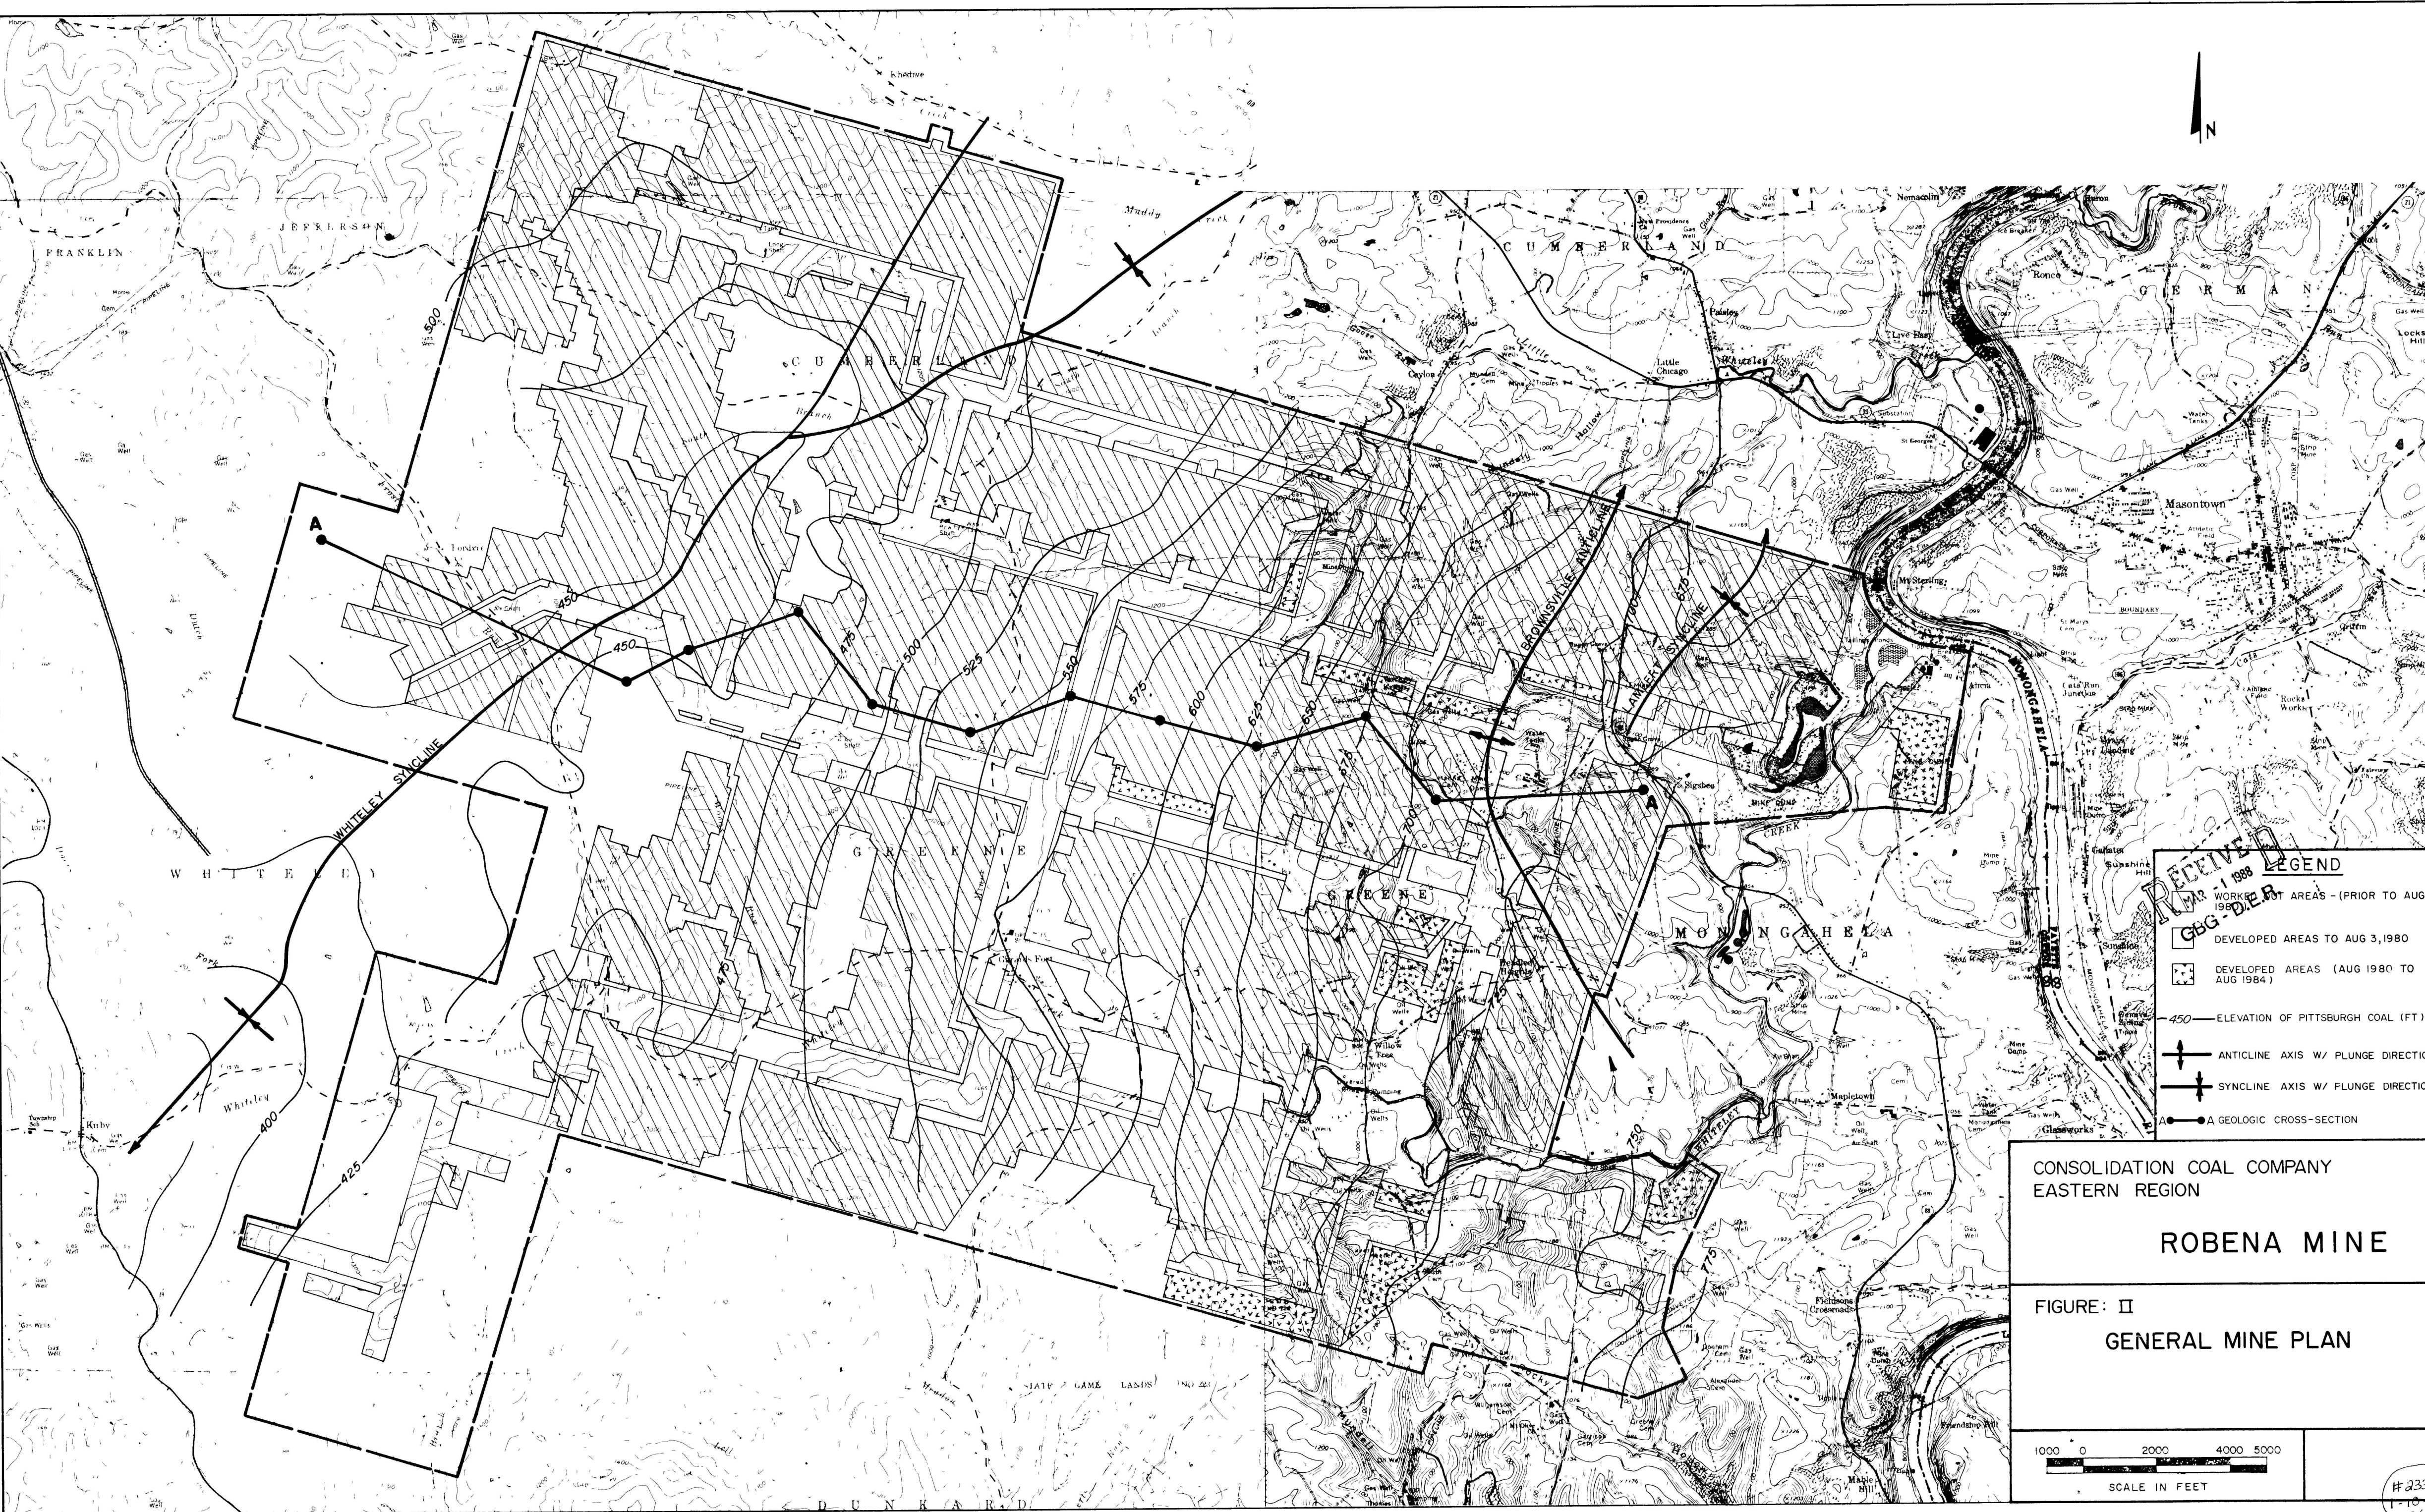

RECEIVED
MAR 1 1988
WORKS
1988
GBG-D-18

LEGEND

DEVELOPED AREAS - (PRIOR TO AUG 3, 1980)

DEVELOPED AREAS TO AUG 3, 1980

DEVELOPED AREAS (AUG 1980 TO AUG 1984)

450 — ELEVATION OF PITTSBURGH COAL (FT.)

ANTICLINE AXIS W/ PLUNGE DIRECTION

SYNCLINE AXIS W/ PLUNGE DIRECTION

A — A GEOLOGIC CROSS-SECTION

CONSOLIDATION COAL COMPANY
EASTERN REGION

ROBENA MINE

FIGURE: II
GENERAL MINE PLAN

1000 0 2000 4000 5000

SCALE IN FEET

#2331
1-10-88
CC