


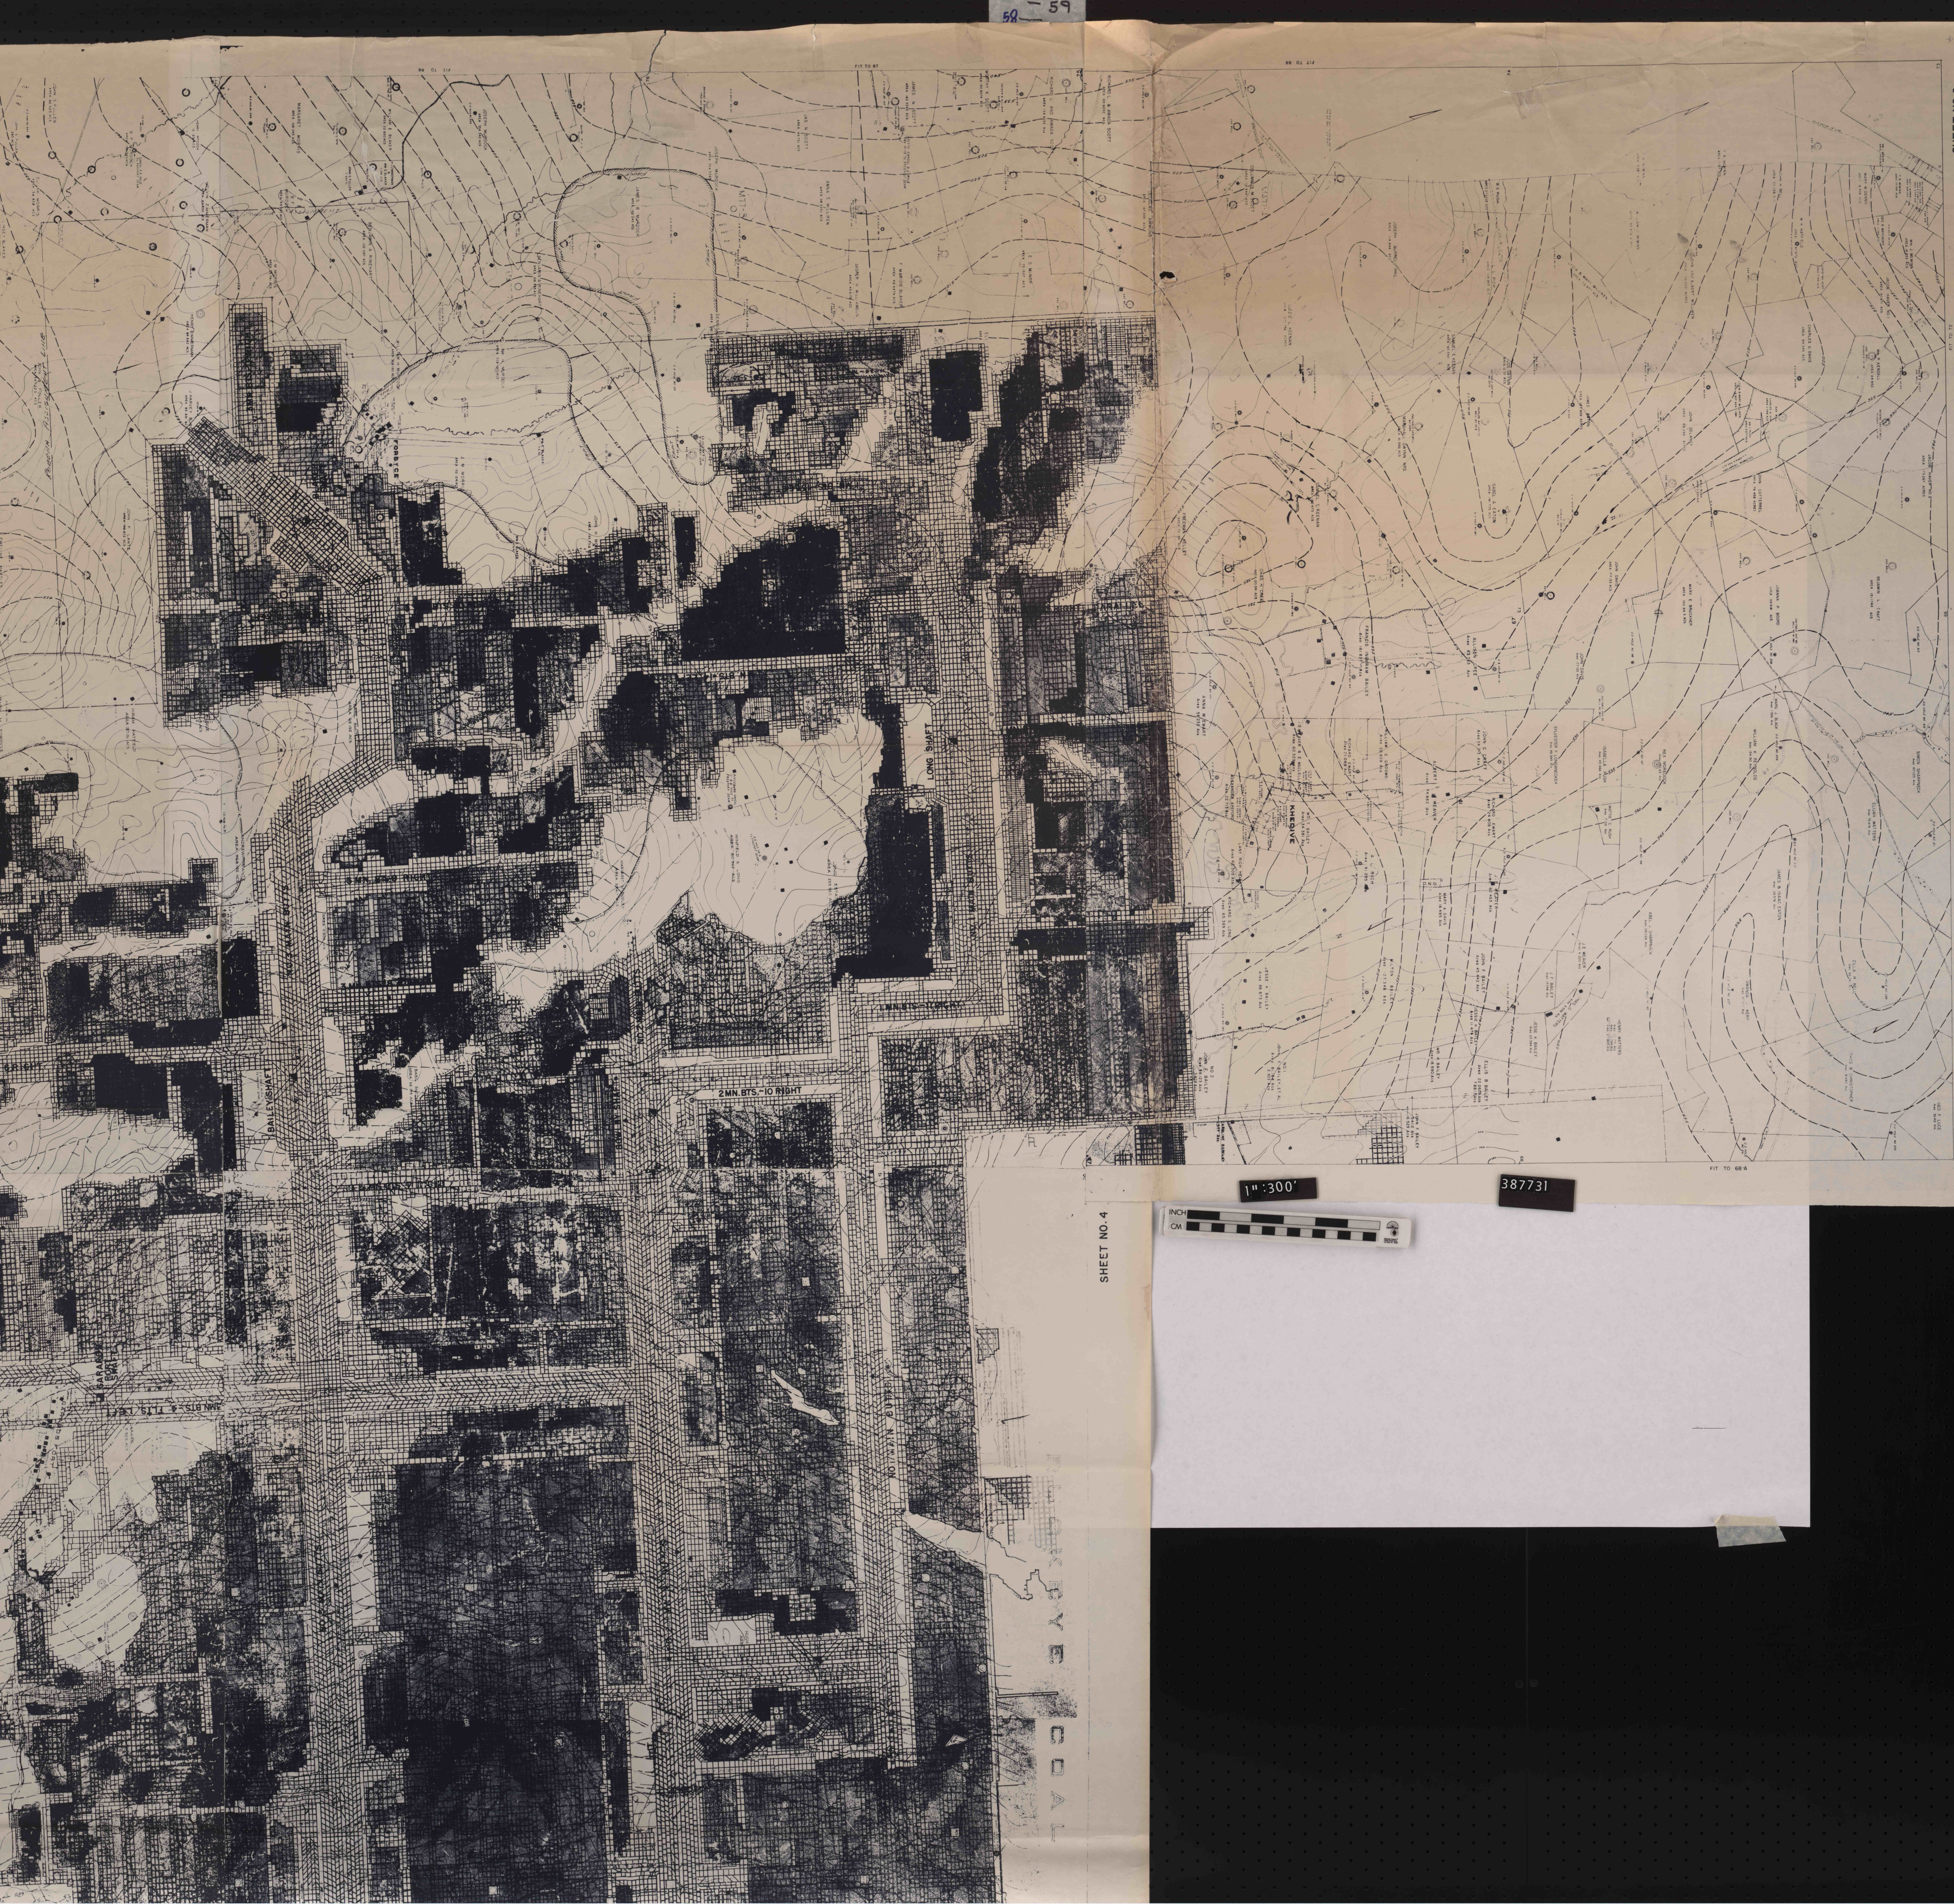

SHEET NO. 6

SHEET NO. 4



387731

62
111
61 63