


FIT TO 67

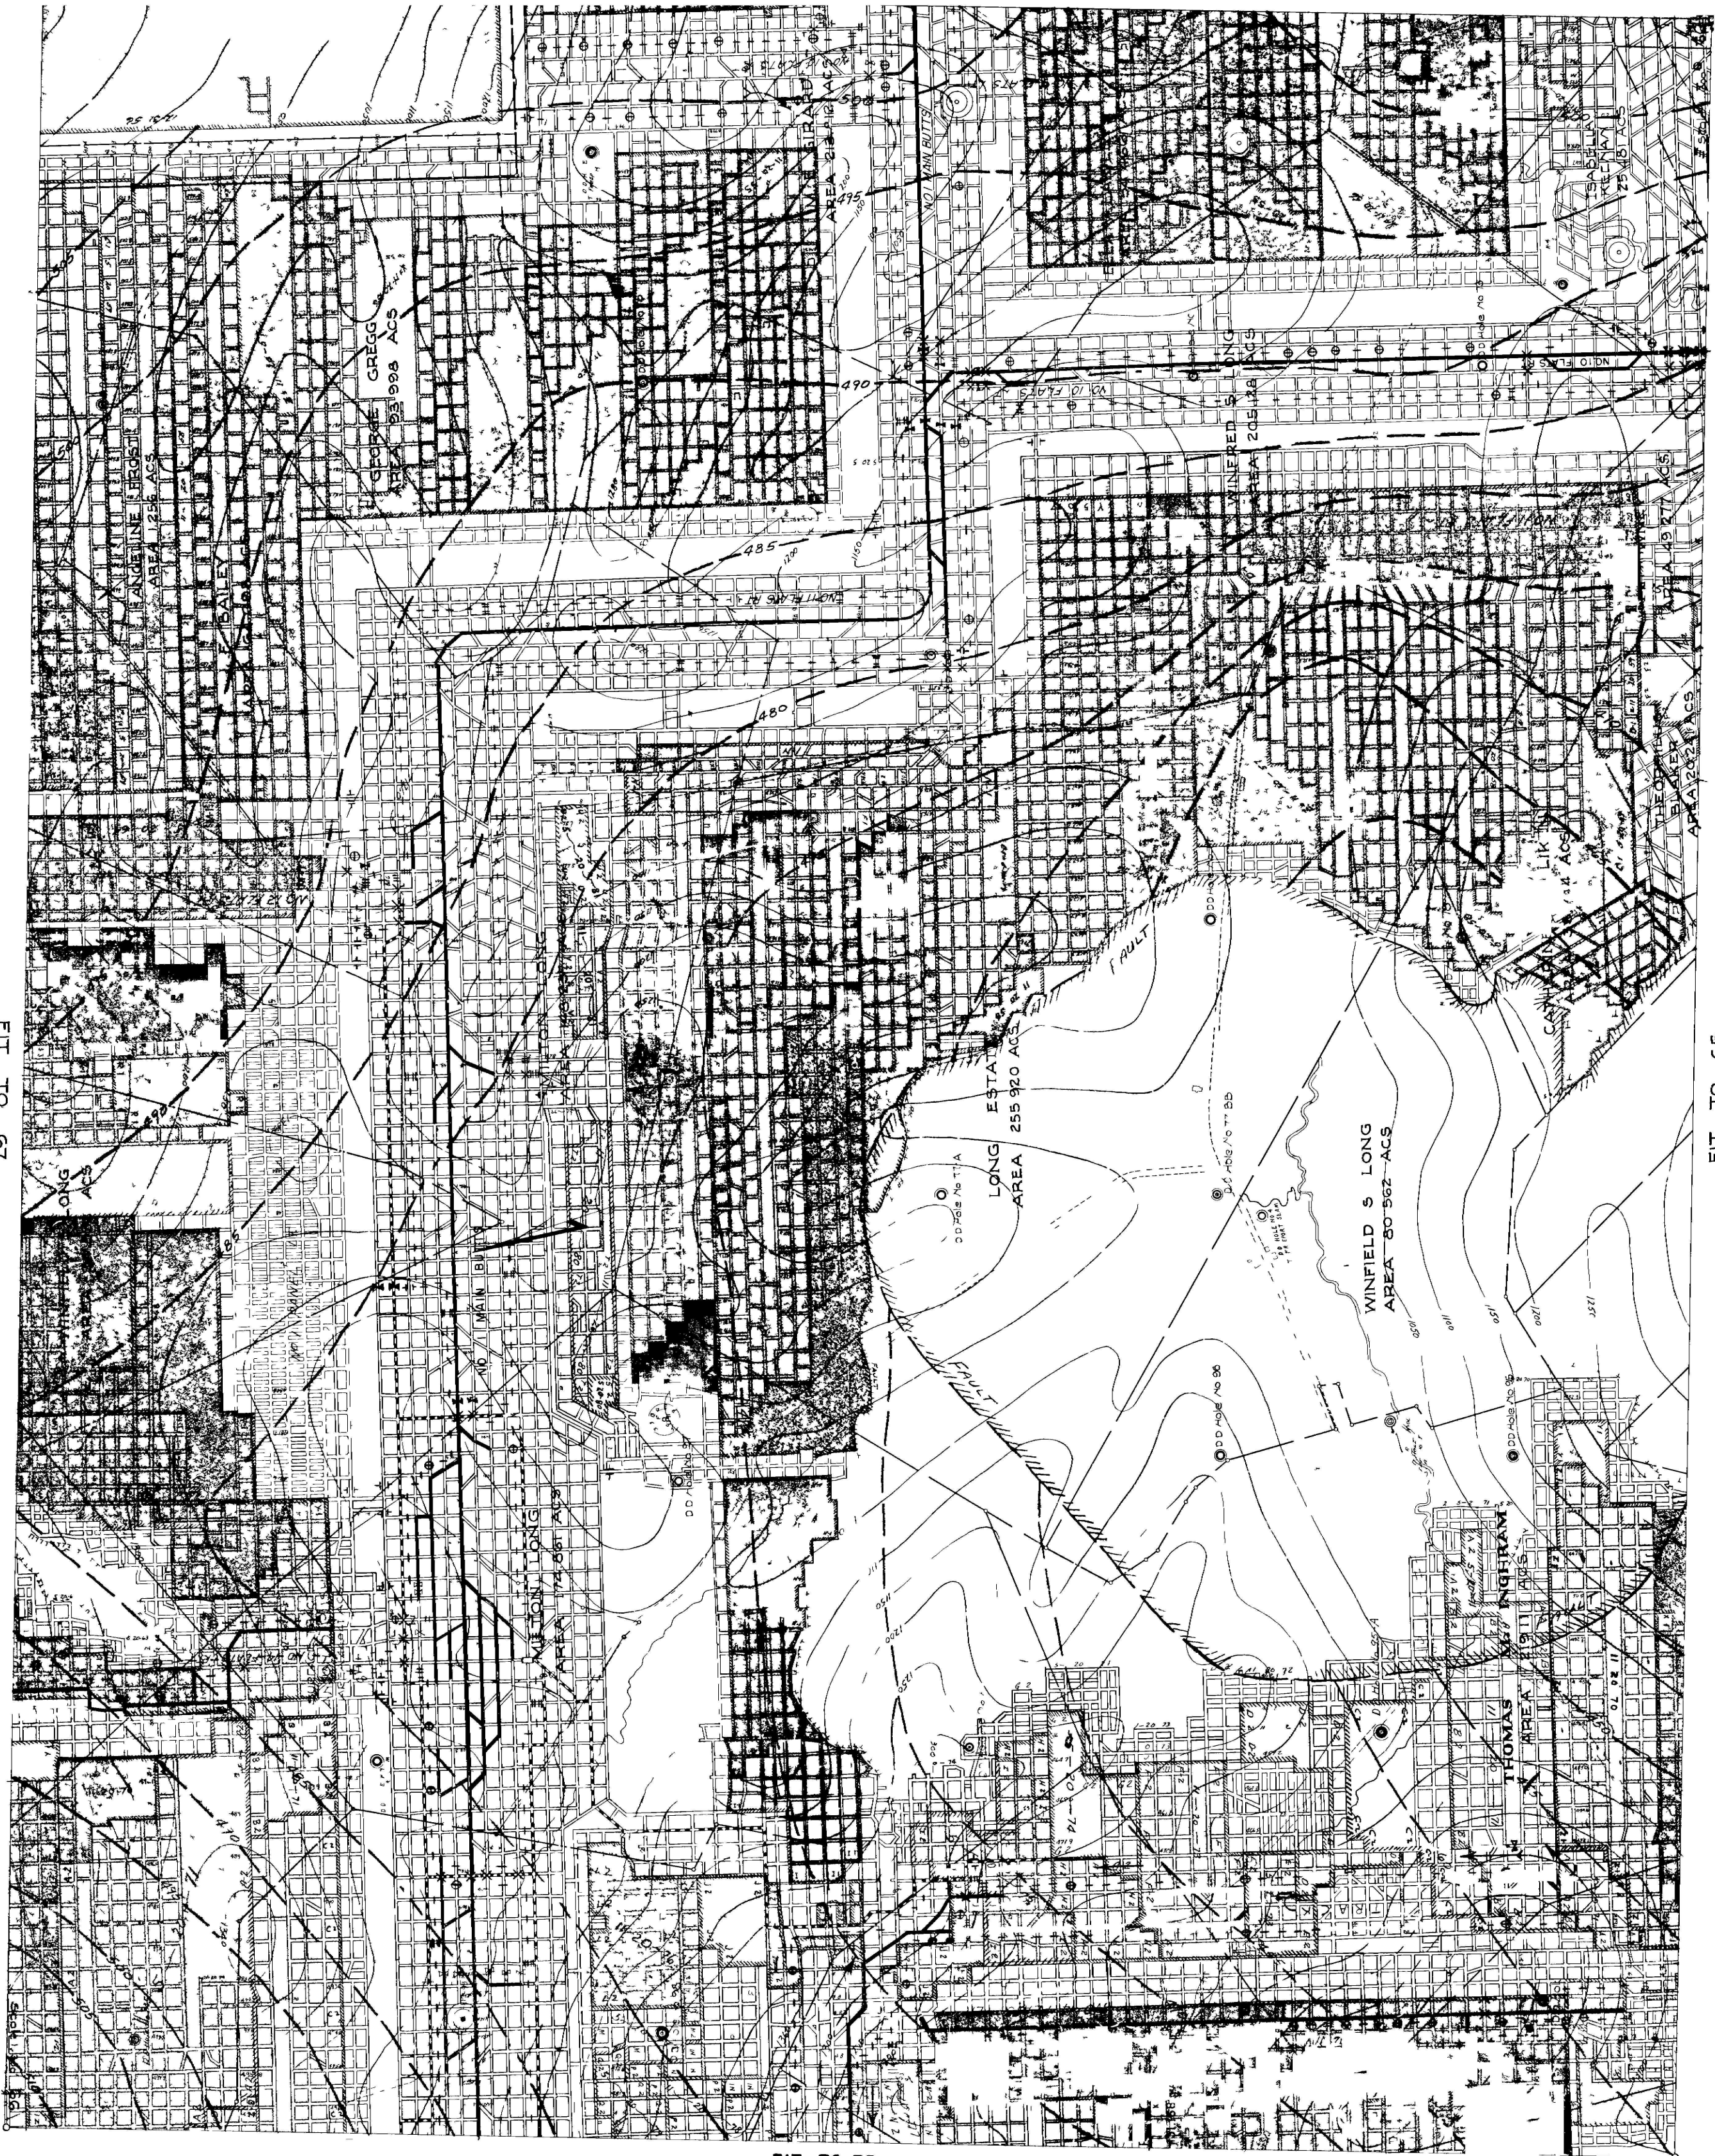

FIT TO 75

FIT TO 65