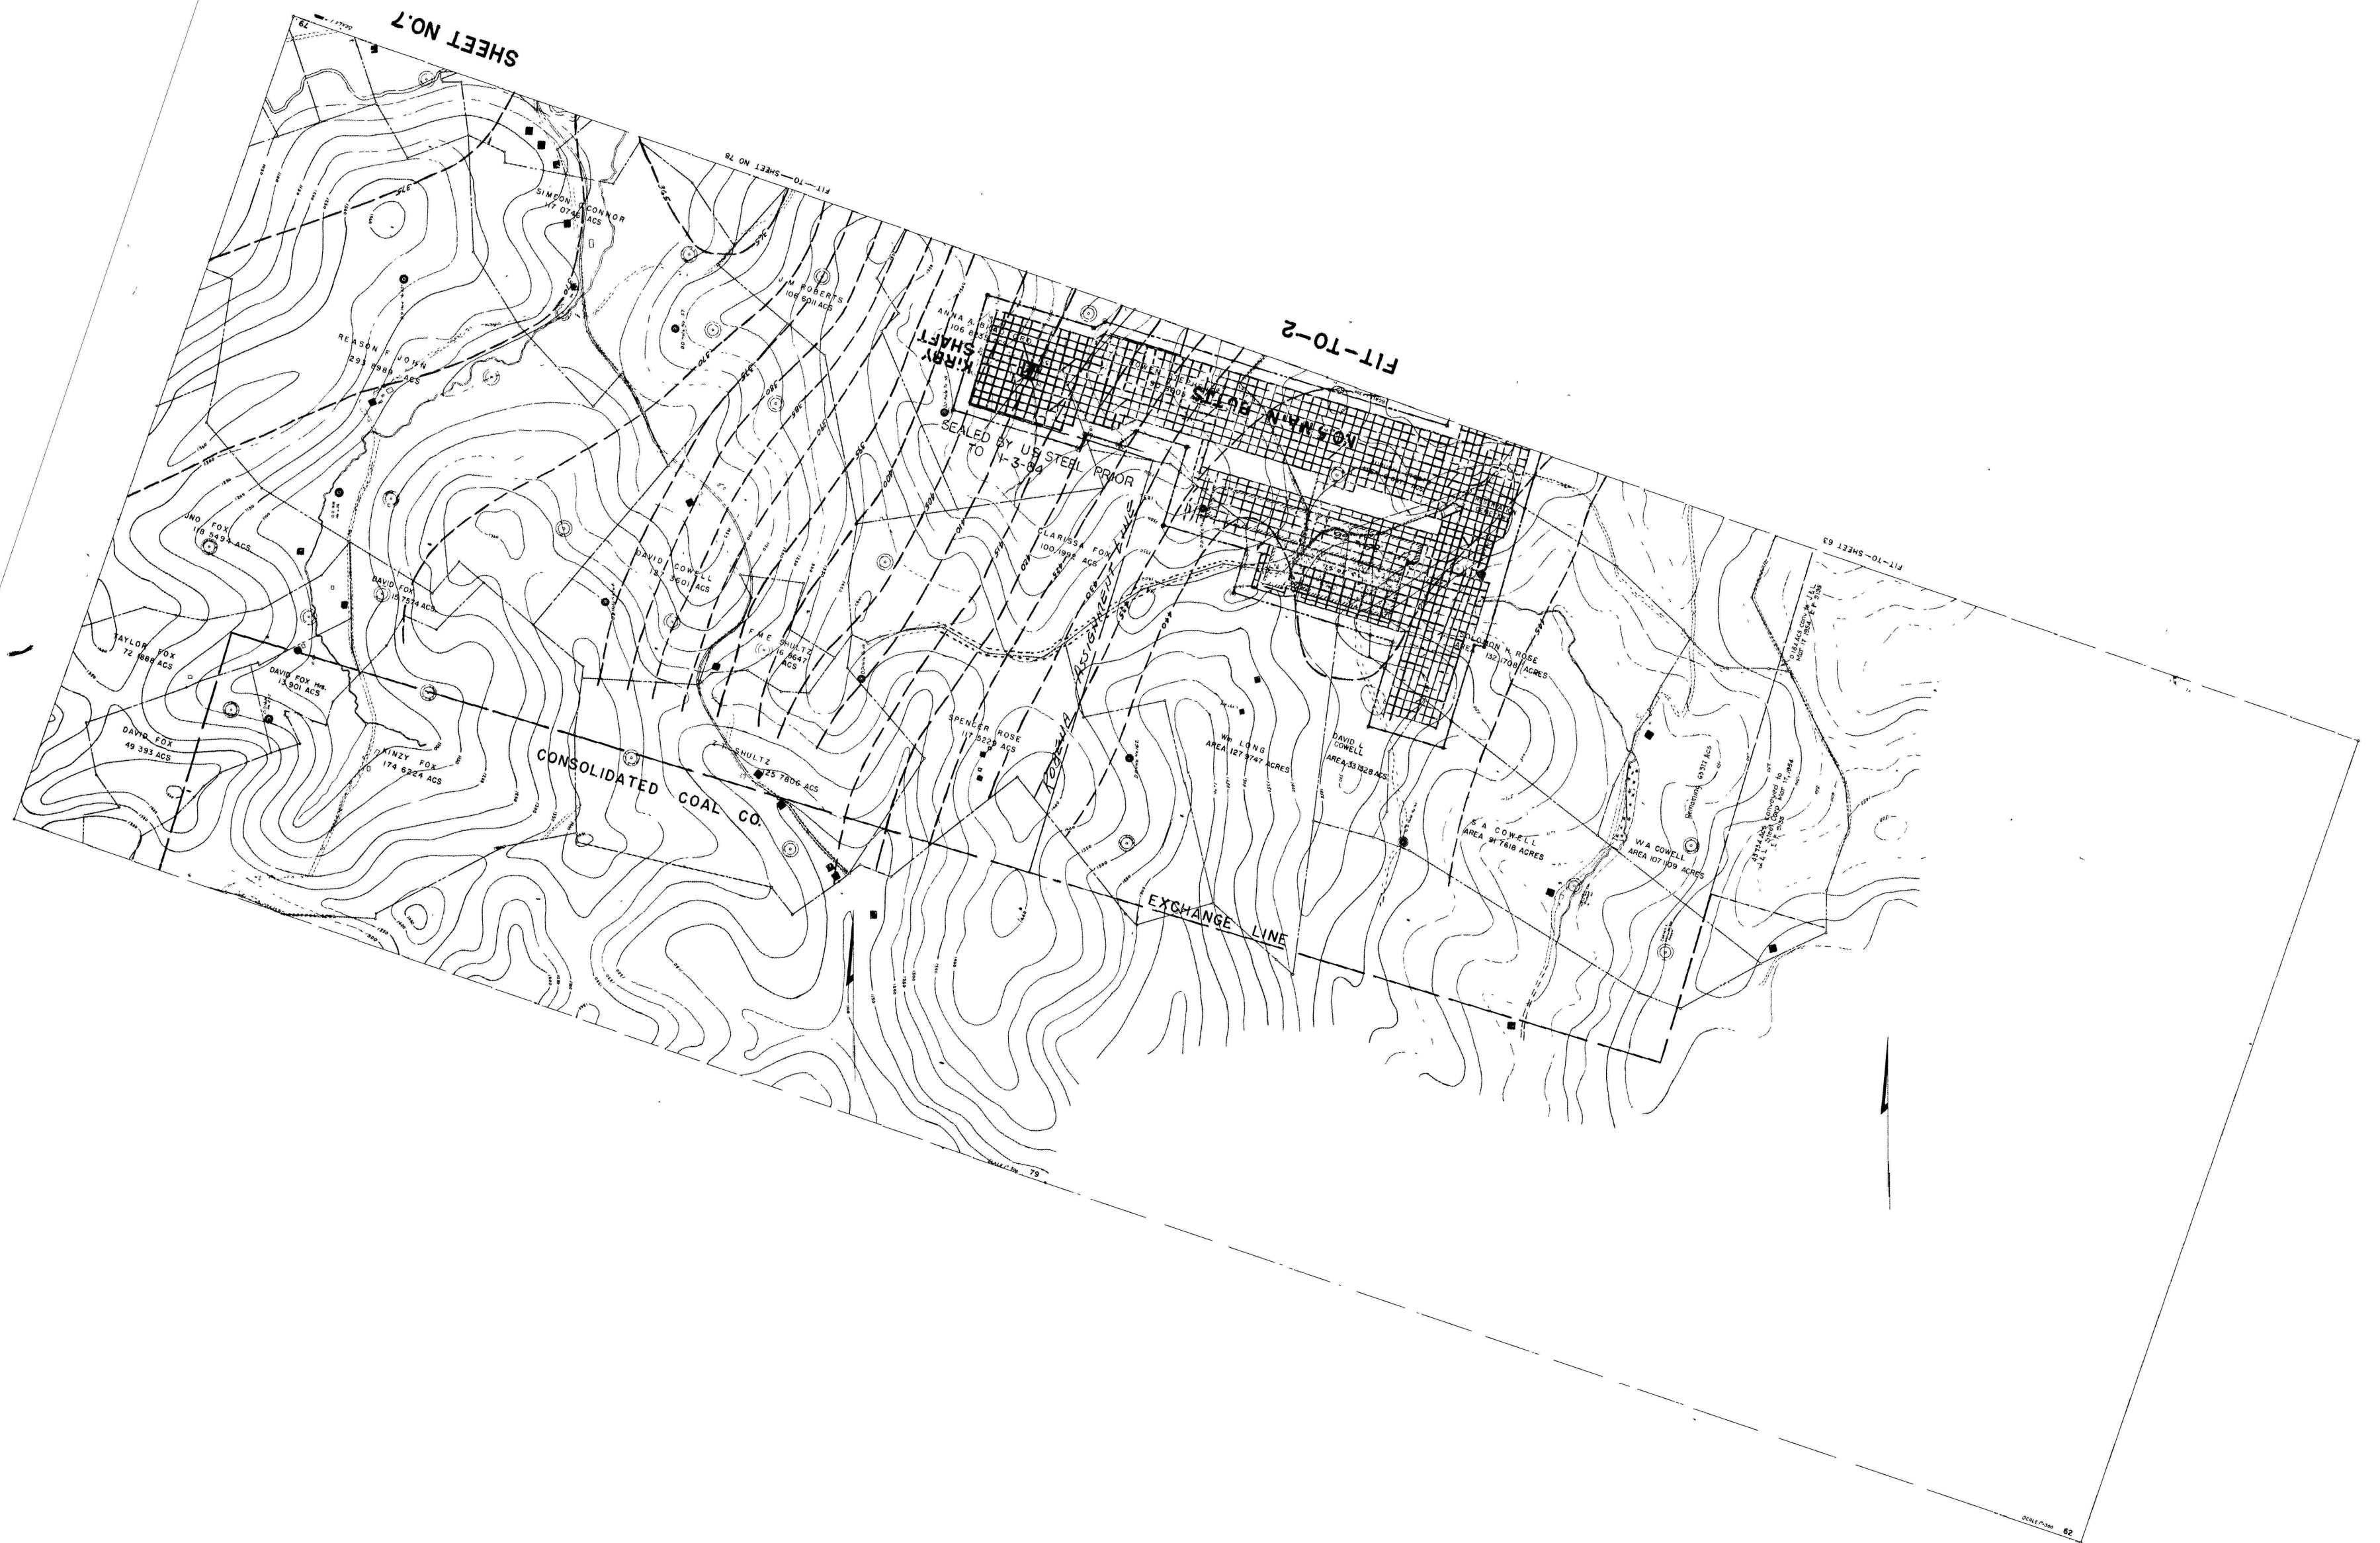


W. Harry Springer
4-24-84

SHEET NO. 7