

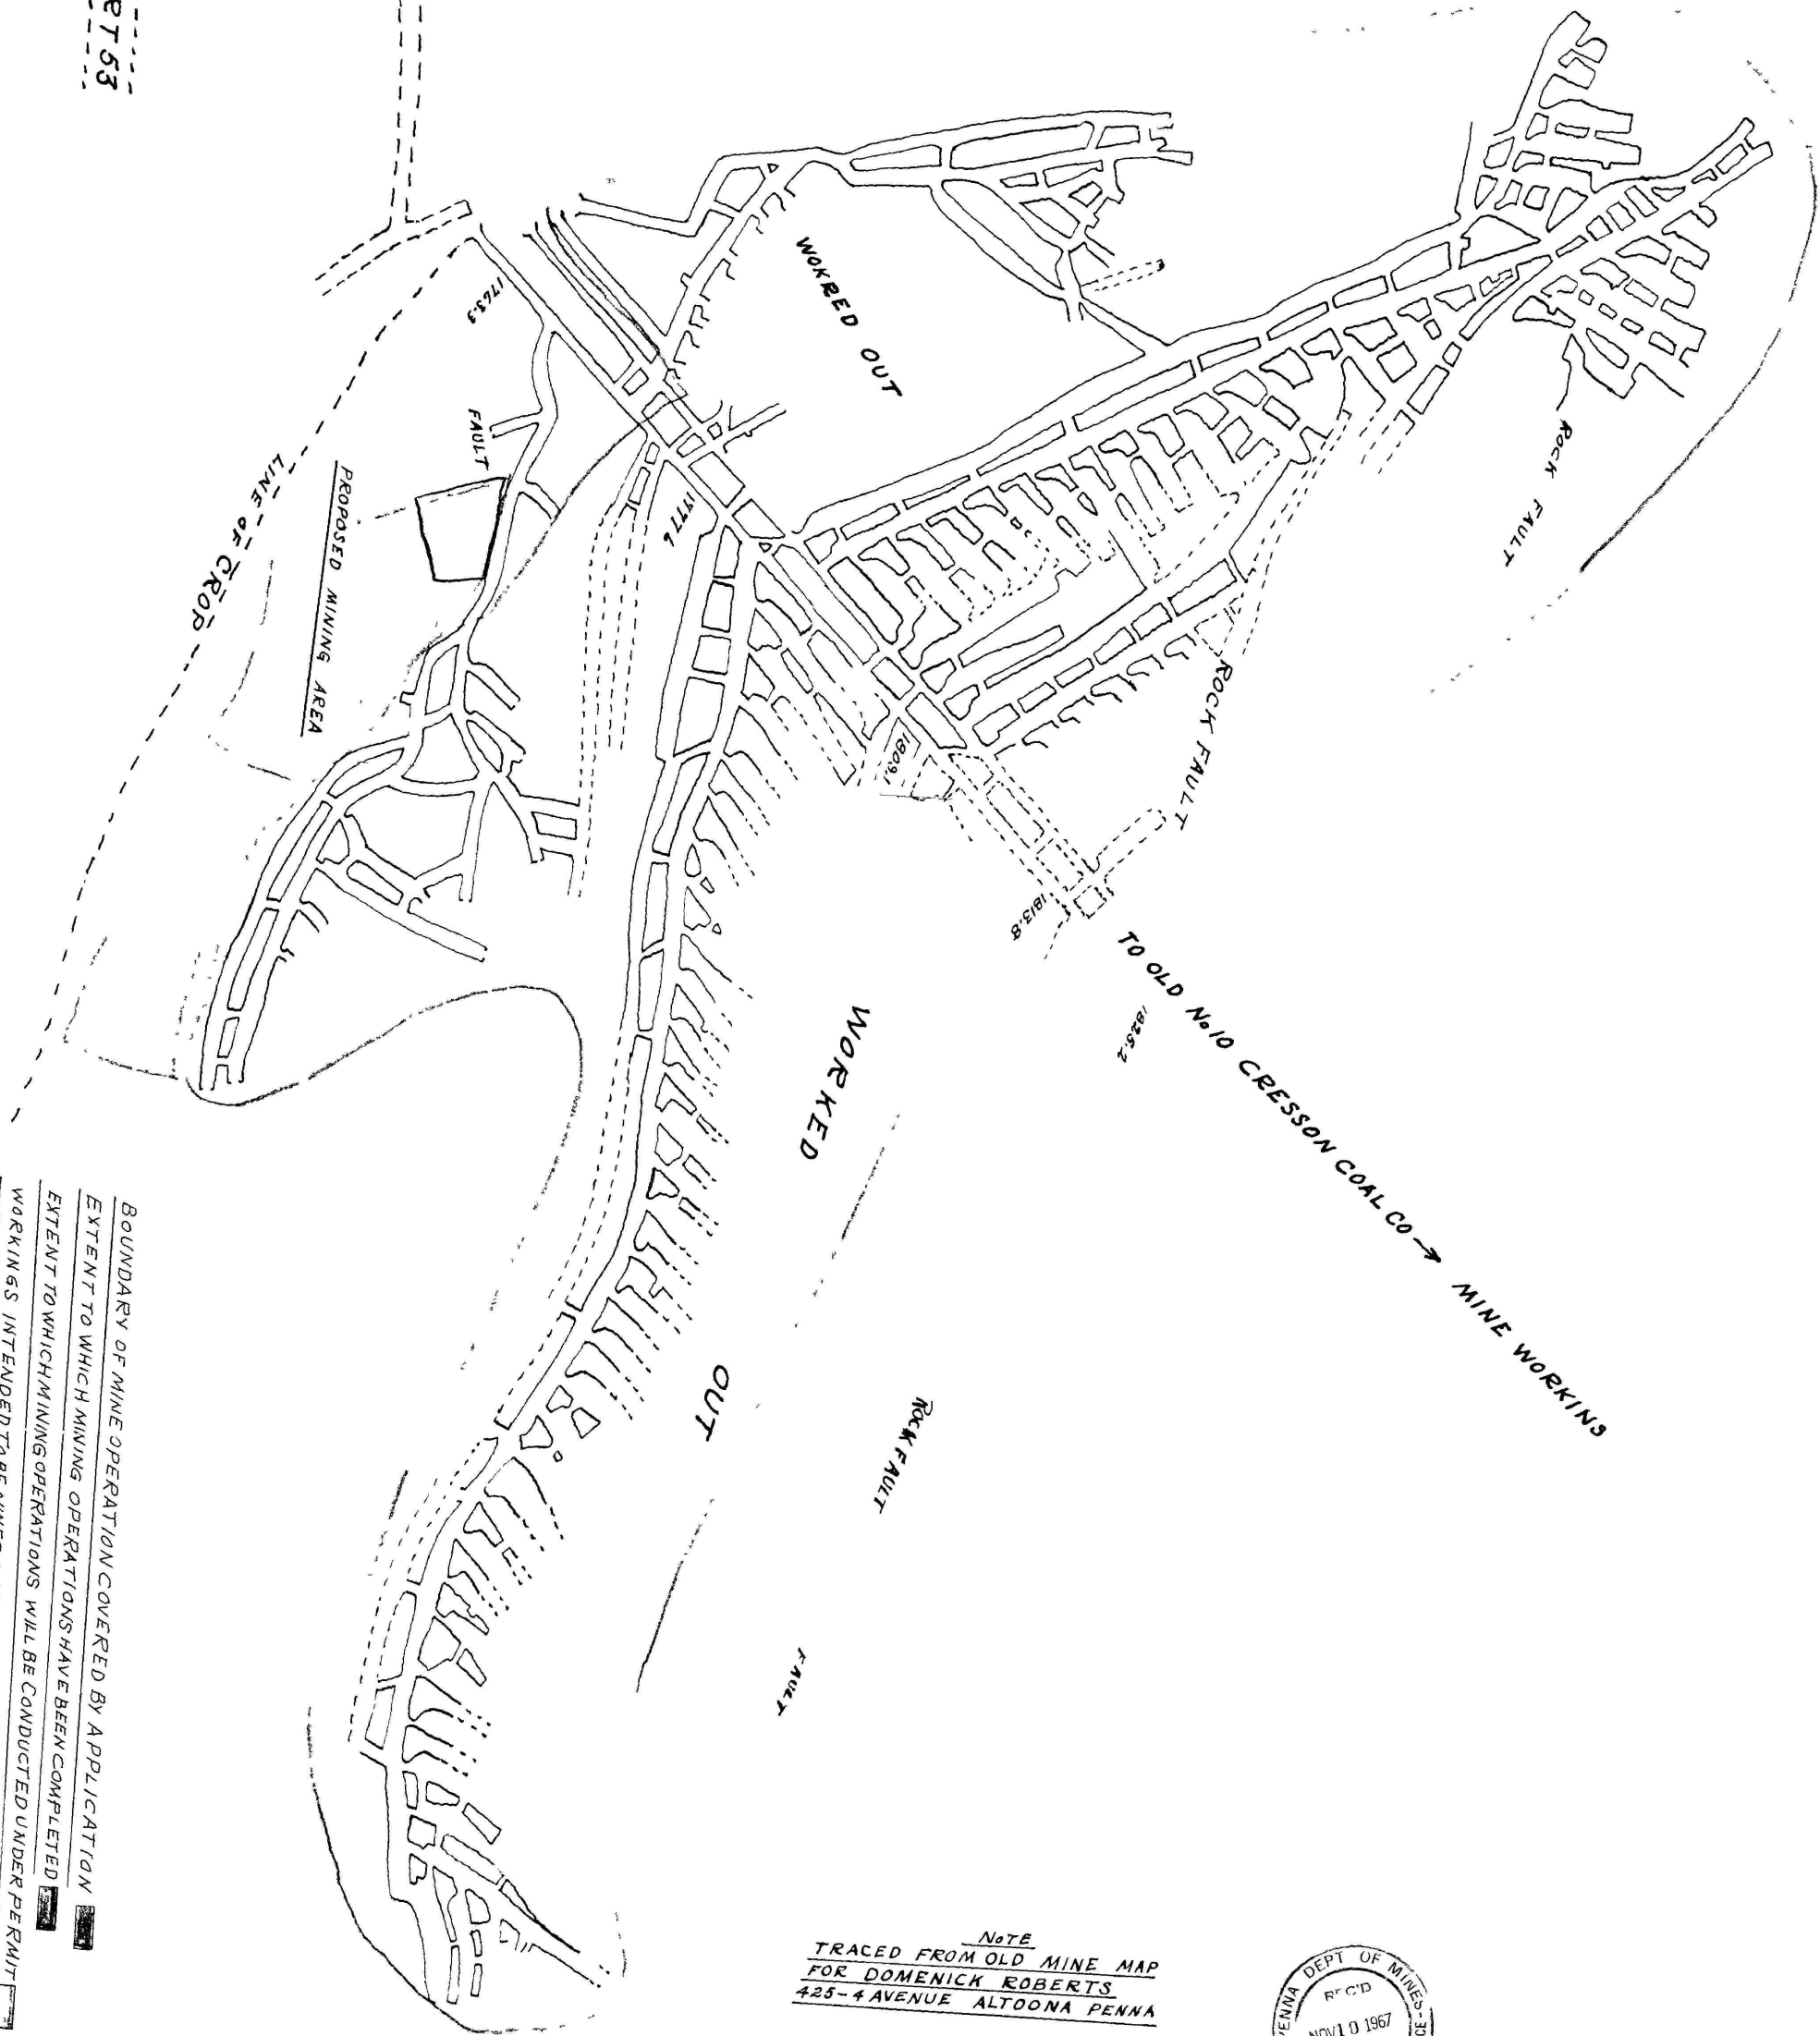


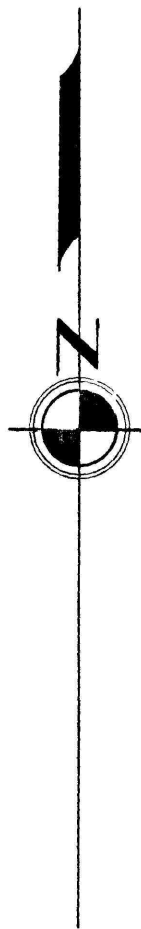

NOTE
TRACED FROM OLD MINE MAP
FOR DOMENICK ROBERTS
425-4 AVENUE ALTOONA PENNA

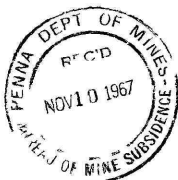

WITHROW No 10 MINE
SITUATED IN DEAN TOWNSHIP
CAMBRIA COUNTY PENNA
Scale 1"=100'

By Ray A. Hill R.S.

BOUNDARY OF MINE OPERATION COVERED BY APPLICATION
EXTENT TO WHICH MINING OPERATIONS HAVE BEEN COMPLETED
EXTENT TO WHICH MINING OPERATIONS WILL BE CONDUCTED UNDER PERMIT
WORKINGS INTENDED TO BE MINED DURING SUCCEEDING SIX MONTH PERIOD
DEC 1 - 1967 JUNE 1968