


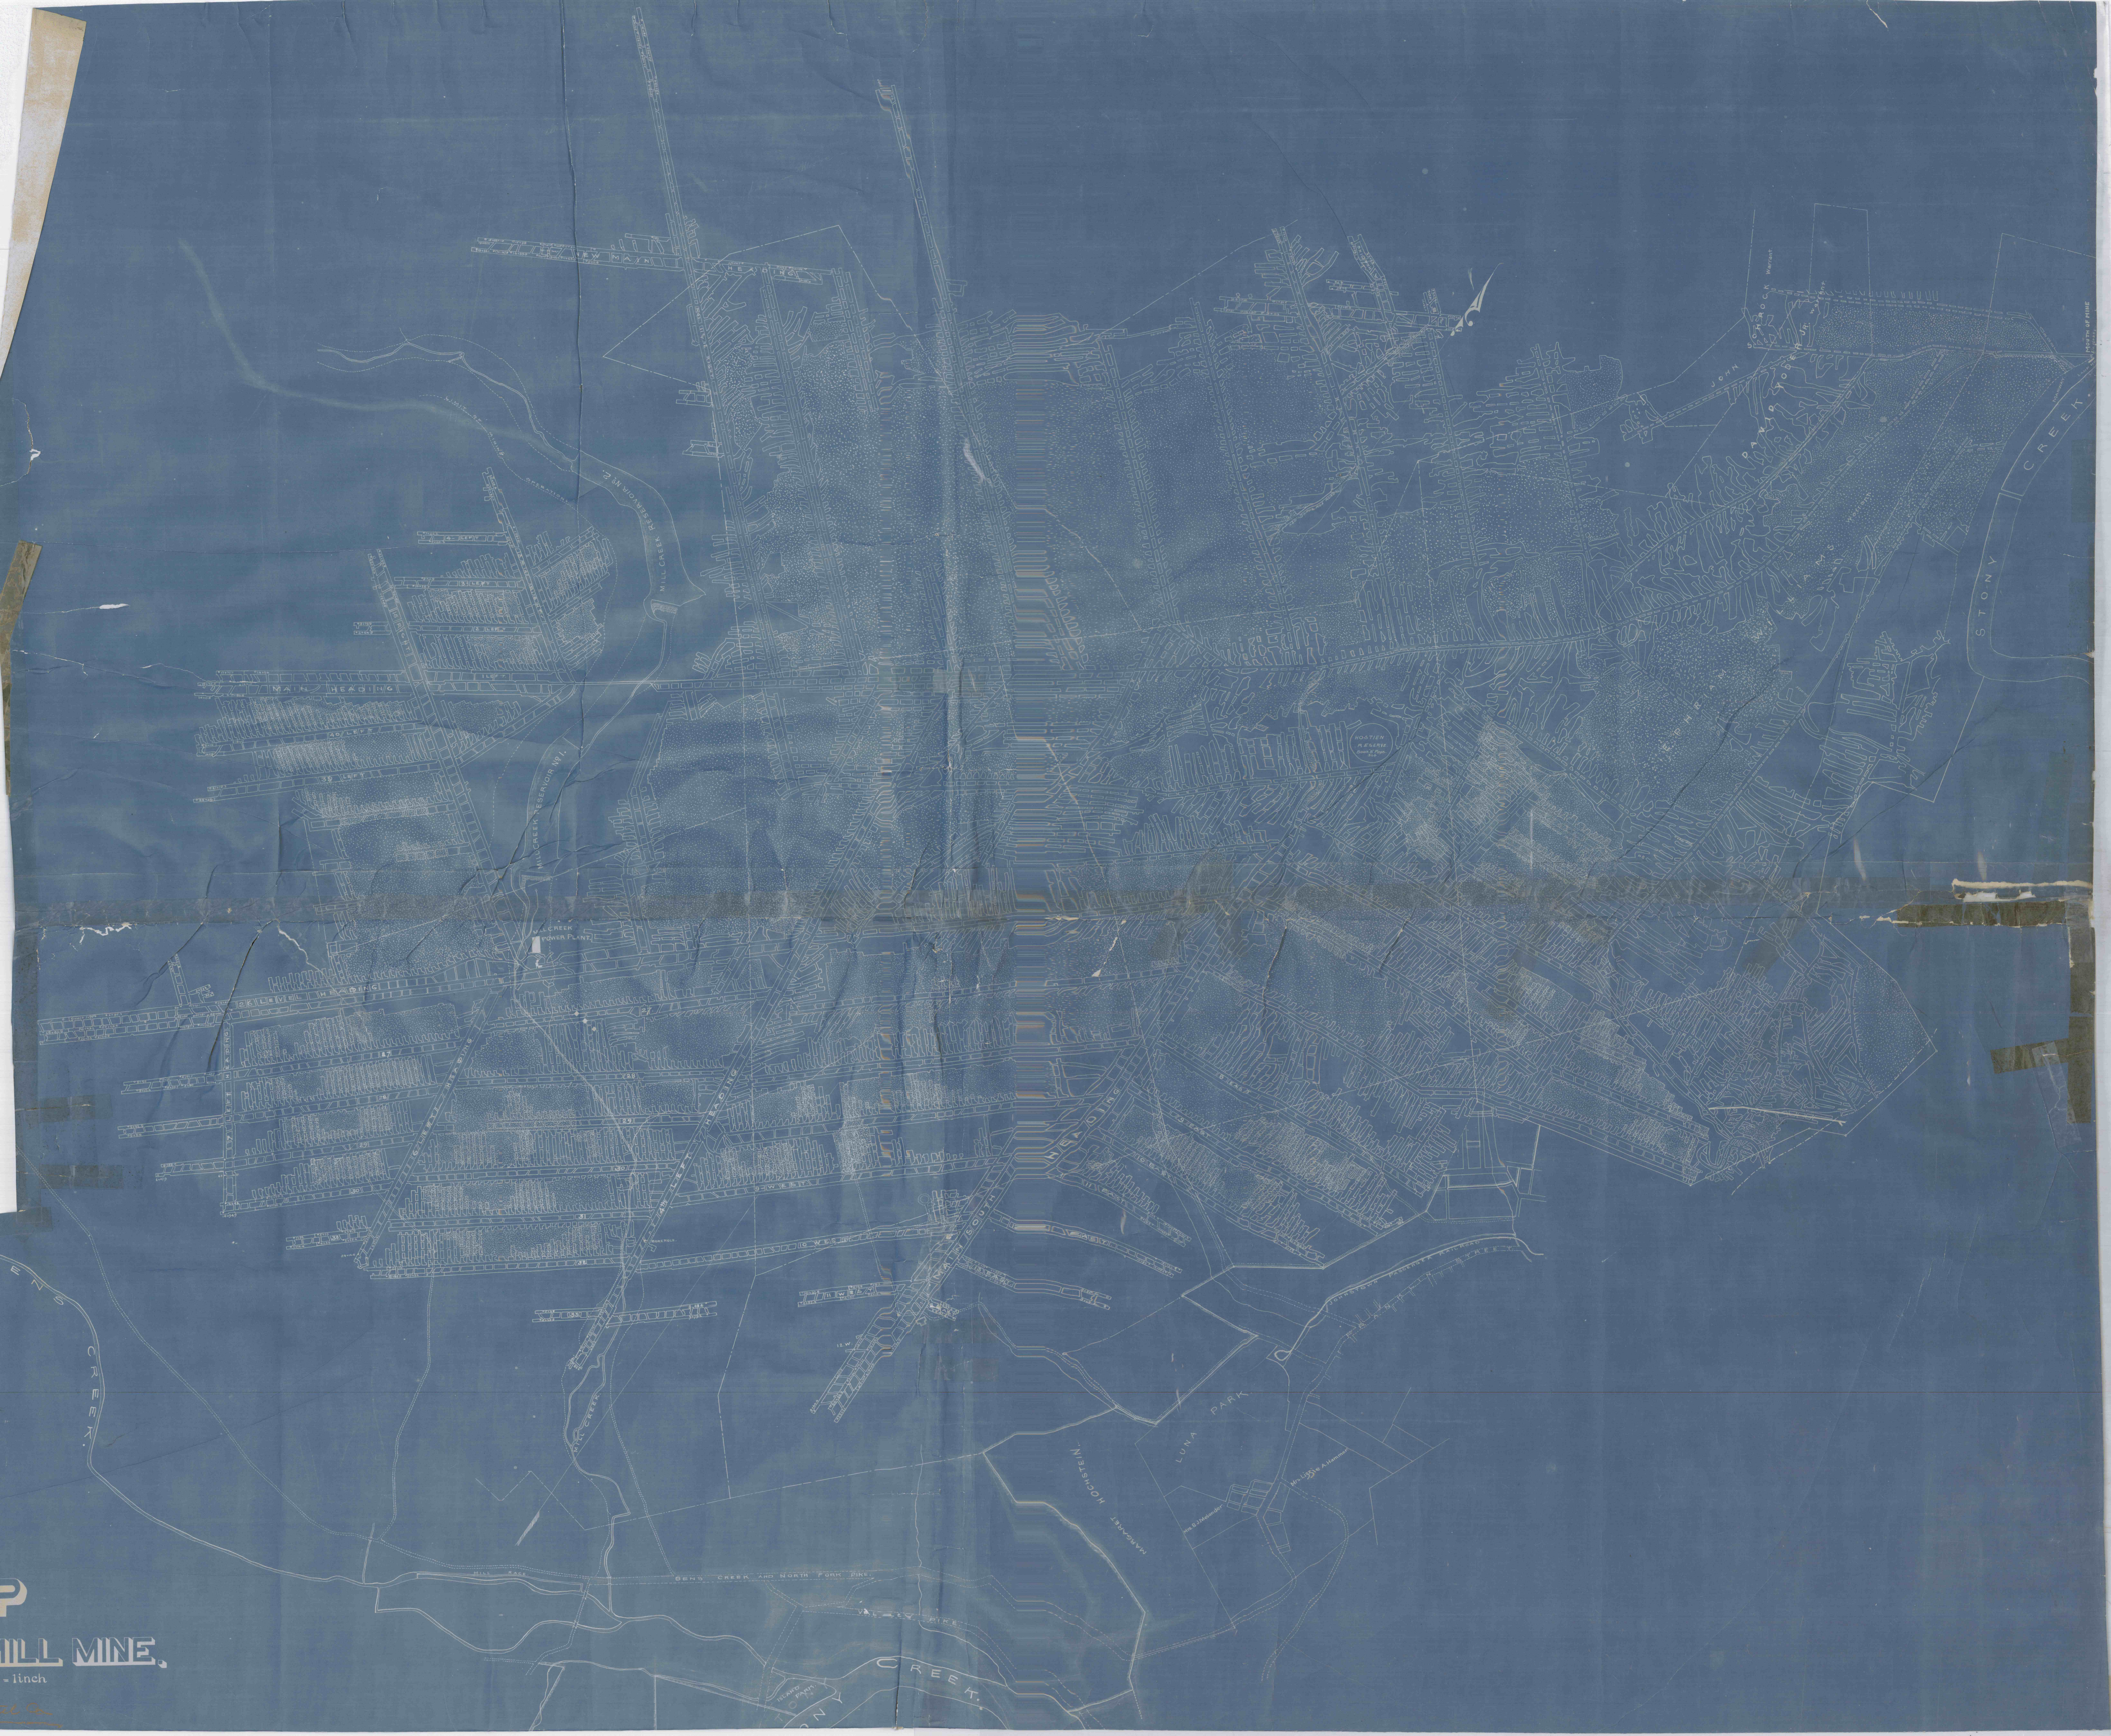

P
MILL MINE.
= 1 inch