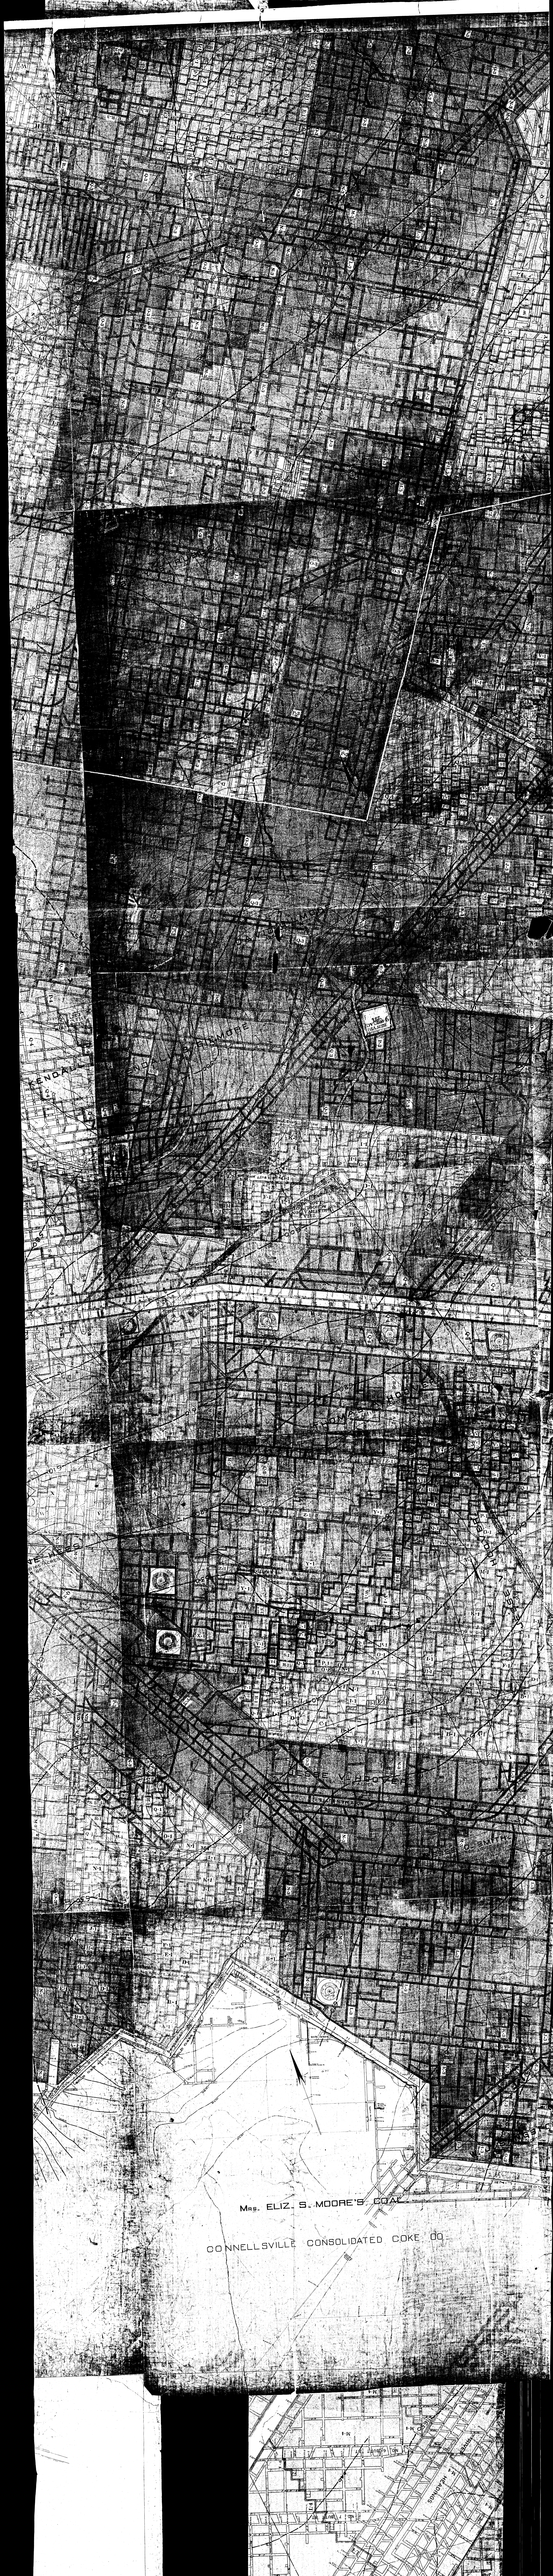
Mrs. ELIZ. S. MOORE'S COAL
CONNELLSVILLE CONSOLIDATED COKE CO.