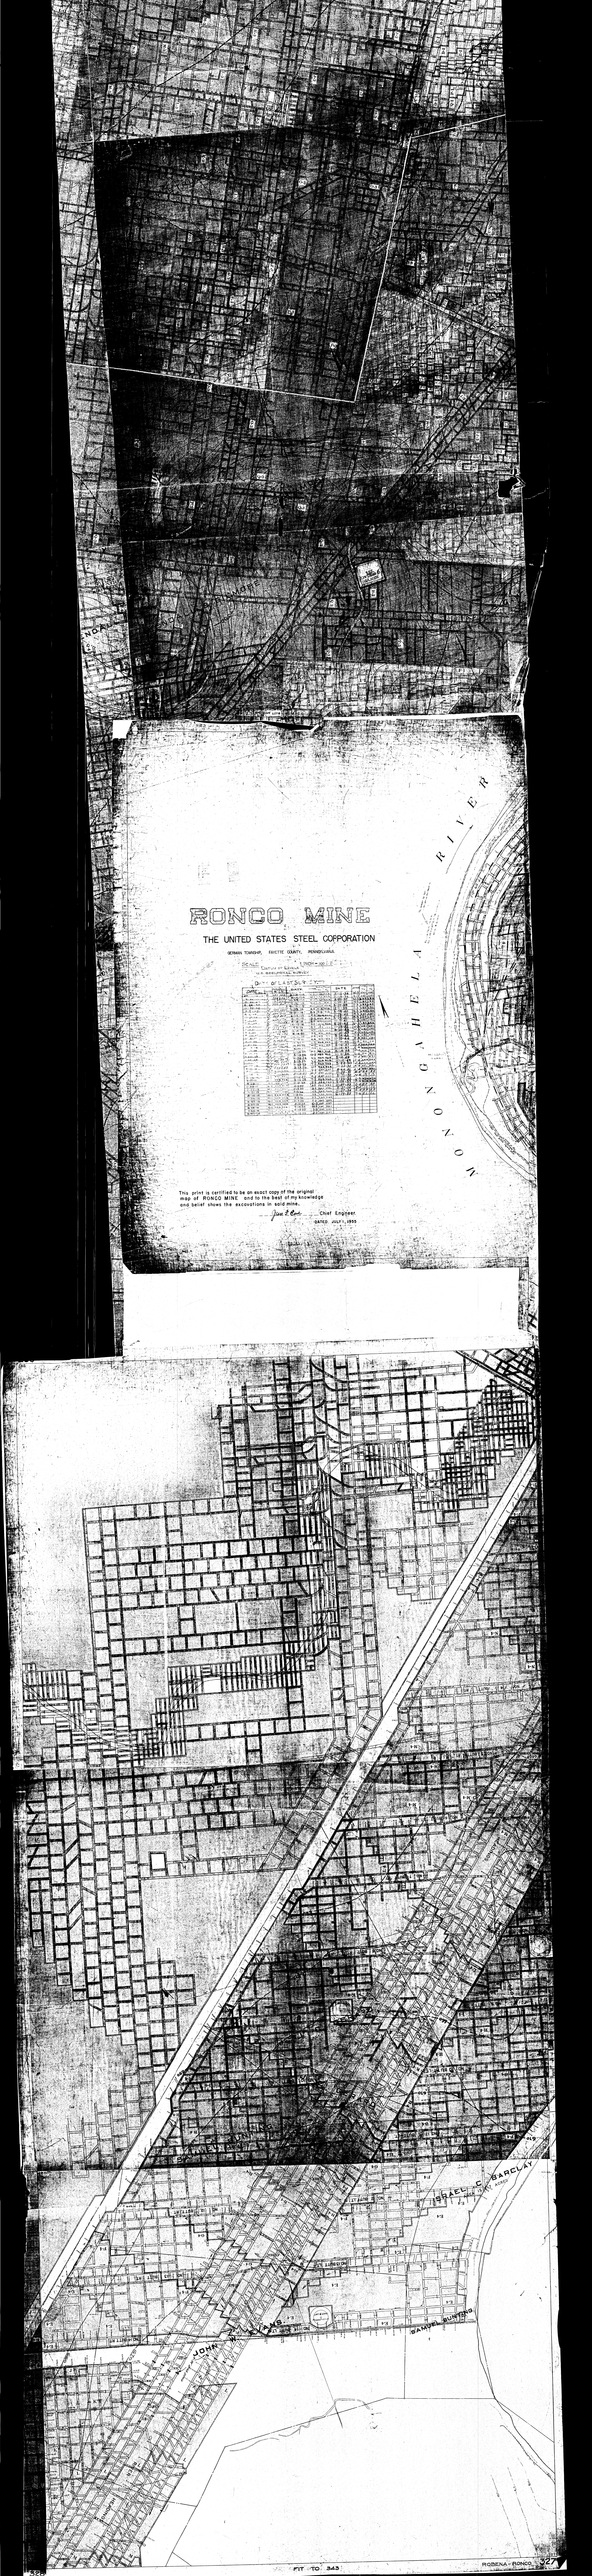
RONCO MINE
THE UNITED STATES STEEL CORPORATION
MONONGAHELA RIVER
This print is certified to be an exact copy of the original map of RONCO MINE and to the best of my knowledge and belief shows the excavations in said mine.
Chief Engineer
DATED JULY 1, 1905
ISRAEL C. BARCLAY
JOHN W. LANG
SAMUEL BUNTING
FIT TO 343
MODENA-RONCO
327