


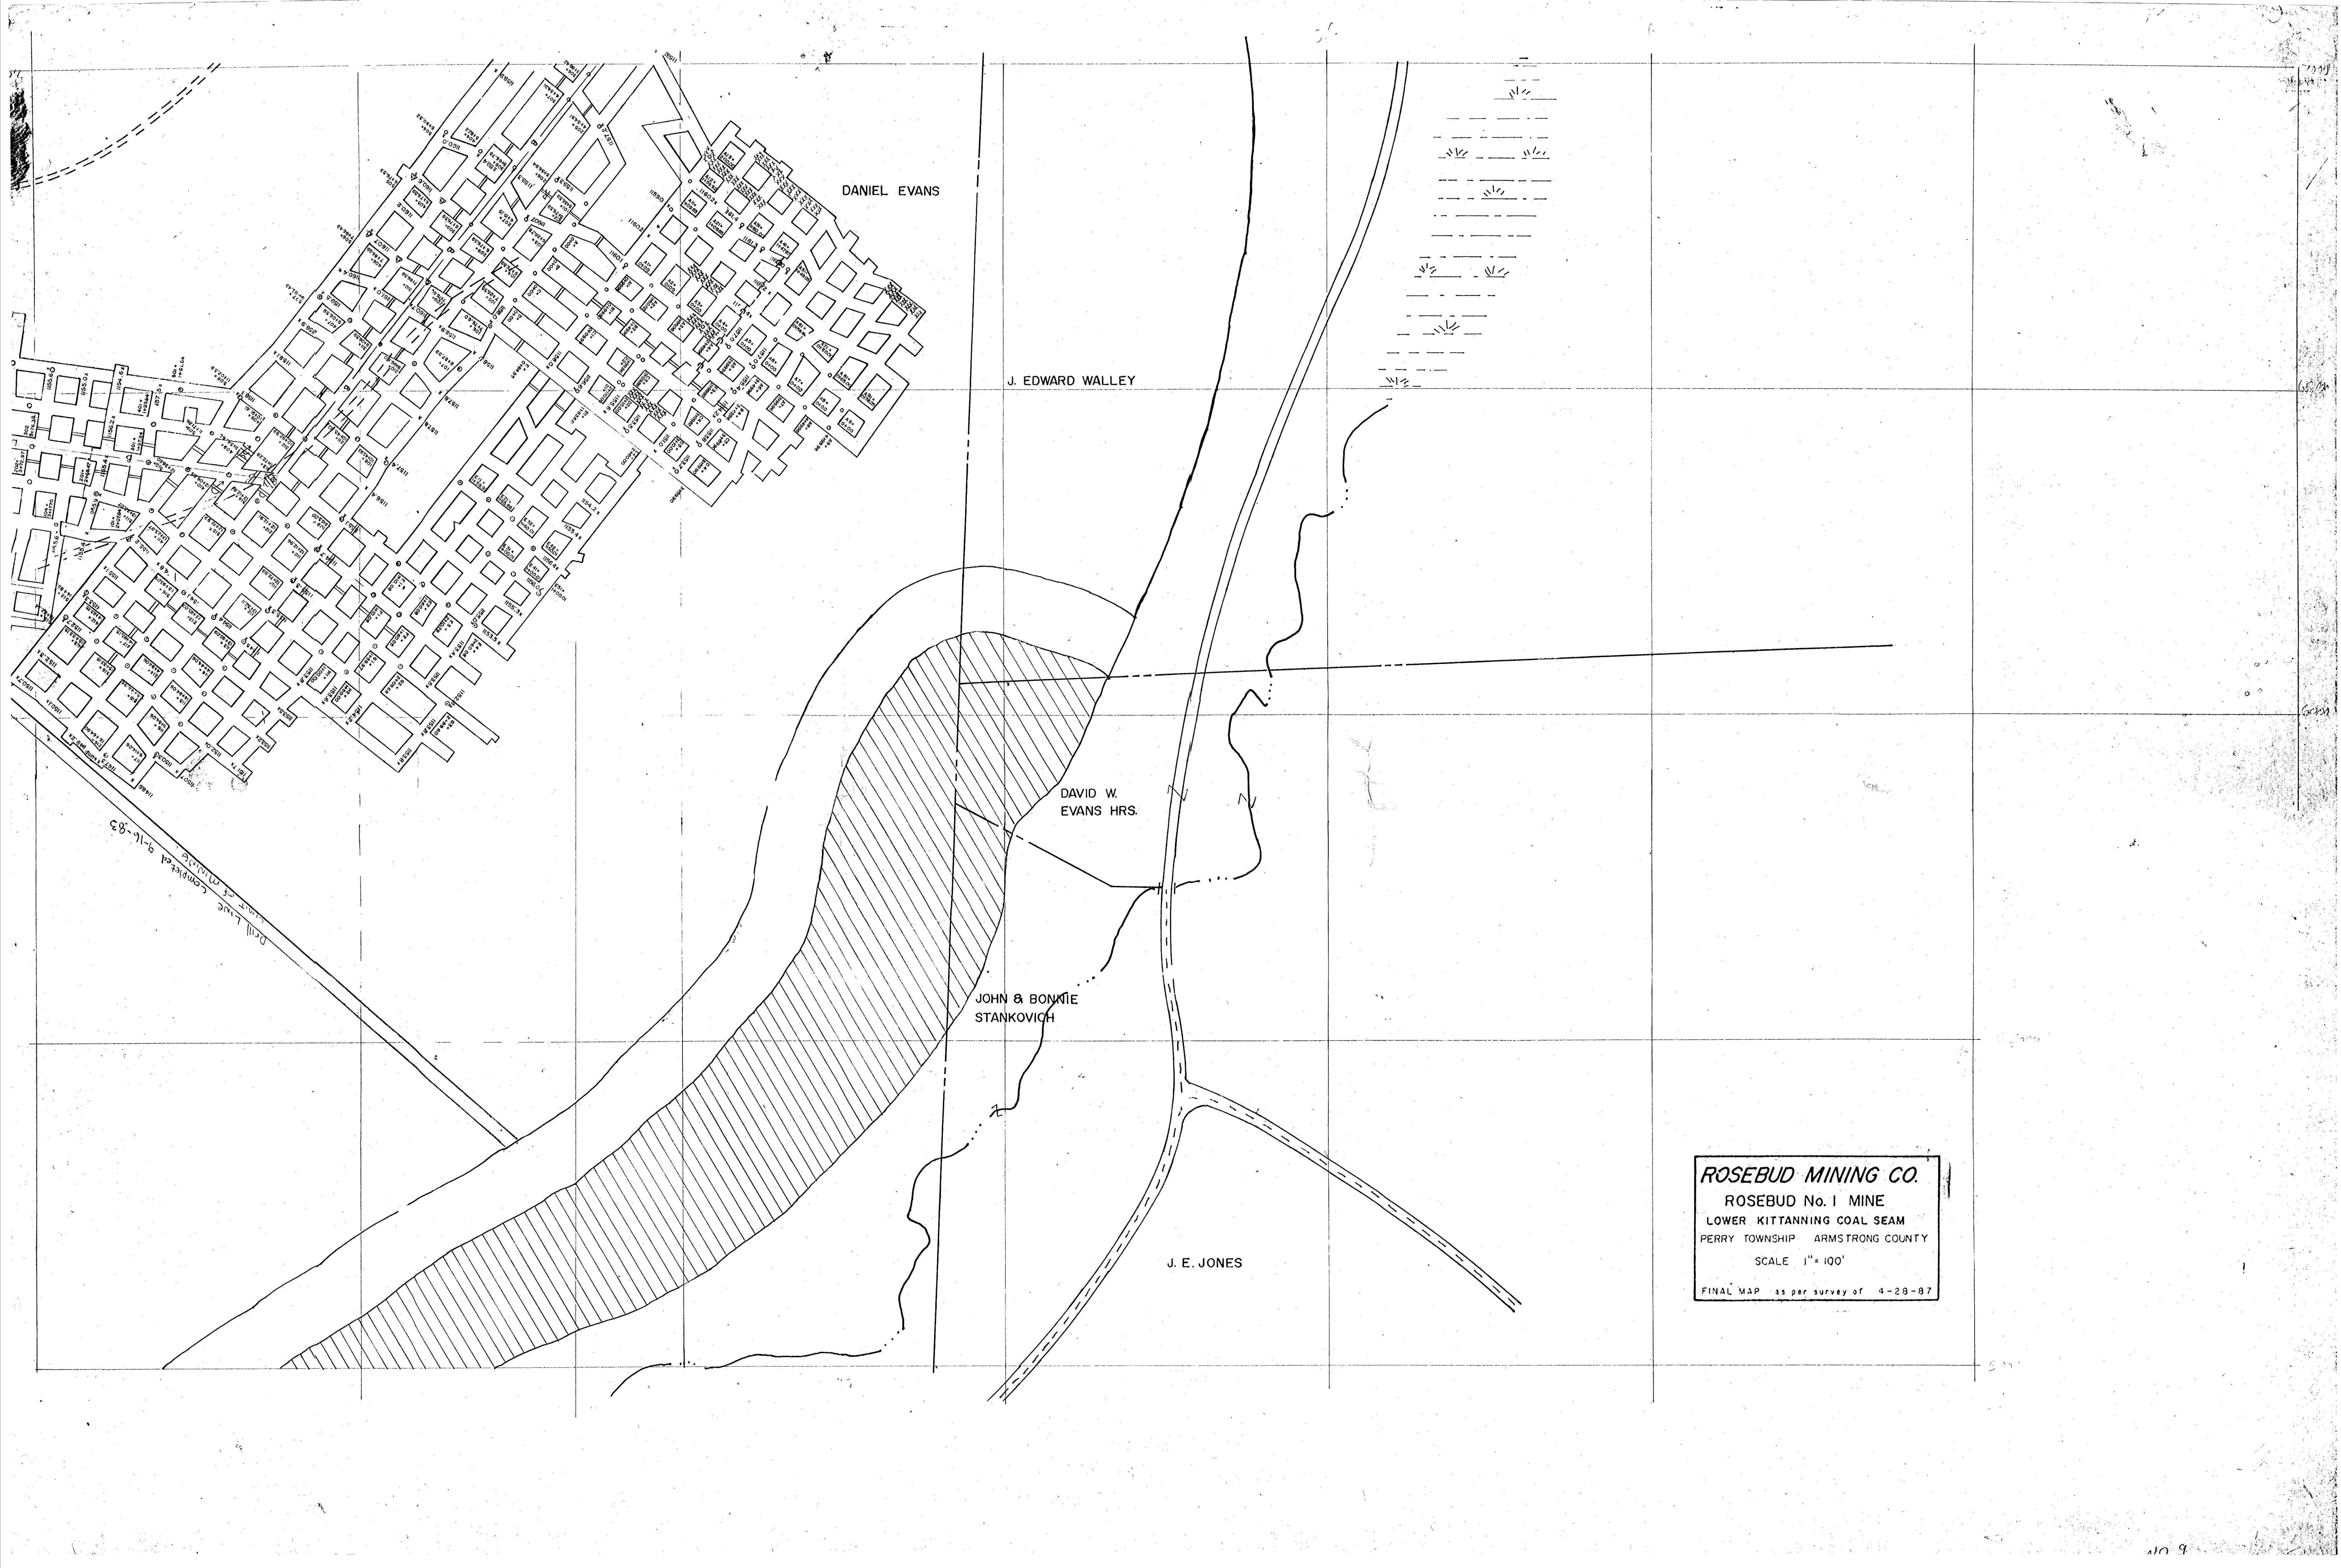

ROSEBUD MINING CO.
ROSEBUD No. 1 MINE
LOWER KITTANNING COAL SEAM
PERRY TOWNSHIP ARMSTRONG COUNTY
SCALE 1" = 100'
FINAL MAP as per survey of 4-28-87