



MATCH LINE C-C

MATCH LINE C-C

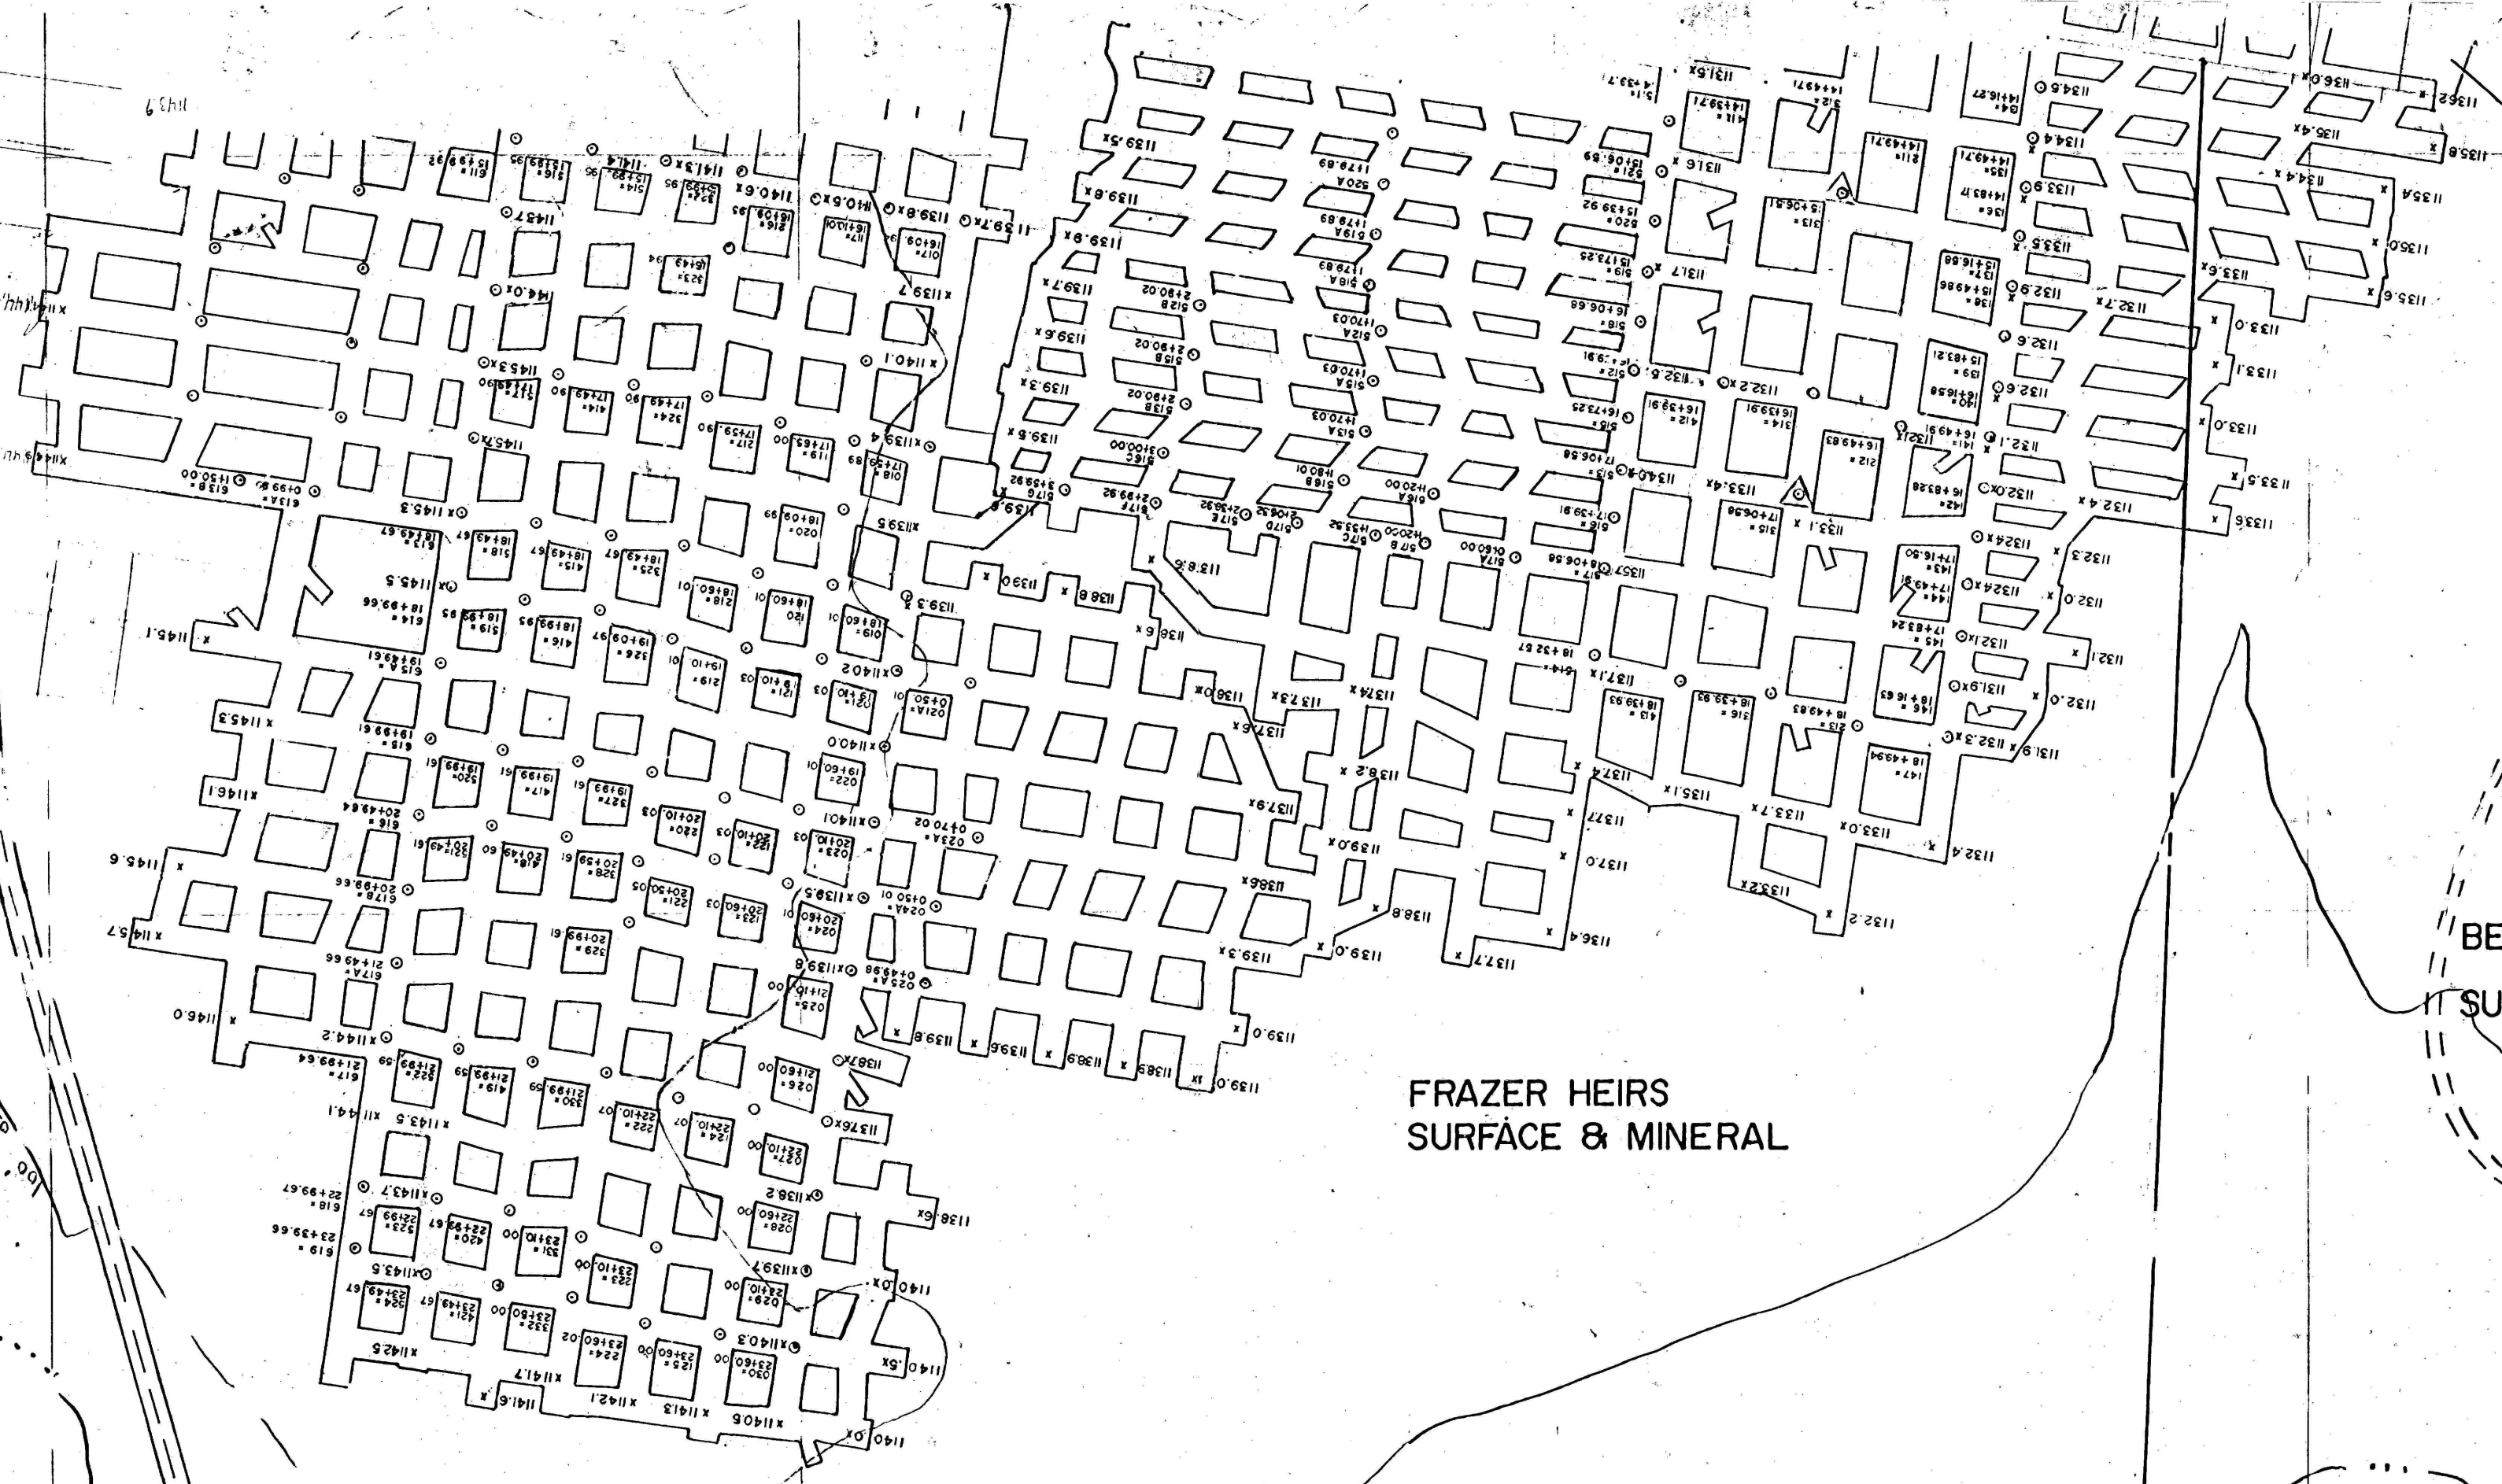

FRAZER HEIRS
SURFACE & MINERAL

BESSEMER & LAKE ERIE RAILROAD
SURFACE & MINERAL

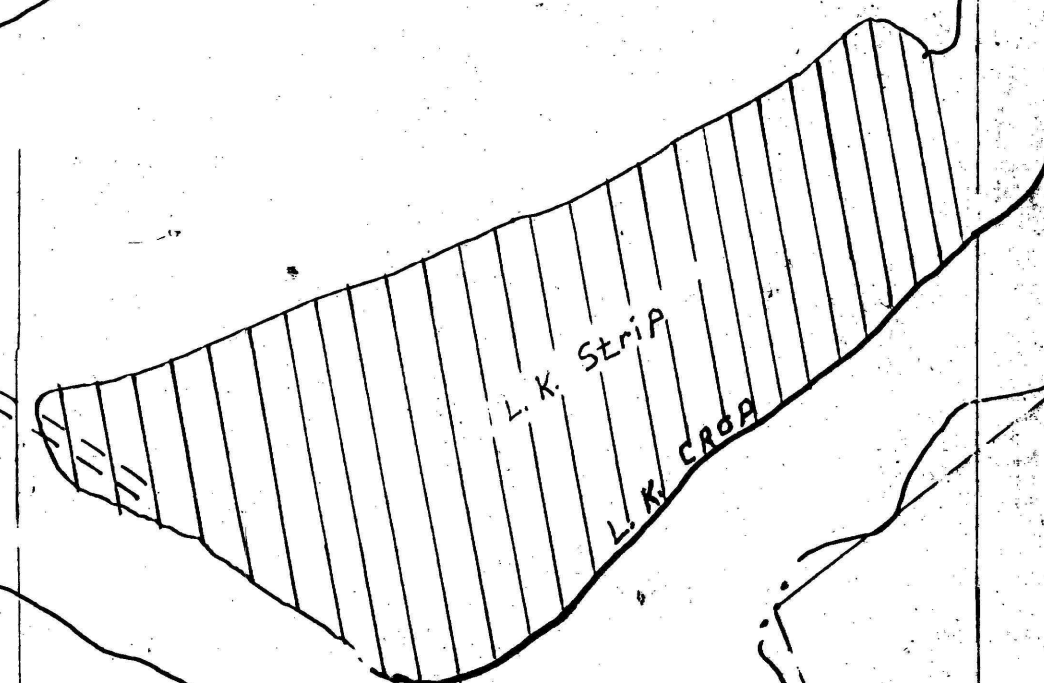

L.R. 03030

L.R. 03029

ROSEBUD MINING CO.
ROSEBUD No. 1 MINE
LOWER KITTANNING COAL SEAM
PERRY TOWNSHIP ARMSTRONG COUNTY
SCALE: 1"=100'
FINAL MAP as per survey of 4-28-87