


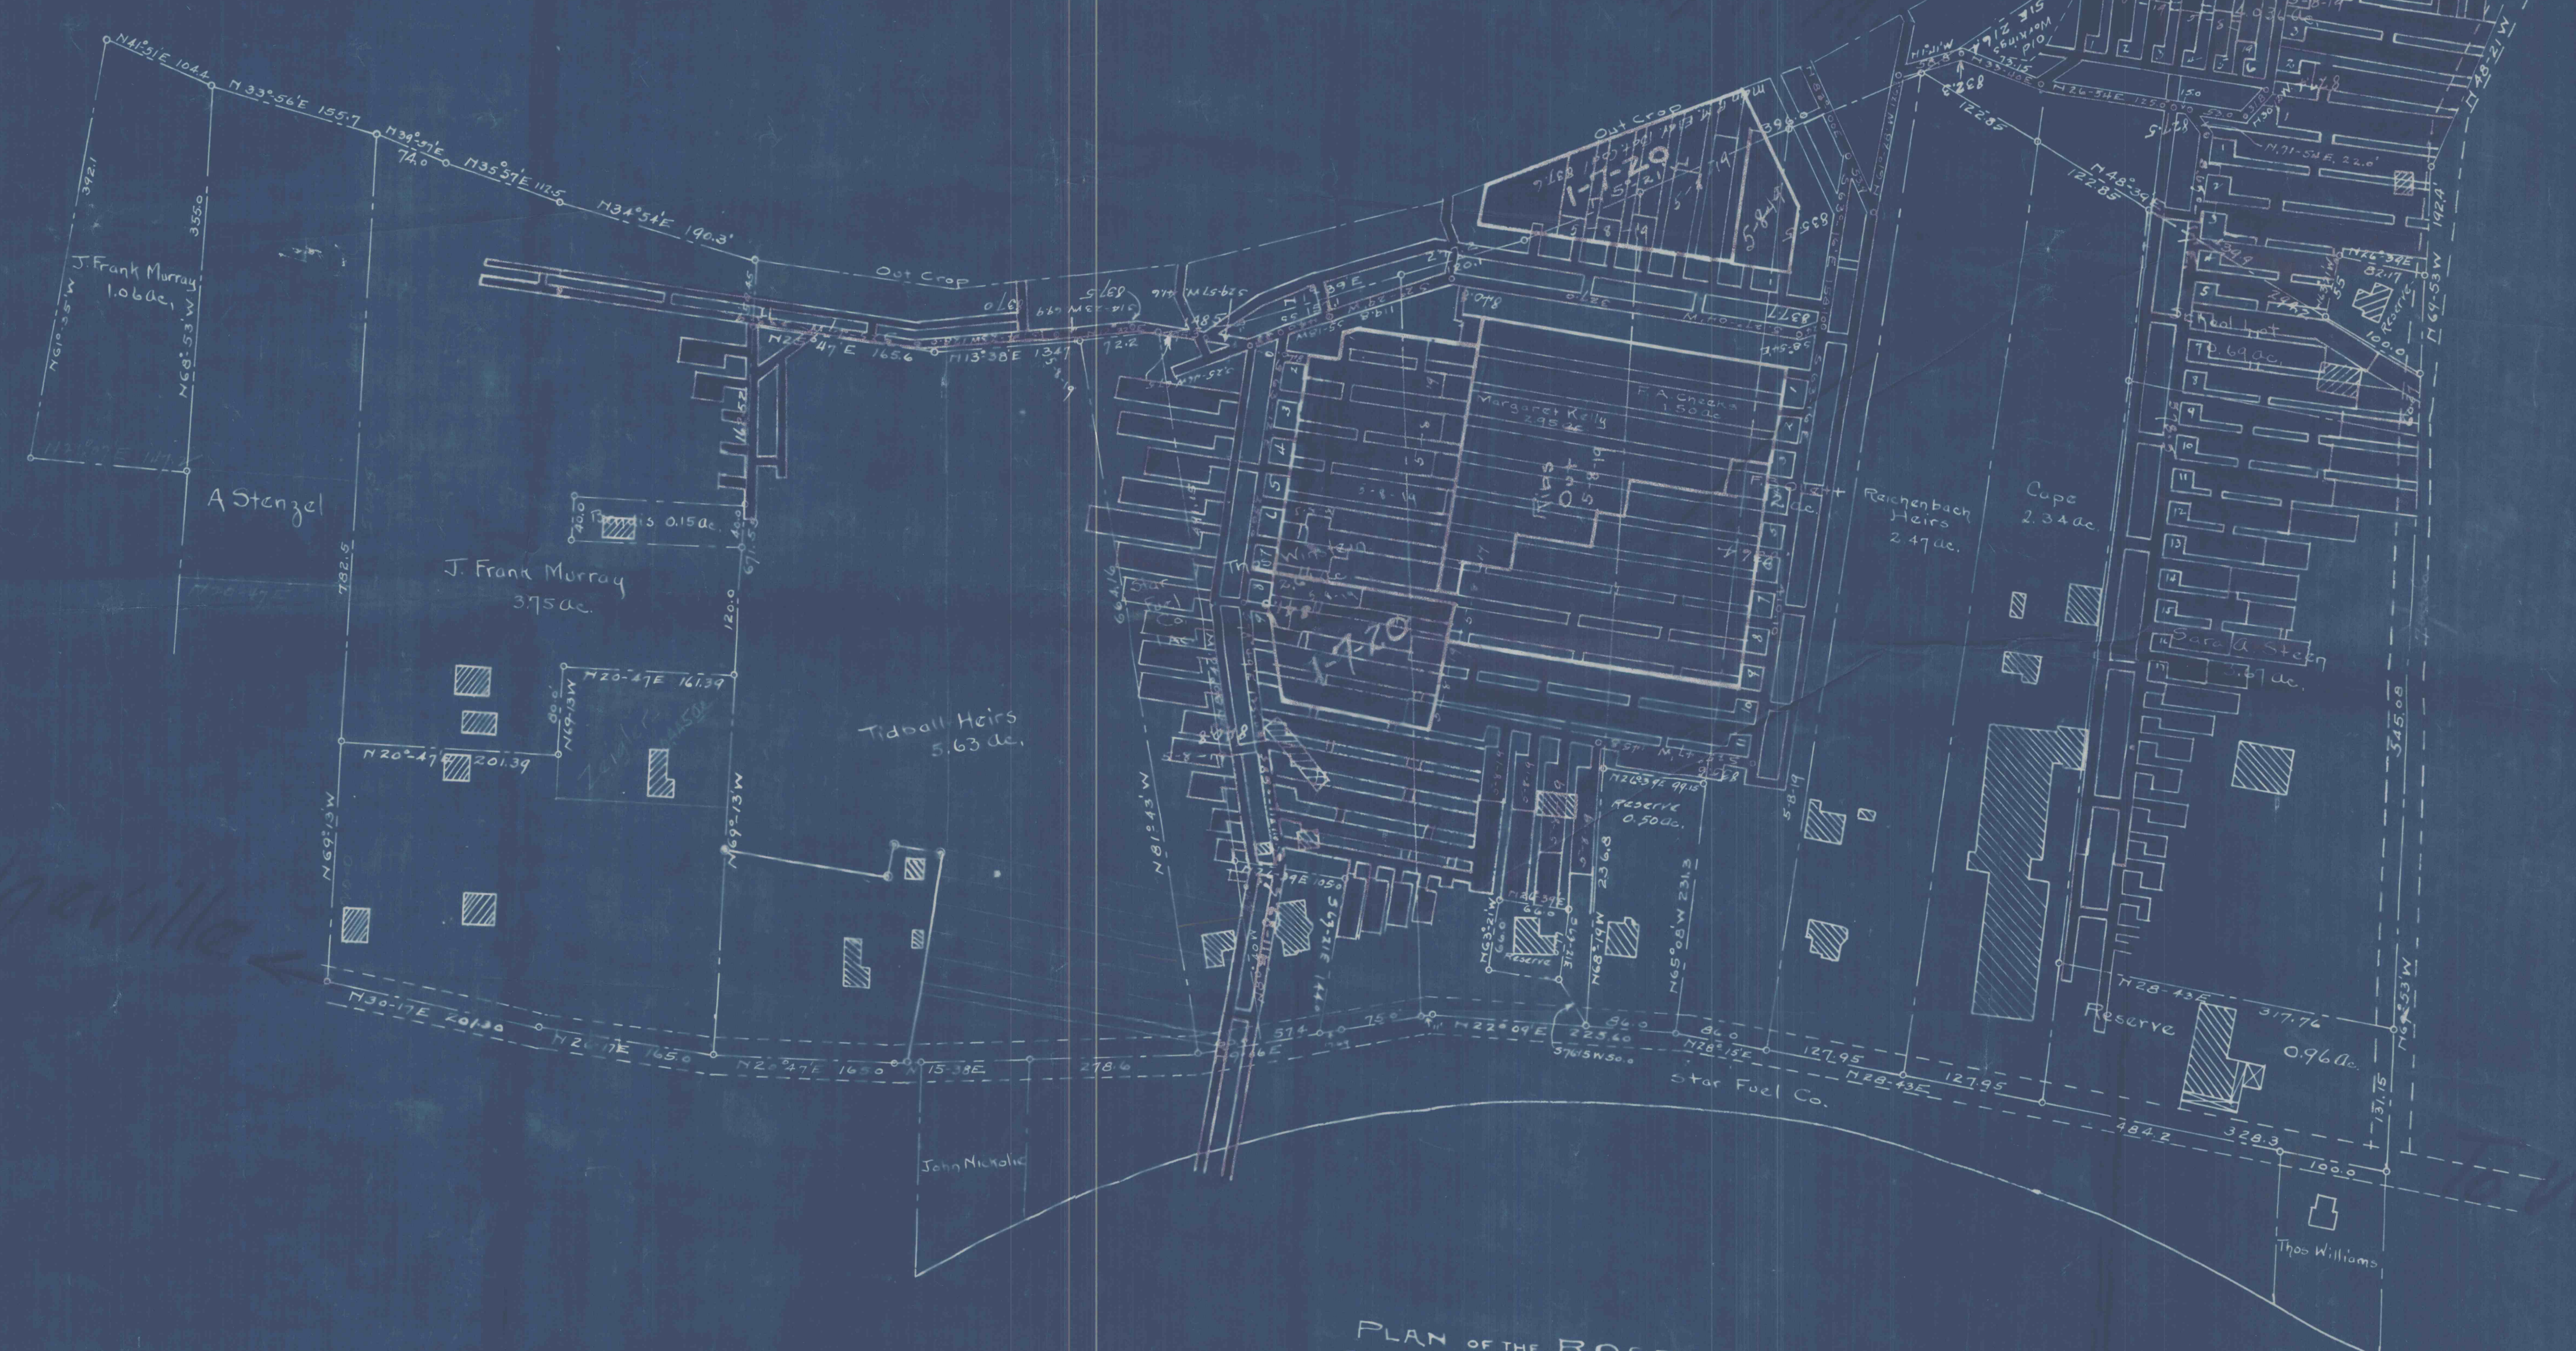

PLAN OF THE ROSEVALE MINE
 Olett Bros. Coal Company.
 Situate in Collier Township, Allegheny County, Penna.
 Surveyed - May 8-11-19
 Oct. 6-1919
 Jan. 7-1920

Source No. 100
 Pittsburgh / Source - 4-6" Thick