


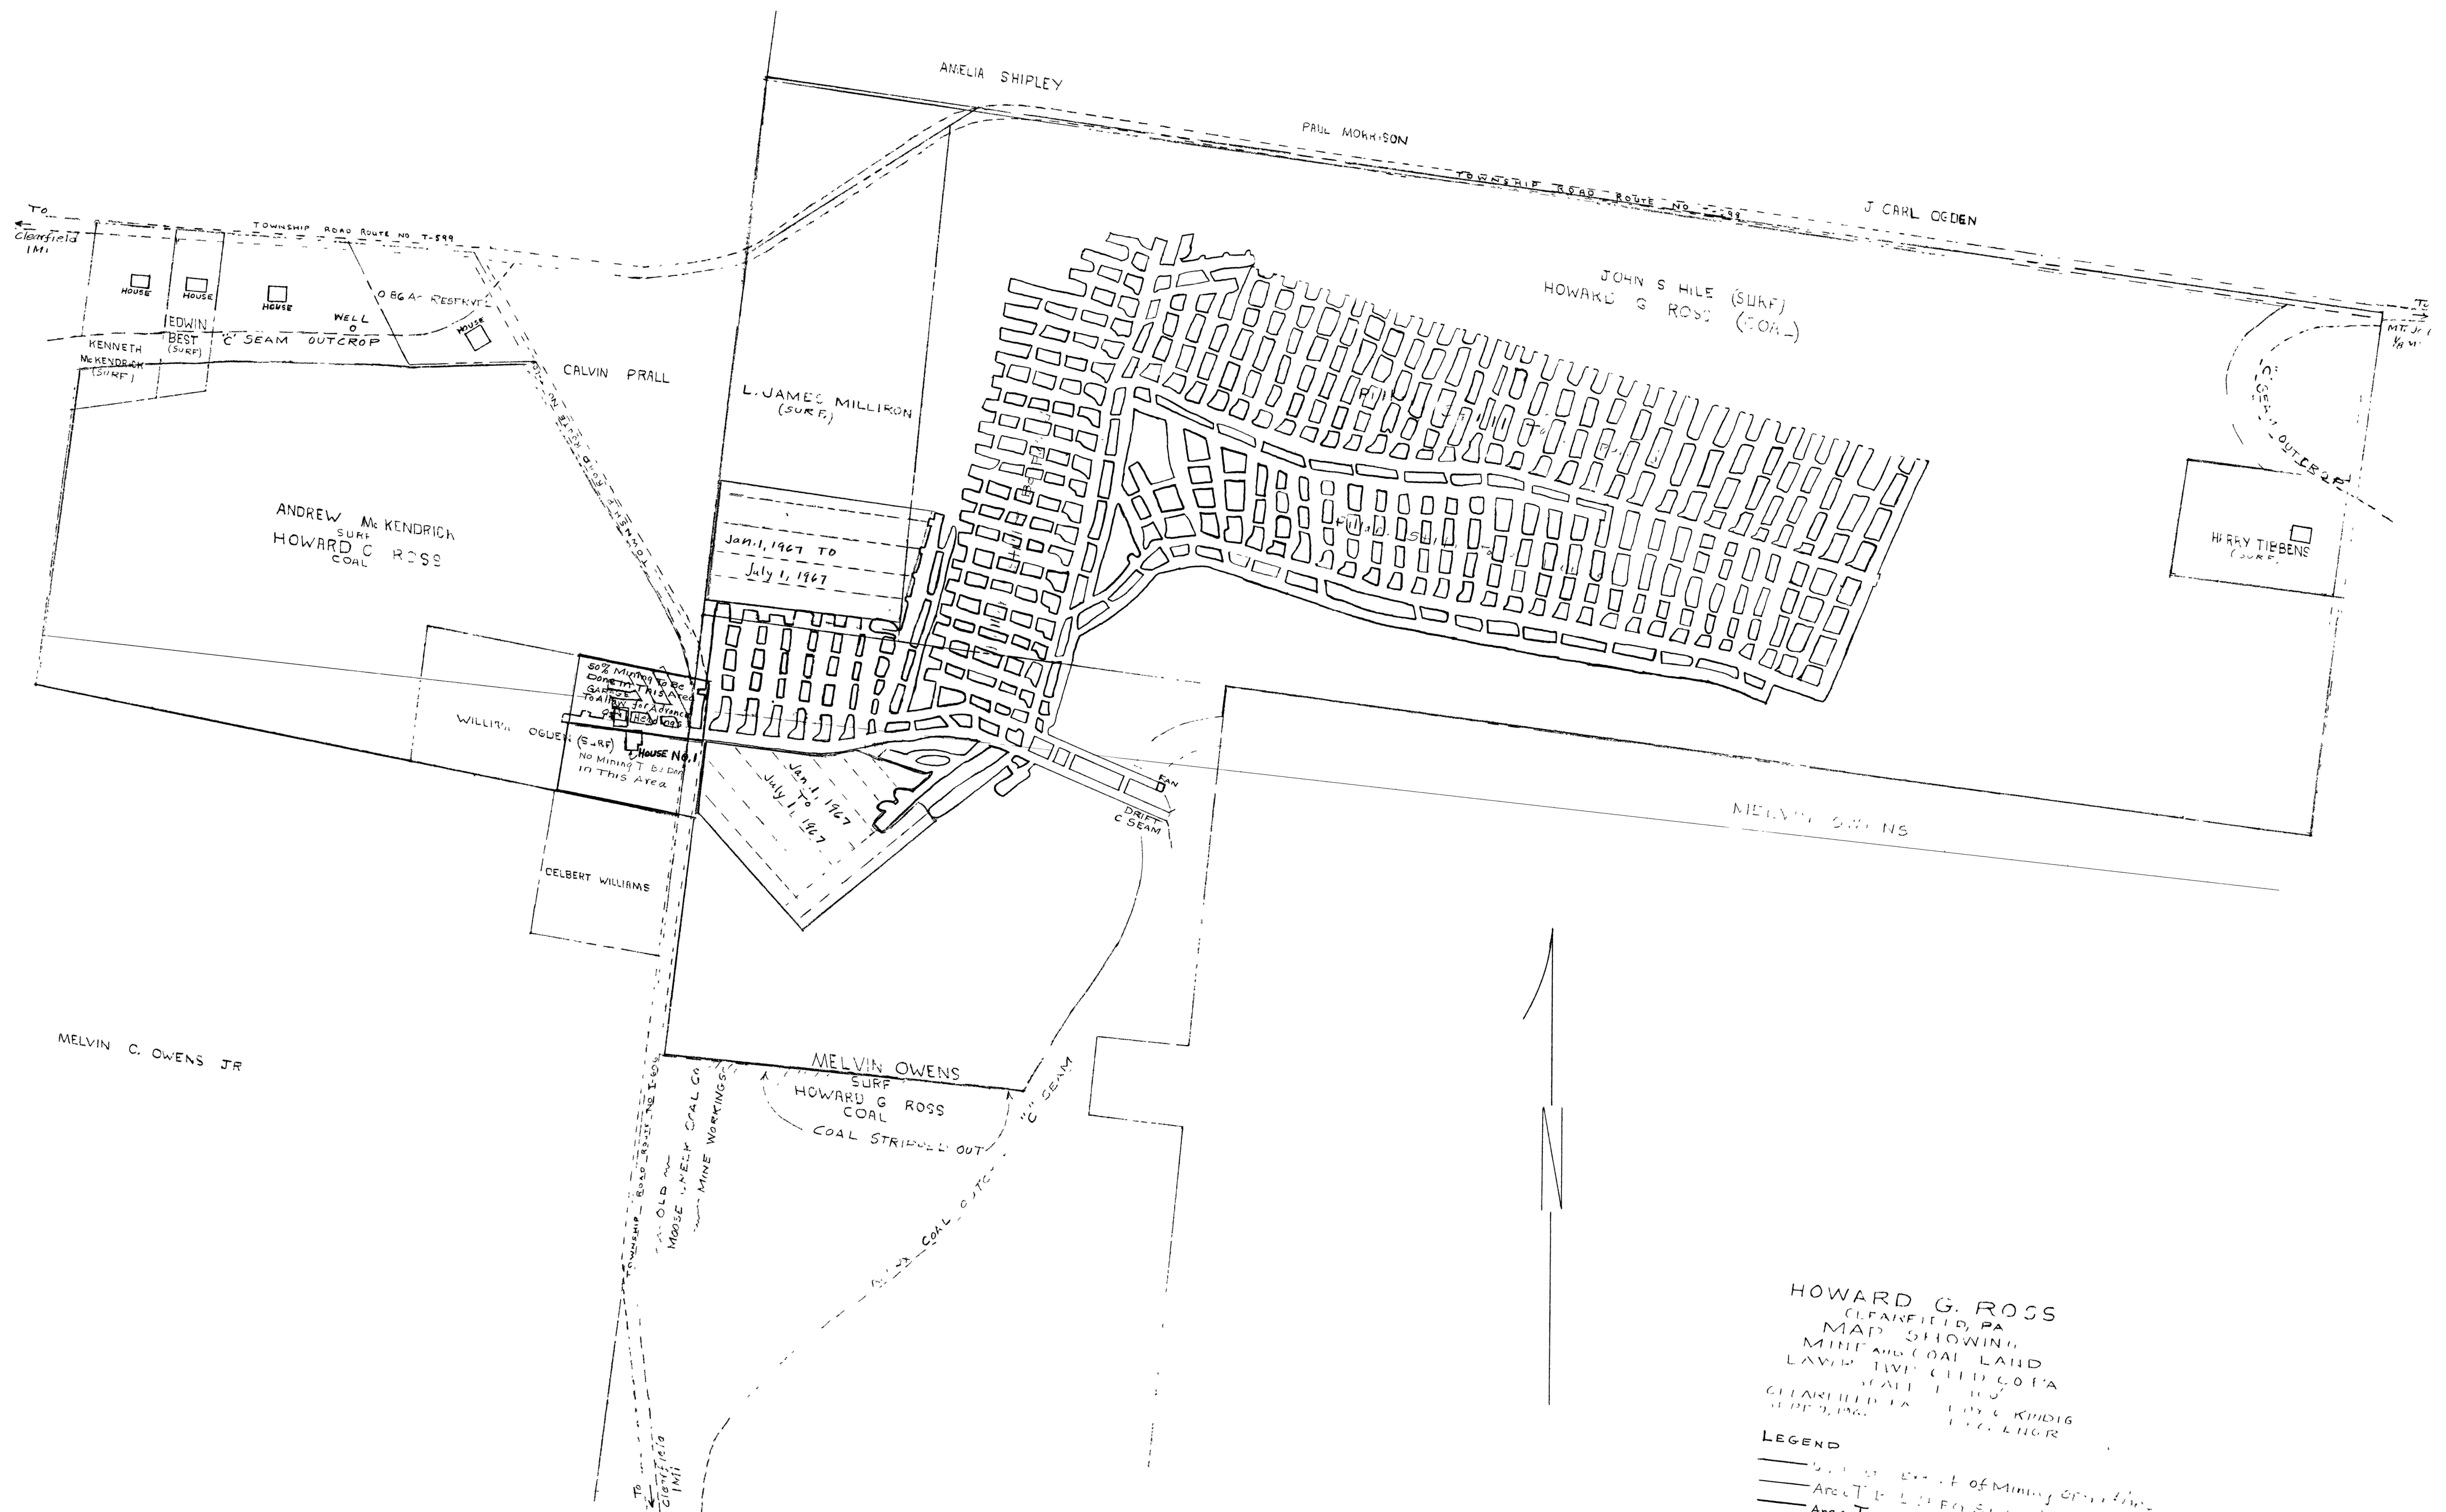

HOWARD G. ROSS
CLEARFIELD, PA
MAP SHOWING
MINE AND COAL LAND

LEGEND

- Area To Be Left For Support - 50% Mining
- Area of Mining For The 1st 6mo 4 Each Succeeding 6 Mo