
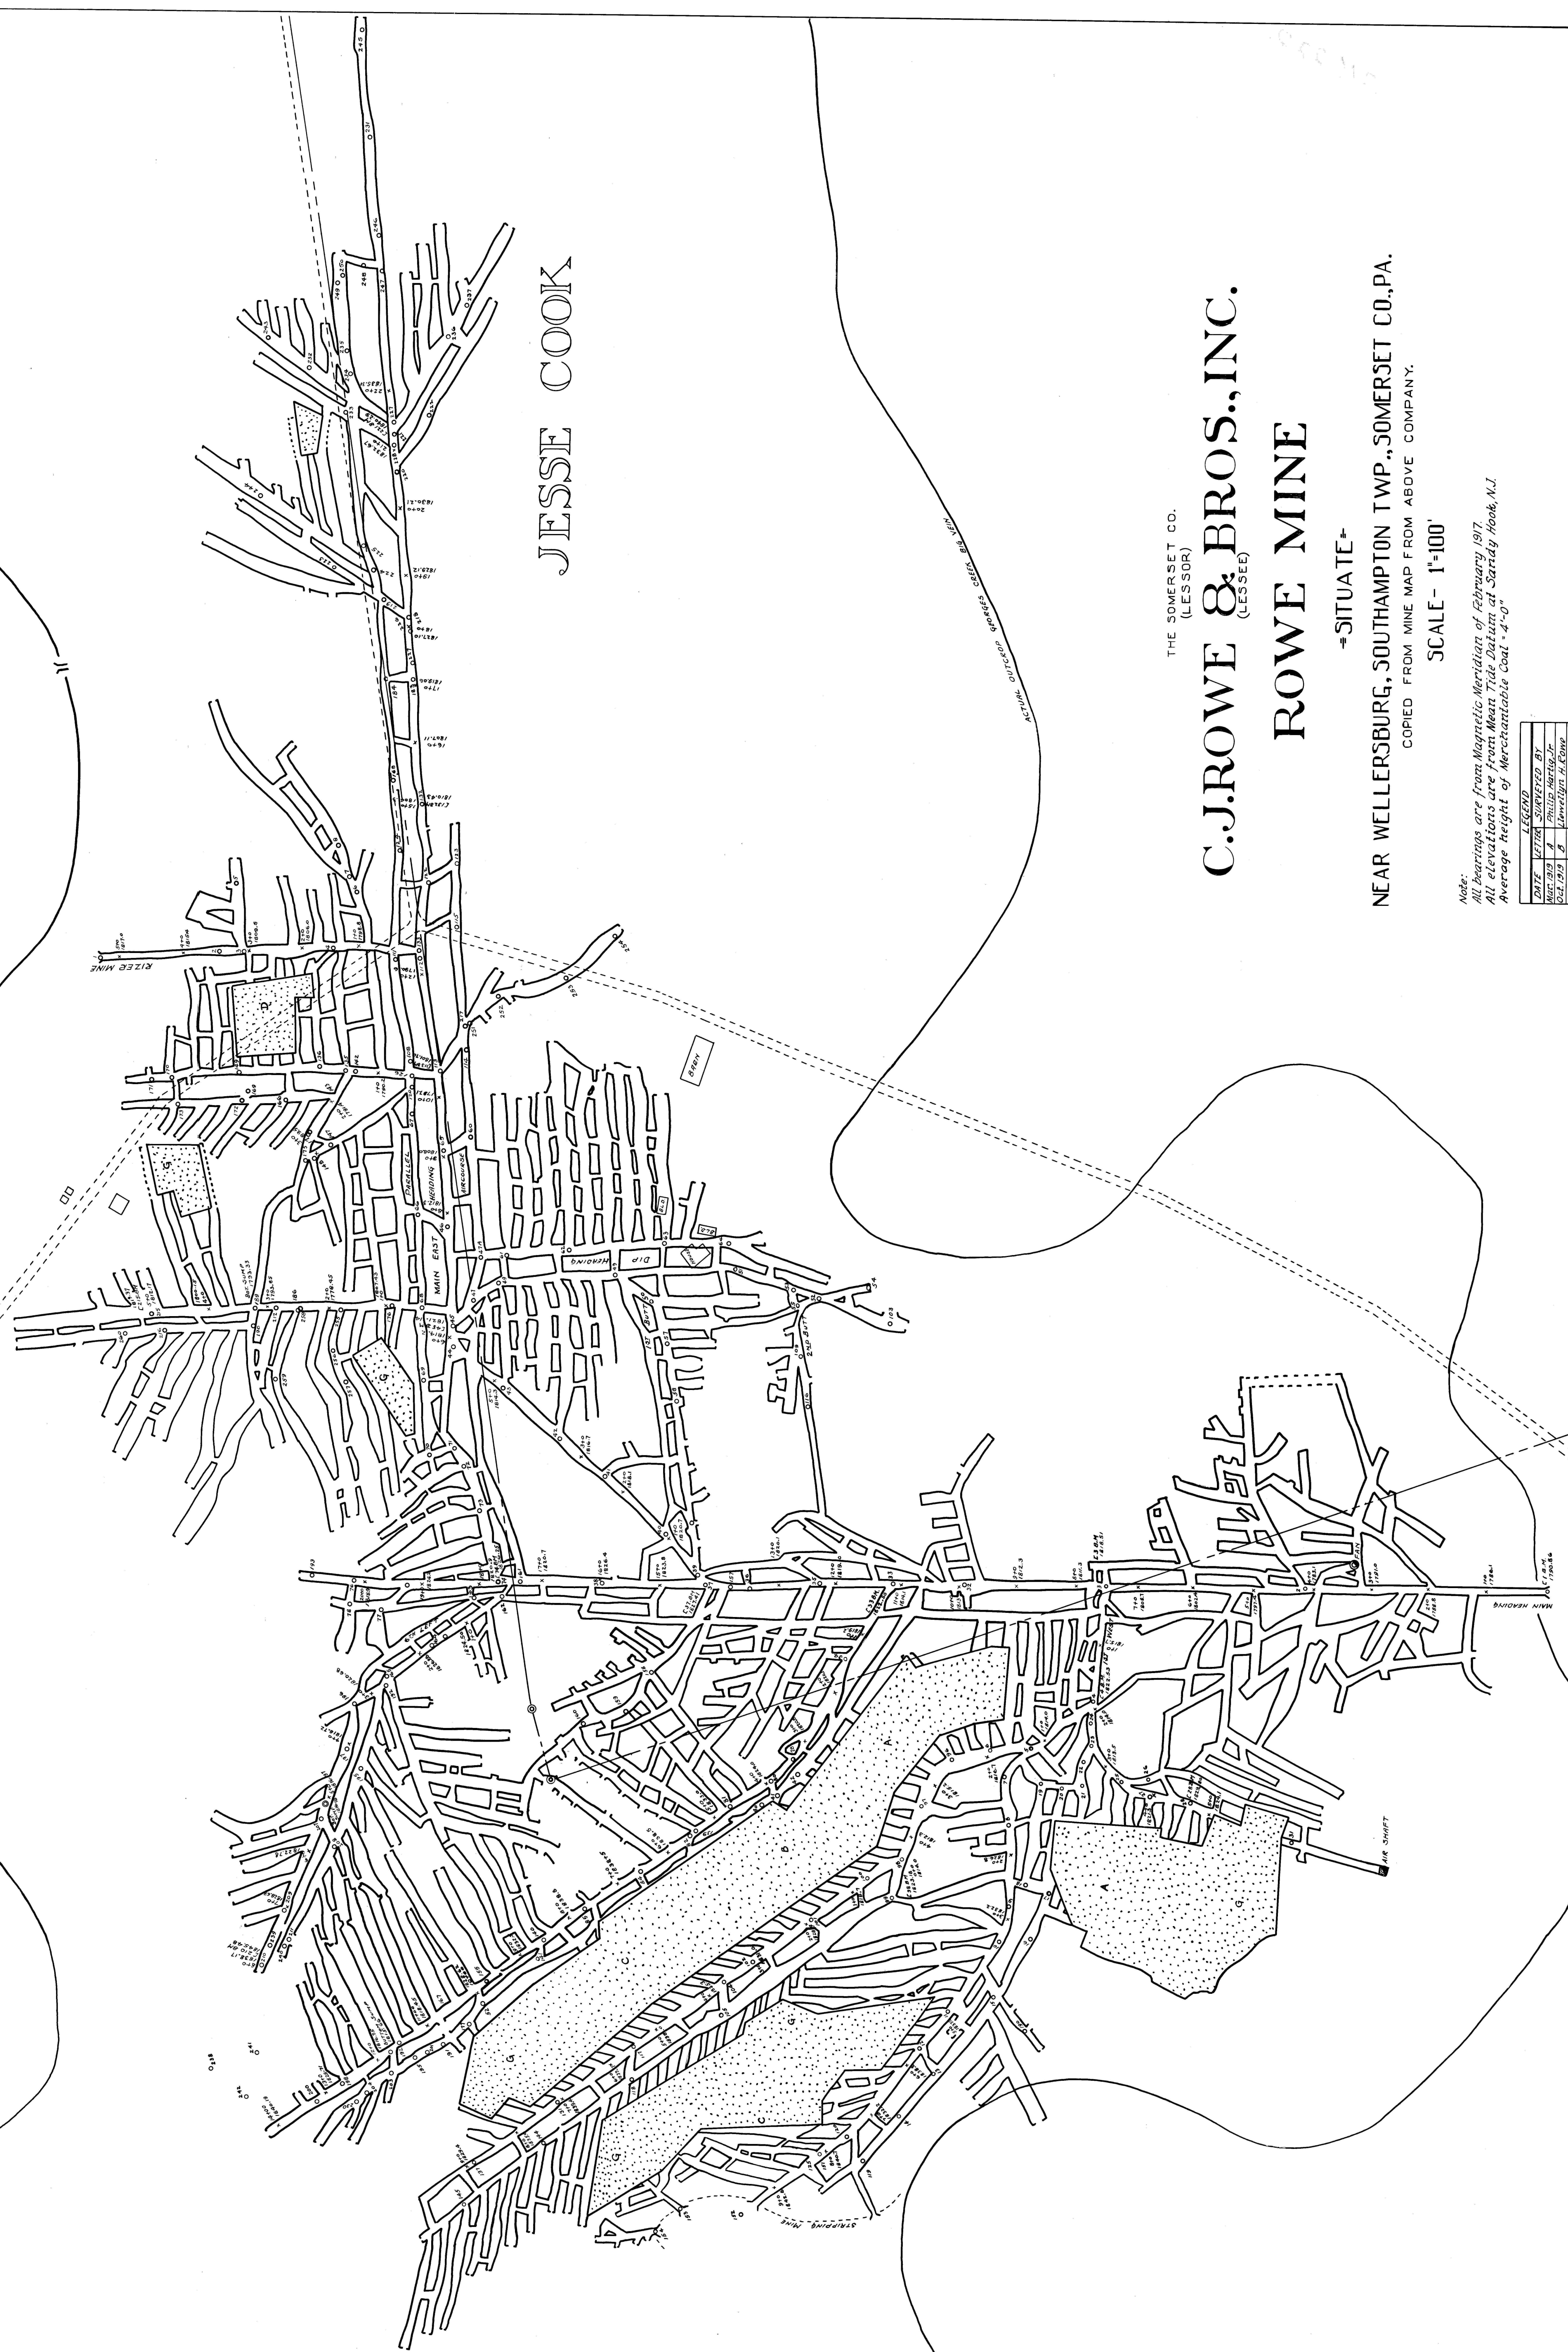


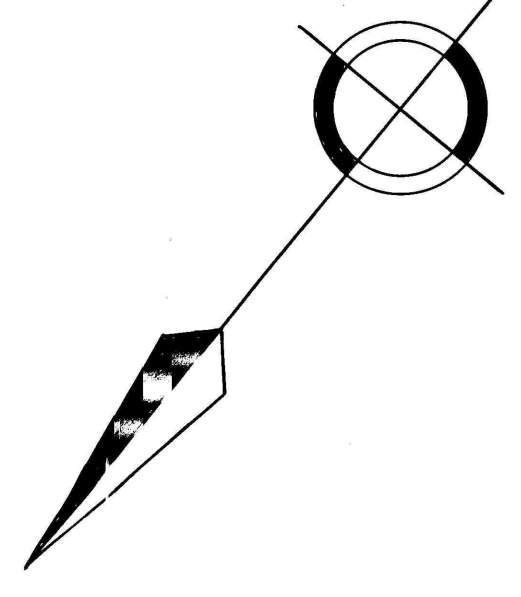

THE SOMERSET CO.
(LESSOR)
C.J. ROWE & BROS., INC.
(LESSEE)
ROWE MINE
-SITUATE-
NEAR WELLERSBURG, SOUTHAMPTON TWP., SOMERSET CO., PA.
COPIED FROM MINE MAP FROM ABOVE COMPANY.
SCALE - 1"=100'

Note:
All bearings are from Magnetic Meridian of February 1917.
All elevations are from Mean Tide Datum at Sandy Hook, N.J.
Average height of Meridional Cont. = 40'

LEGEND		BY
DATE	VERIFIED	DATE
MAY 1917	A	THOMAS M. ROWE, JR.
JUL 1917	B	WILLIAM A. ROWE
SEP 1917	C	"
NOV 1917	D	"
JAN 1918	E	"
MAR 1918	F	"
MAY 1918	G	"