


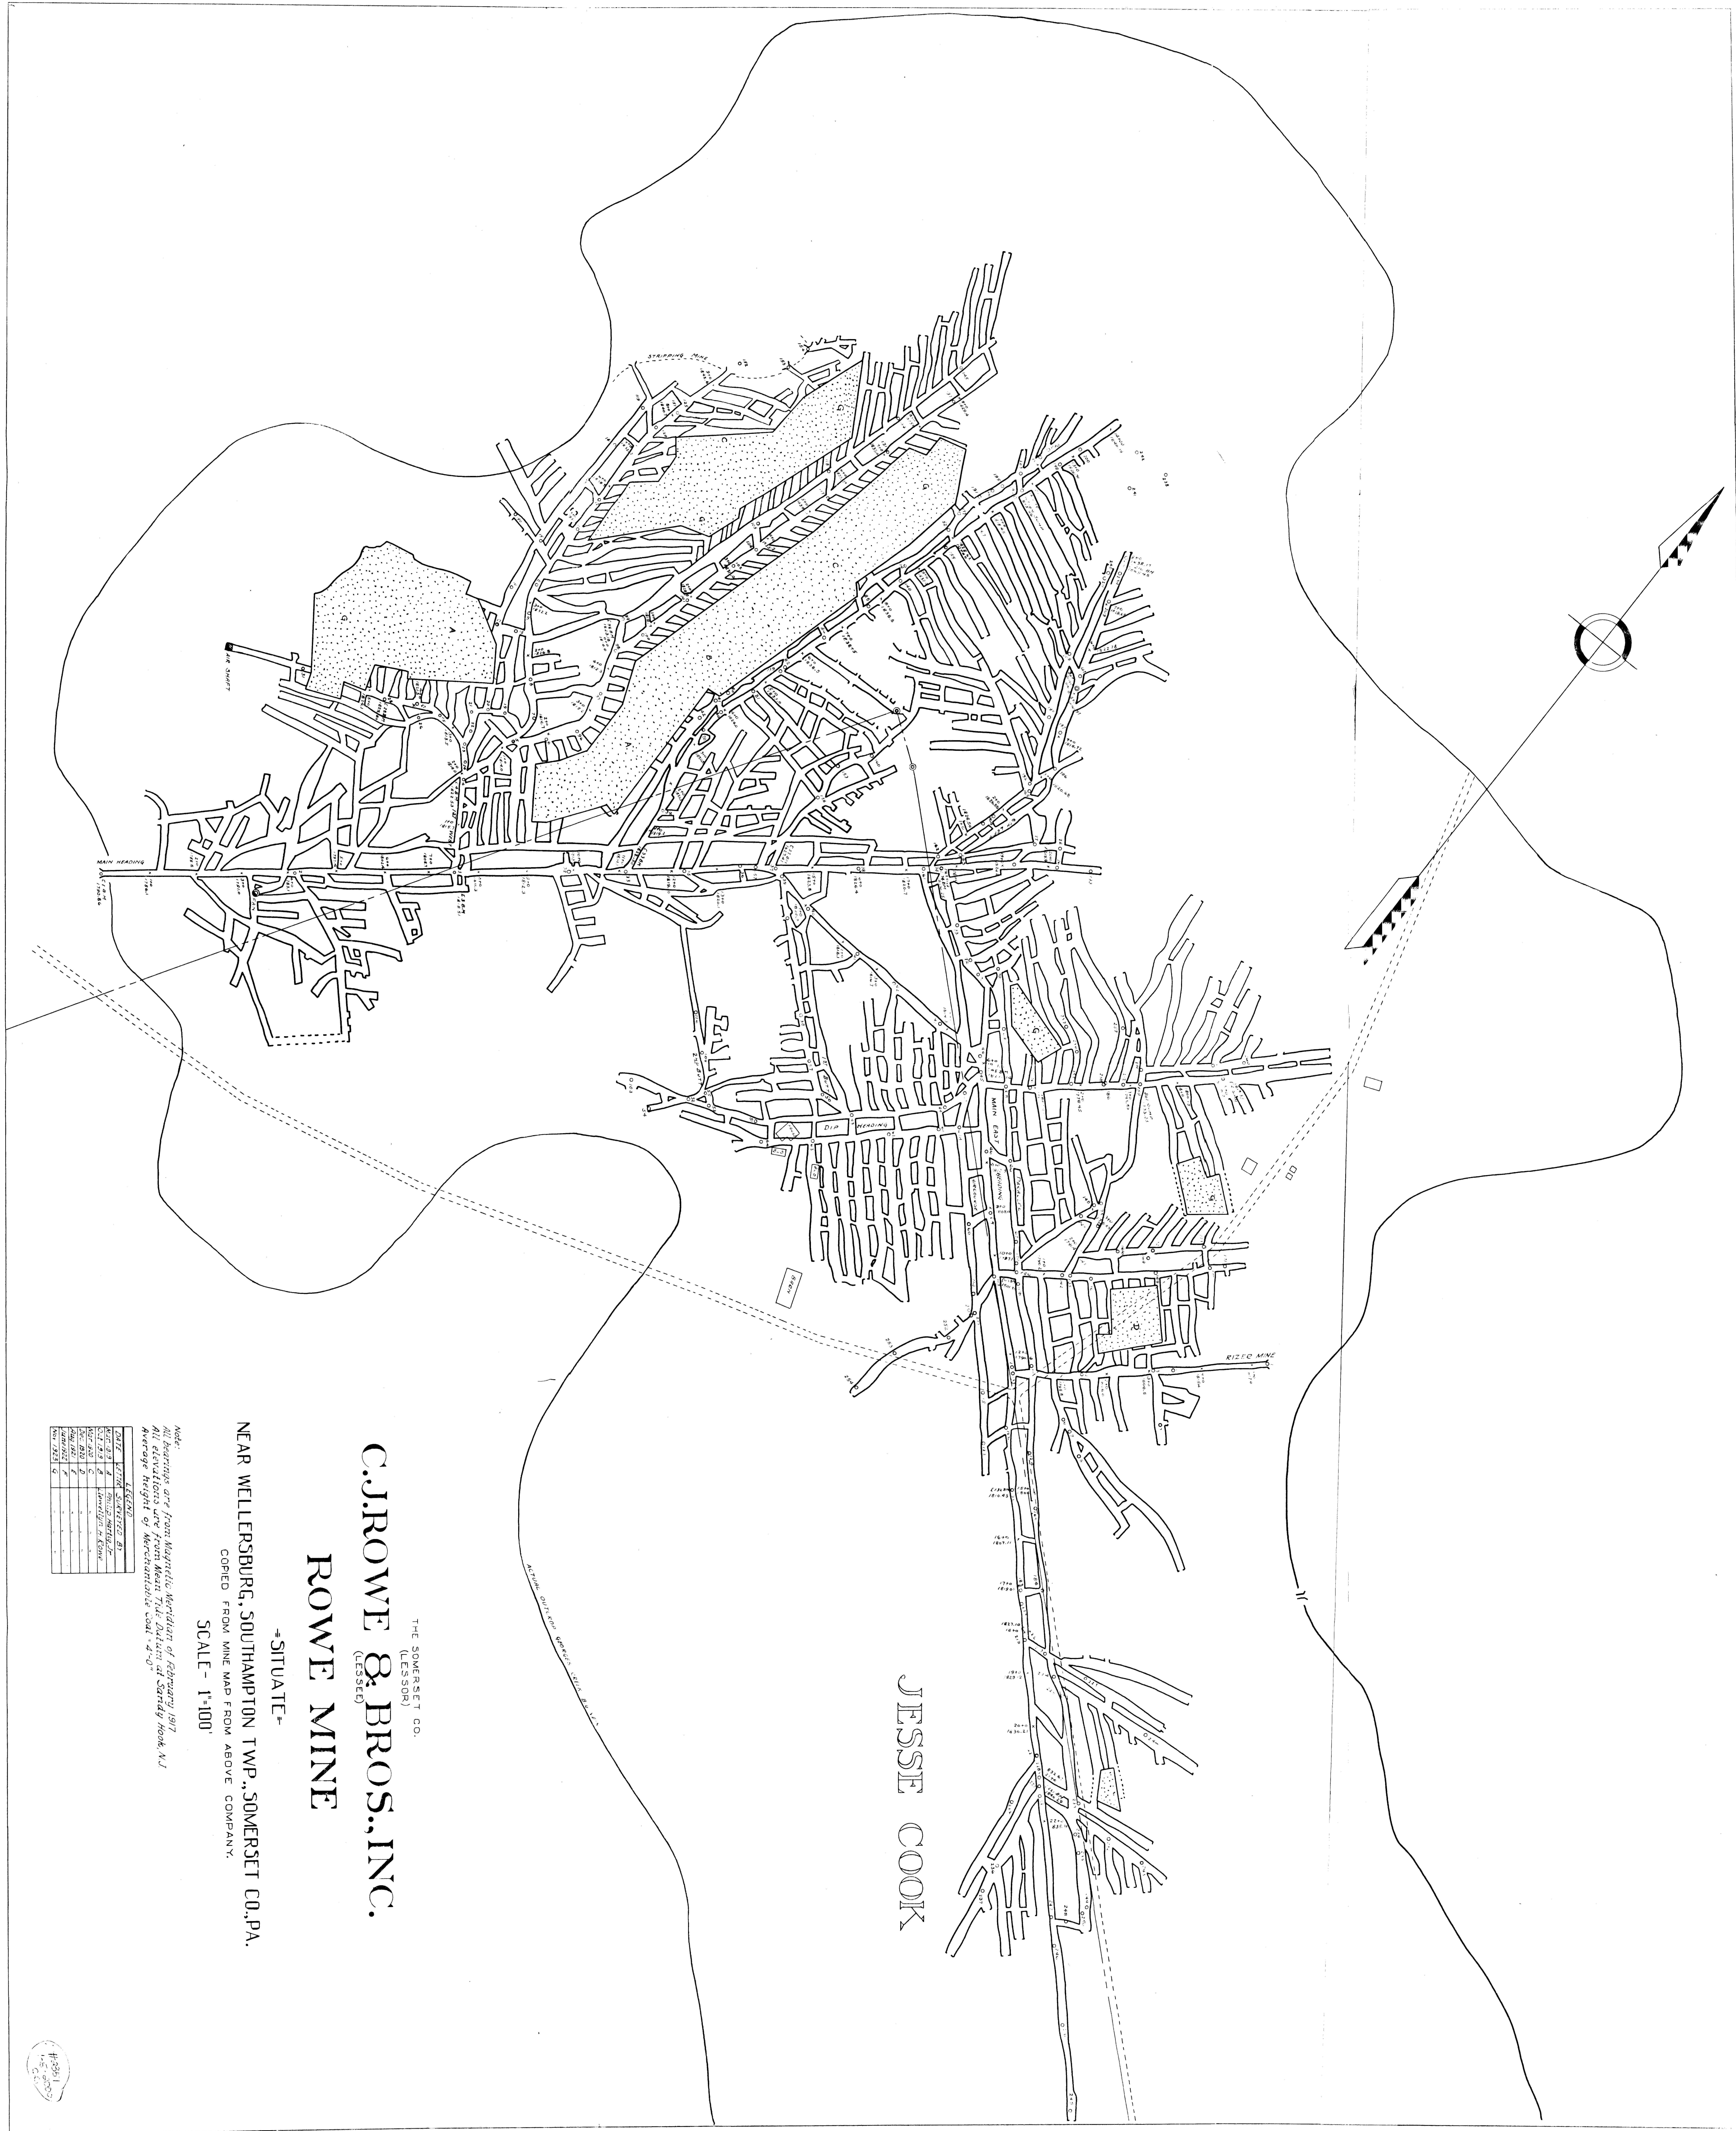

JESSE COOK

THE SOMERSET CO.
(LESSOR)
C.J. ROWE & BROS., INC.
(LESSEE)
ROWE MINE
-SITUATE-
NEAR WELLESBURG, SOUTHAMPTON TWP., SOMERSET CO., PA.
COPIED FROM MINE MAP F.R.O.W. ABOVE COMPANY.
SCALE - 1"=100'

Note:
All bearings are from Magnetic Meridian of February 1917
and are given in degrees, minutes and seconds.
Average height of Mercantile coal - 4'-0"

DATE		WITH	REMARKS
Oct. 2, 1917	4	Surveyed by	Rowe
Oct. 2, 1917	4	Surveyed by	Rowe
