


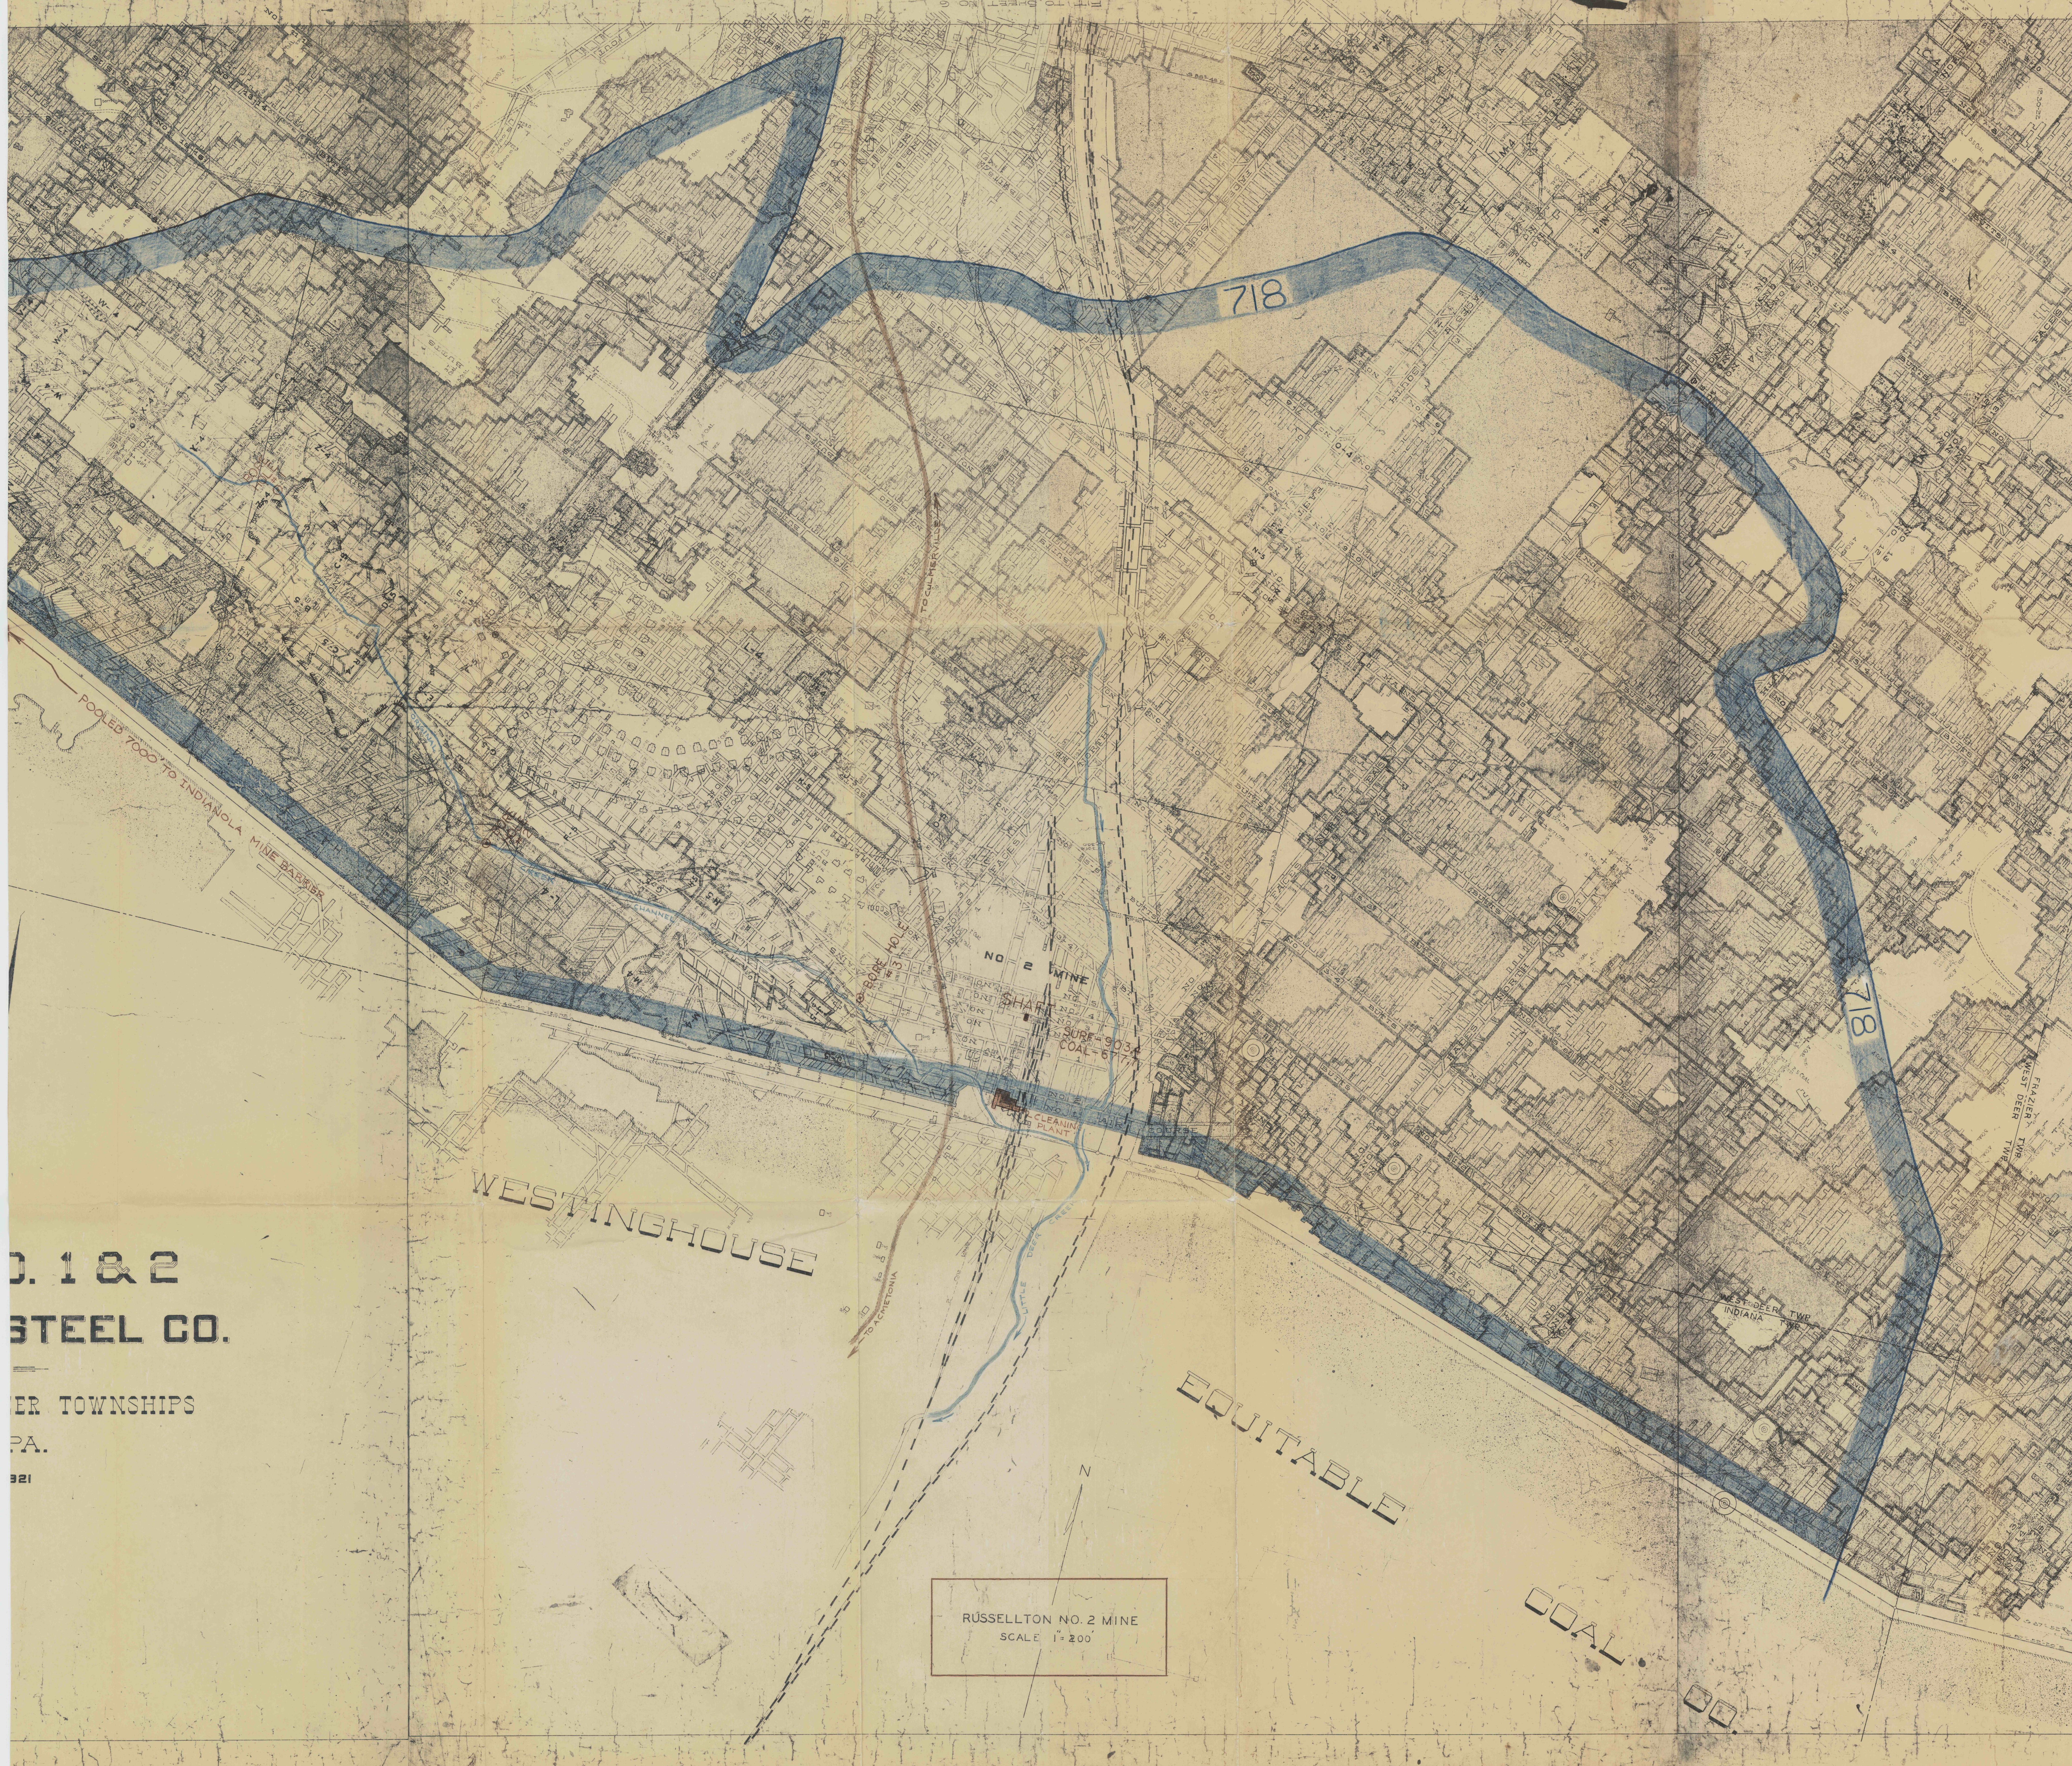

D. 1 & 2
STEEL CO.

ER TOWNSHIPS
PA.
321

RUSSELLTON NO. 2 MINE
SCALE 1" = 200'