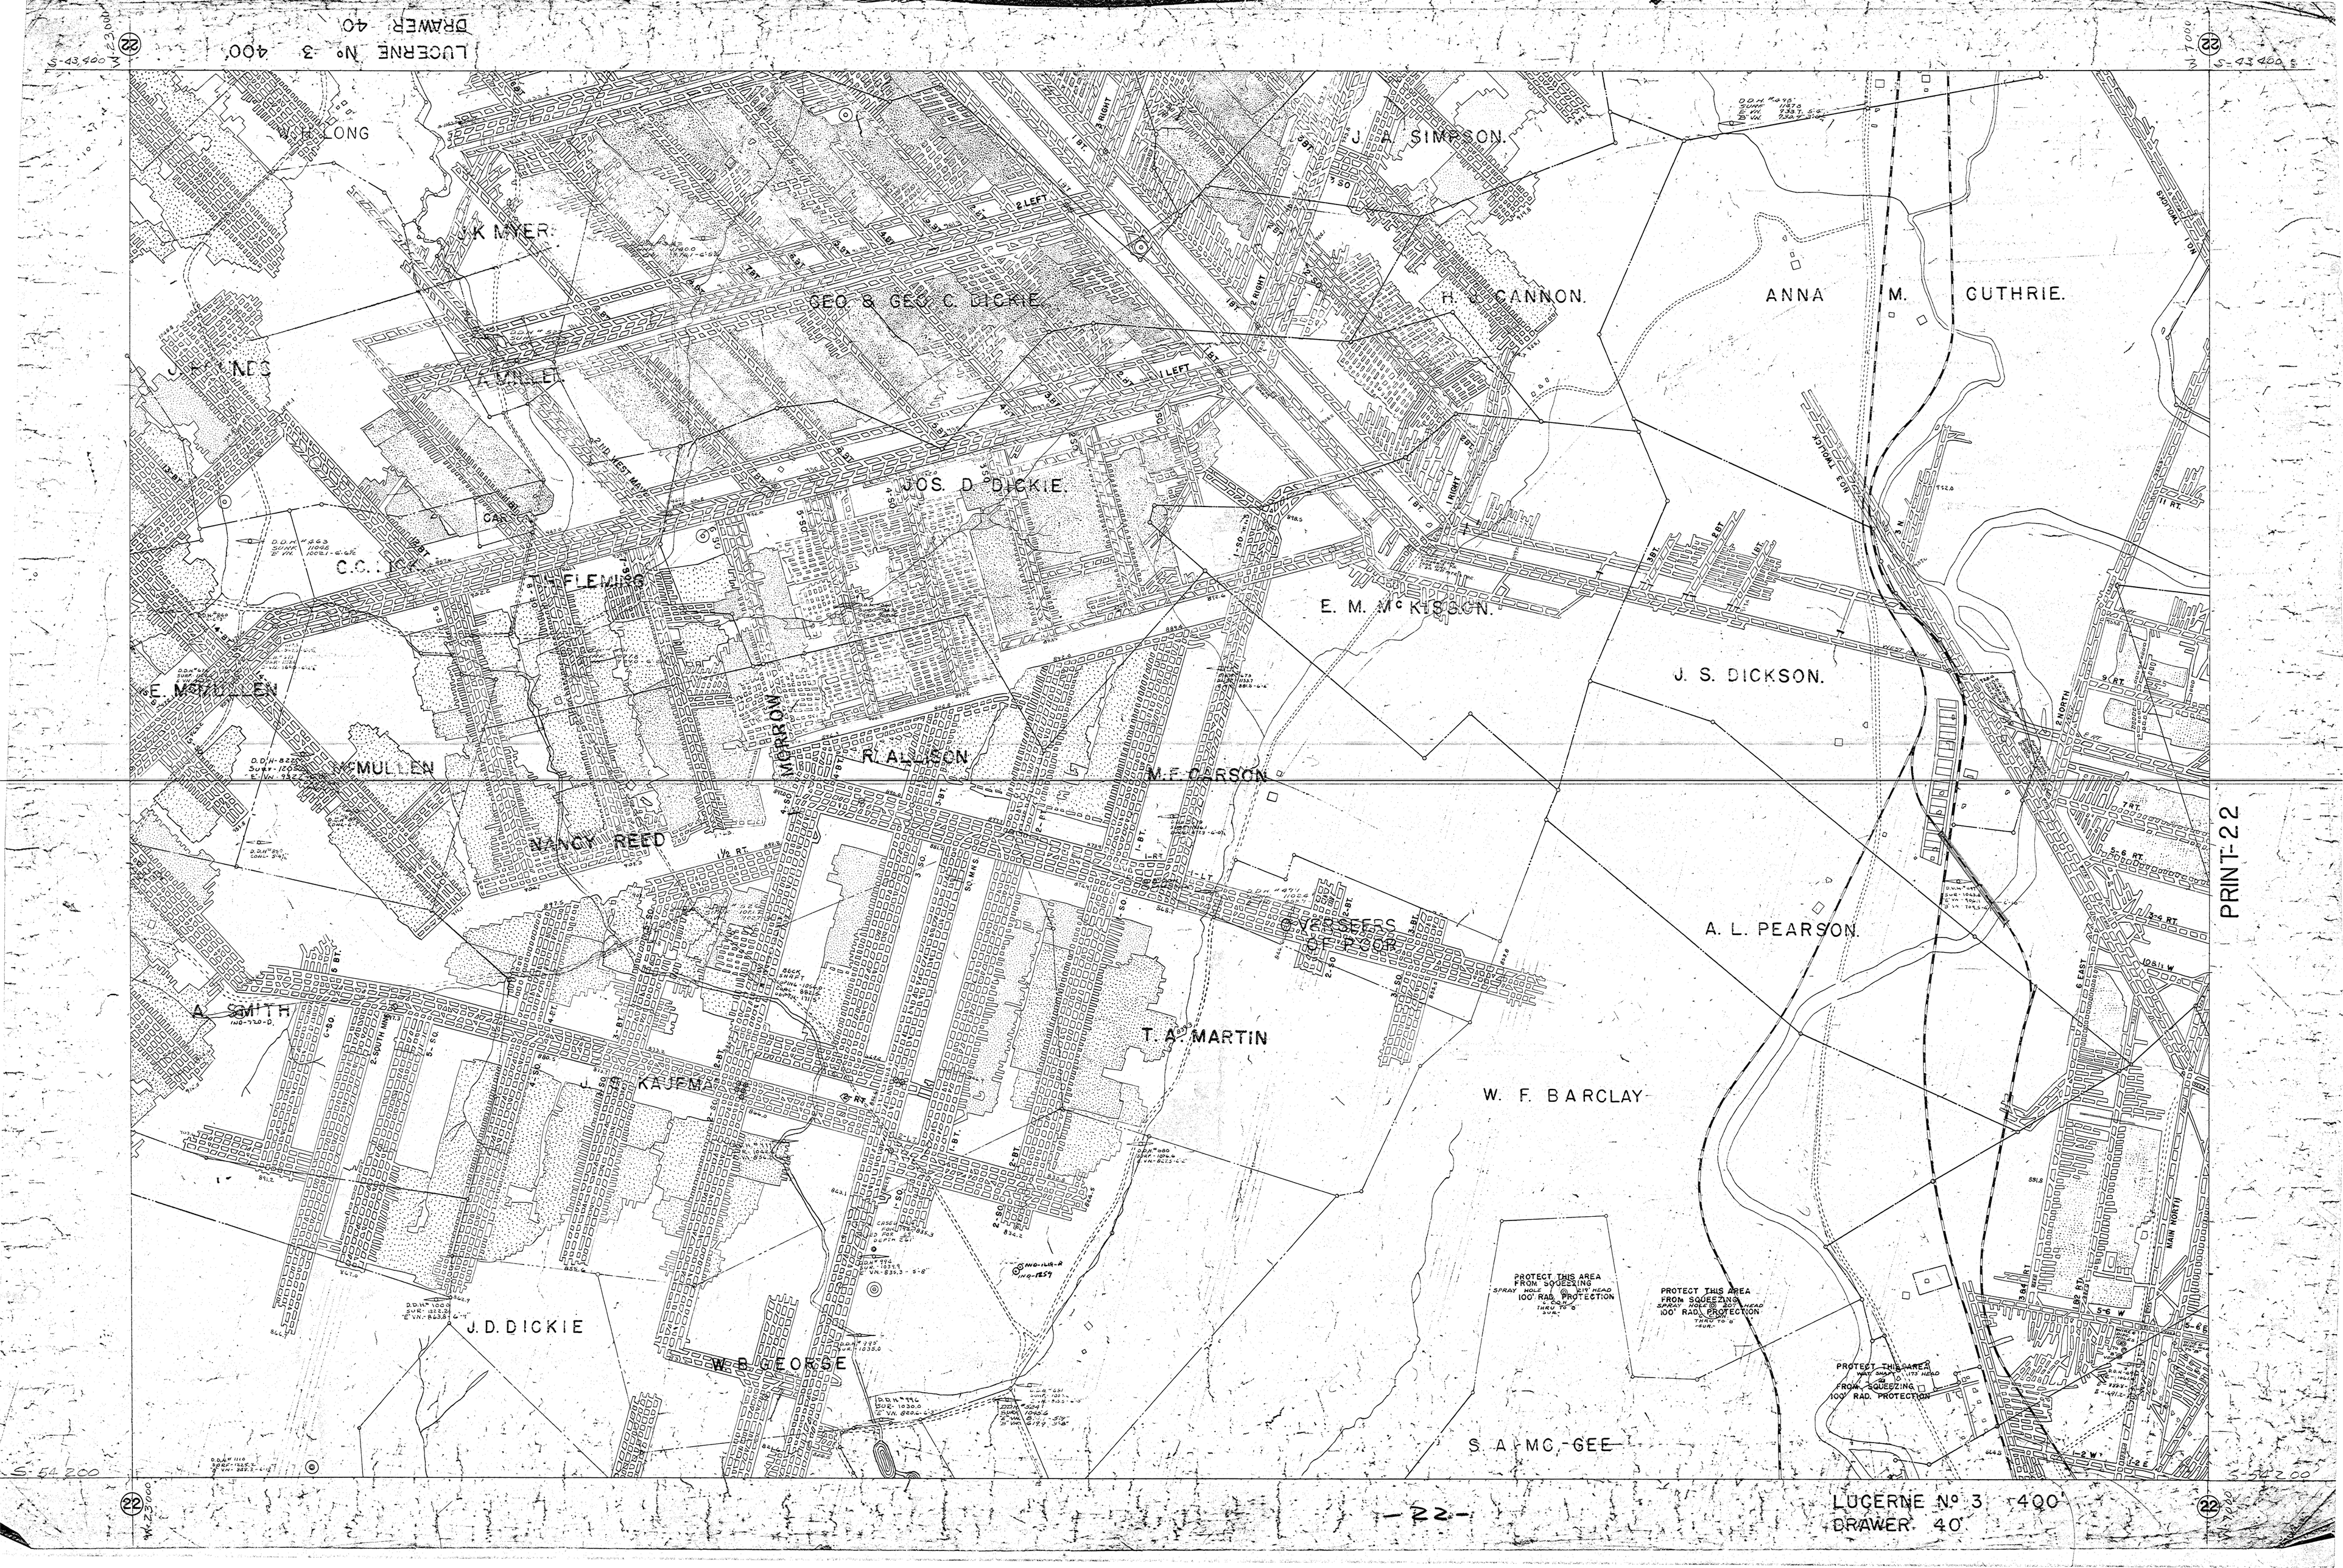
LUCERNE No 3 400'
DRAWER 40
W. H. LONG
J. K. MYER
GEO. & GEO. C. DICKIE
J. A. SIMPSON
H. J. CANNON
ANNA M. GUTHRIE
A. MILLER
JOS. D. DICKIE
C. C. LICK
TH. FLEMING
E. M. McKISSON
J. S. DICKSON
E. McMULLEN
McMULLEN
MORROW
R. ALLISON
M. F. CARSON
NANCY REED
OVERSEERS OF POOR
A. L. PEARSON
A. SMITH
T. A. MARTIN
J. A. KAUFMAN
W. F. BARCLAY
J. D. DICKIE
W. B. GEORGE
S. A. McGEE
PROTECT THIS AREA FROM SQUEEZING 100' RAD. PROTECTION
PROTECT THIS AREA FROM SQUEEZING 100' RAD. PROTECTION
PROTECT THIS AREA FROM SQUEEZING 100' RAD. PROTECTION
PRINT-22
LUCERNE No 3 400'
DRAWER 40'