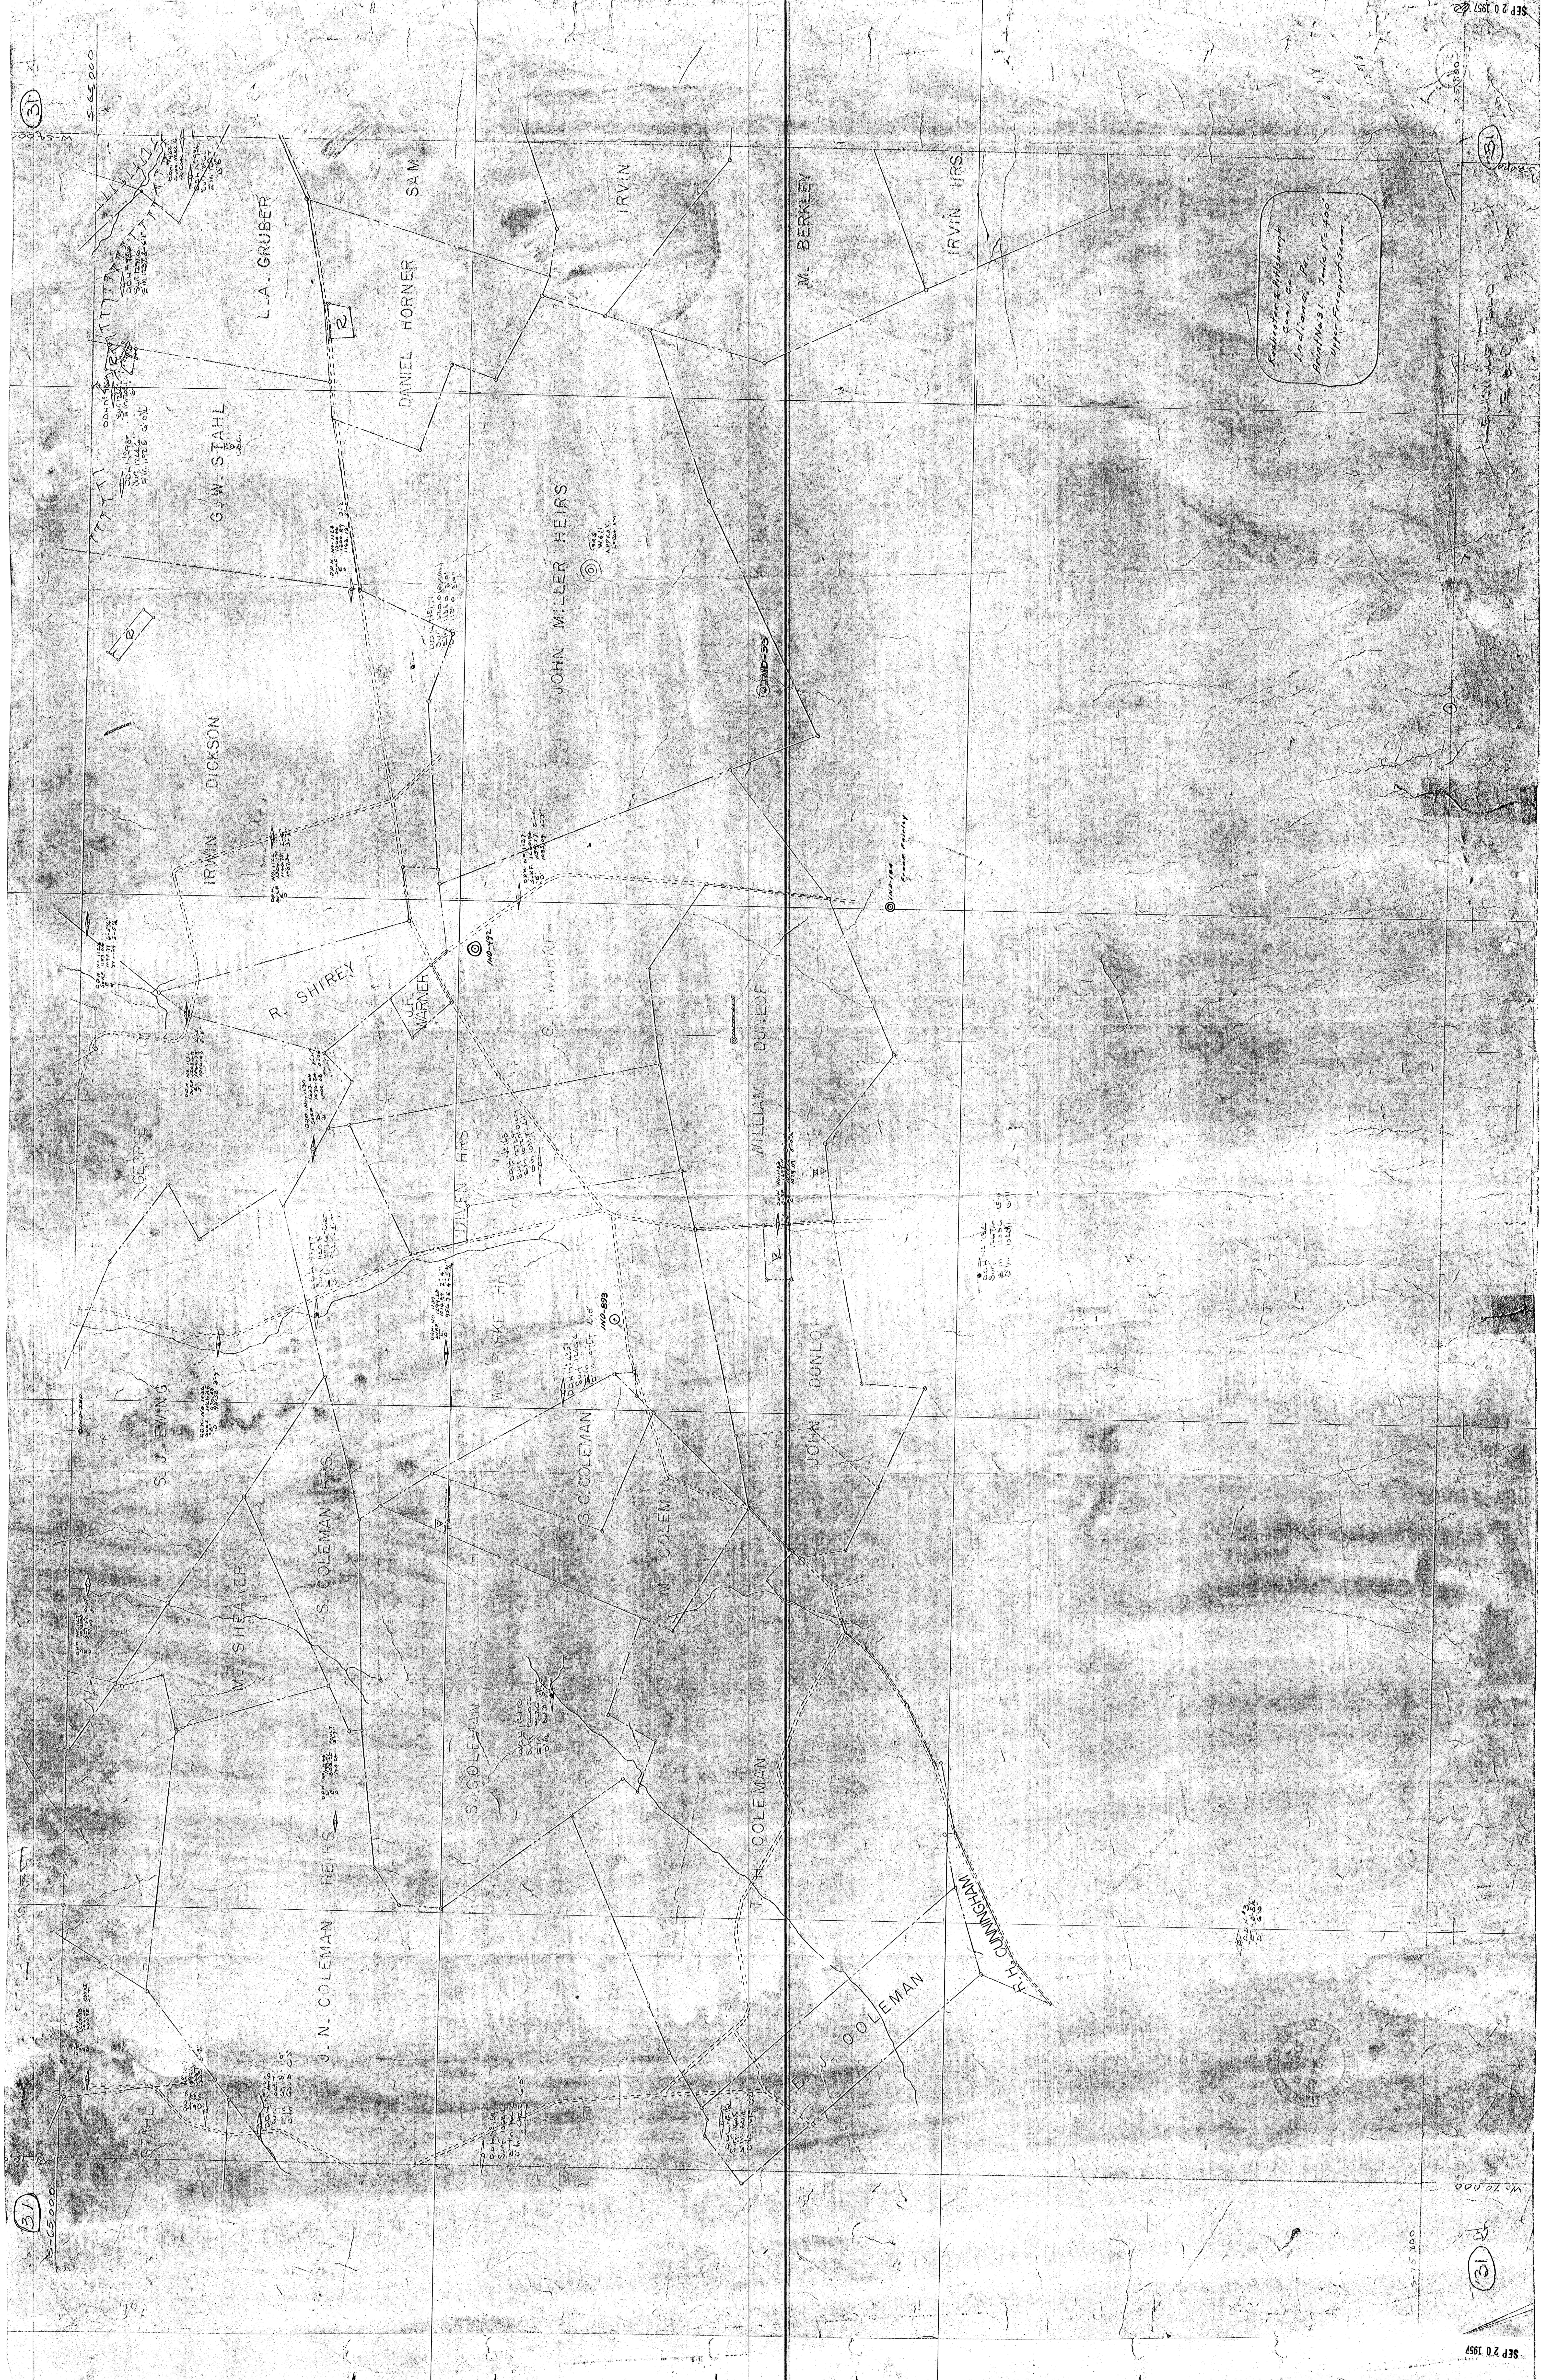

Rochester & Pittsburgh
Coal Co.
Indiana, Pa.
Print No 31 Scale 1"=400'
Upper Freeport Seam.