


LEGEND

FEE COAL
GROUP 1, 1946 LEASE
GROUP 2, 1946
TRACT 1, 1951
TRACT 3, 1951
LEASED TO COON RUN COAL CO.

★ DIAMOND DRILL HOLES

Map No.	Rec. No.	R.H.C.M.C.
6	9	R.H.C.M.C.
9	10	R.H.C.M.C.
10	11	R.H.C.M.C.
11	17	R.H.C.M.C.
17	19	R.H.C.M.C.
19	20	R.H.C.M.C.
20	23	R.H.C.M.C.
23	24	R.H.C.M.C.
24	38	R.H.C.M.C.
38	39	R.H.C.M.C.
39	40	R.H.C.M.C.
40	41	R.H.C.M.C.
41	42	R.H.C.M.C.
42	43	R.H.C.M.C.
43	44	R.H.C.M.C.
44	267	C.T.C.C.
45	268	C.T.C.C.
46	269	C.T.C.C.
47	270	C.T.C.C.
48	271	C.T.C.C.
49	272	C.T.C.C.
50	273	C.T.C.C.
51	274	C.T.C.C.
52	275	C.T.C.C.
53	276	C.T.C.C.
54	277	C.T.C.C.
55	278	C.T.C.C.
56	279	C.T.C.C.
57	280	C.T.C.C.
58	281	C.T.C.C.
59	282	C.T.C.C.
60	283	C.T.C.C.
61	284	C.T.C.C.
62	285	C.T.C.C.
63	286	C.T.C.C.
64	287	C.T.C.C.
65	288	C.T.C.C.
66	289	C.T.C.C.
67	290	C.T.C.C.
68	291	C.T.C.C.
69	292	C.T.C.C.
70	293	C.T.C.C.

WATKINS COAL COMPANY
NO. 17-E

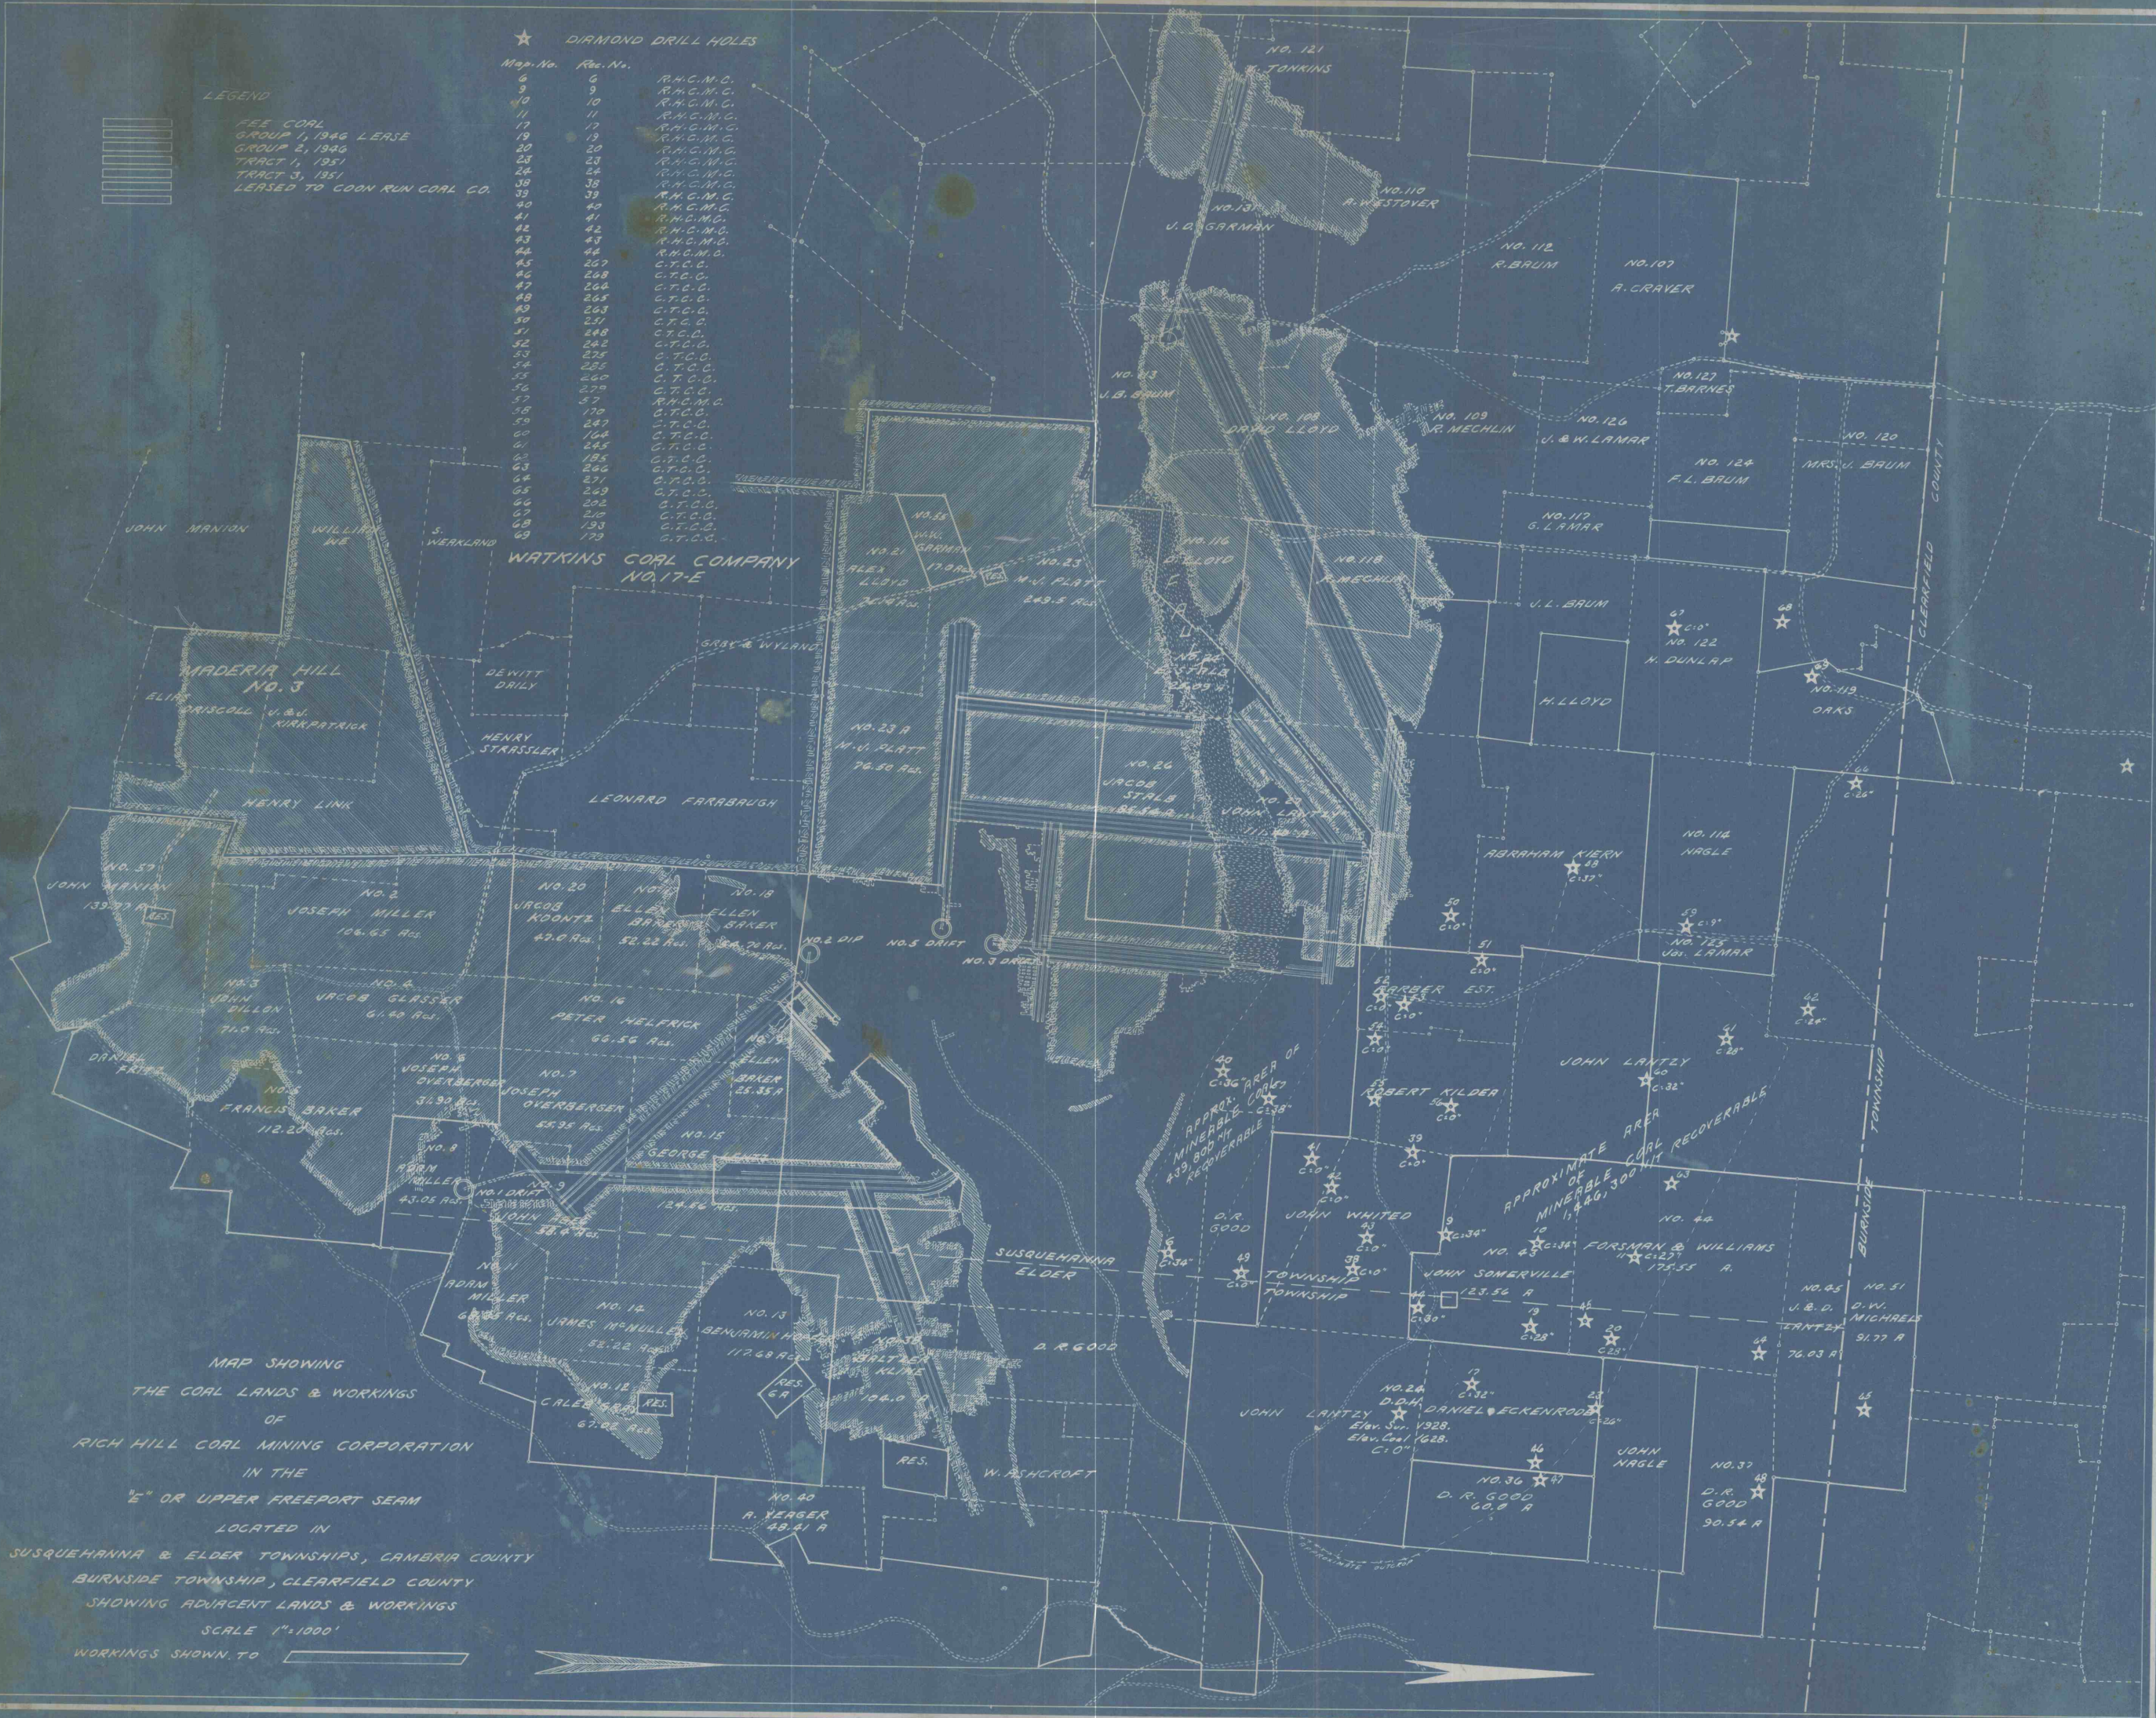

MAP SHOWING
THE COAL LANDS & WORKINGS
OF
RICH HILL COAL MINING CORPORATION
IN THE
1/2" OR UPPER FREEPORT SEAM
LOCATED IN
SUSQUEHANNA & ELDER TOWNSHIPS, CAMBRIA COUNTY
BURNSIDE TOWNSHIP, CLEARFIELD COUNTY
SHOWING ADJACENT LANDS & WORKINGS
SCALE 1"=1000'
WORKINGS SHOWN TO