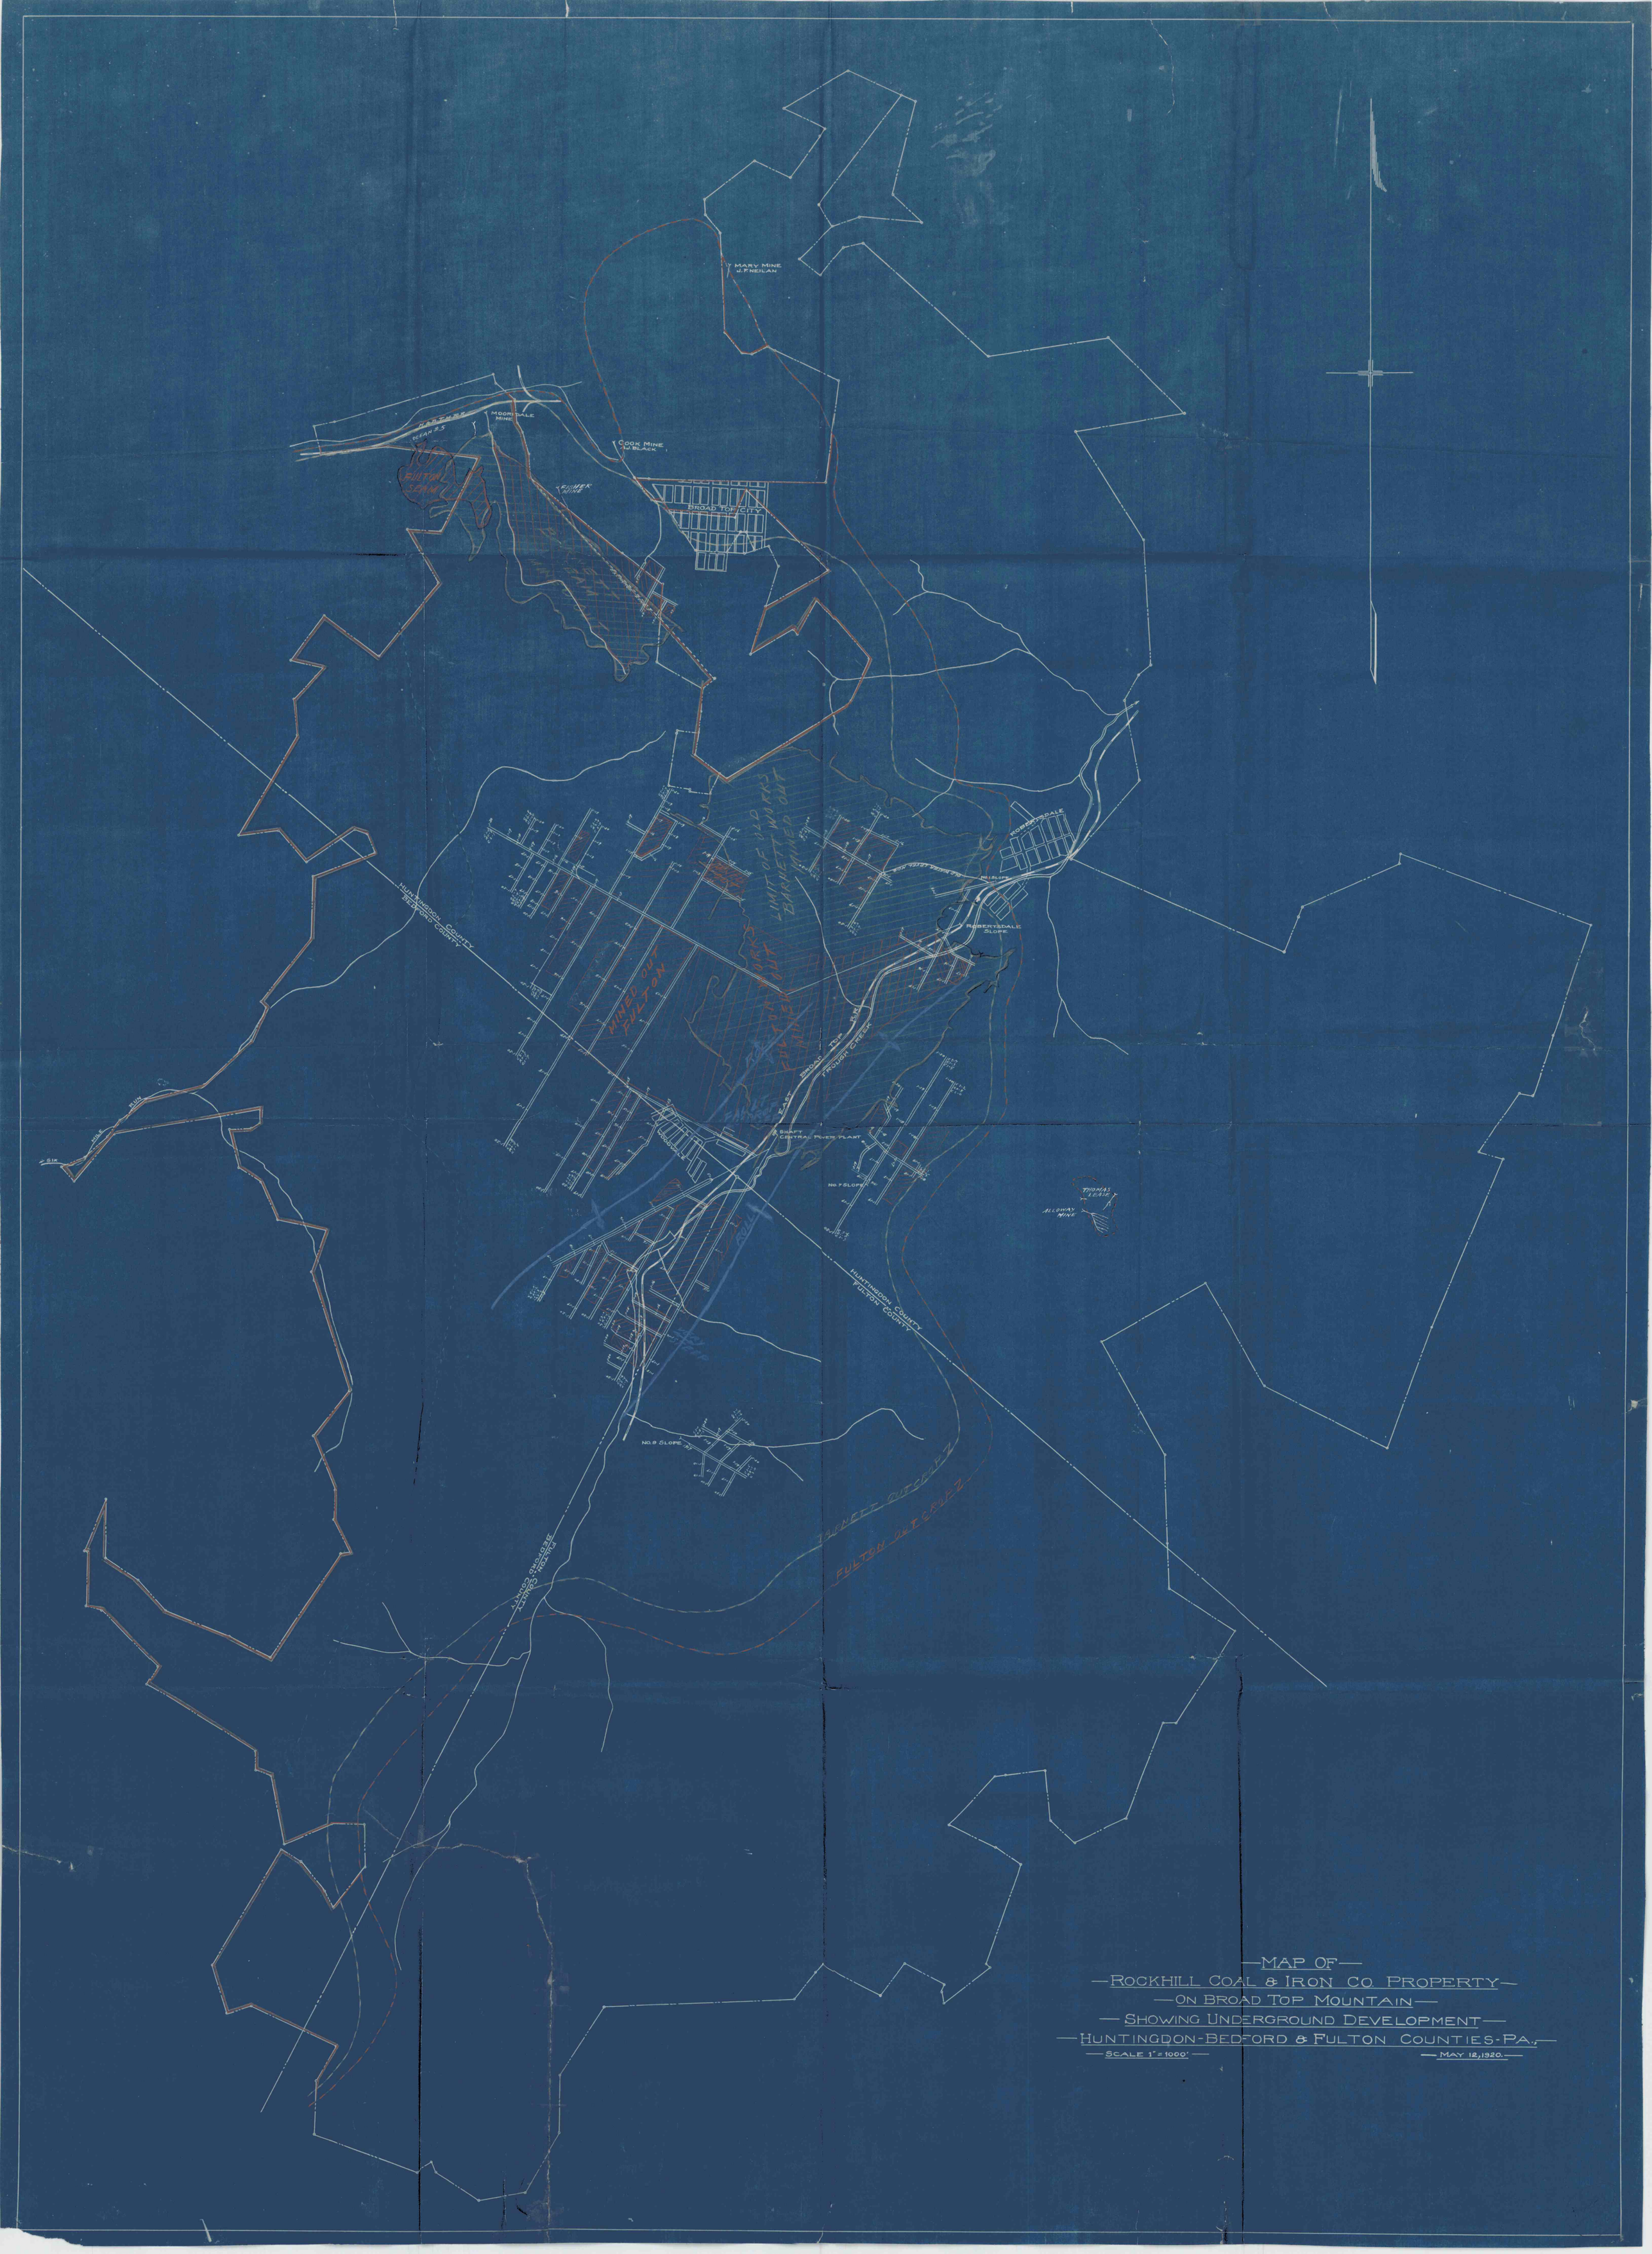
MARY MINE
J. F. NEILAN
MOORDALE MINE
COOK MINE
J. J. BLACK
BROAD TOP CITY
FULTON SEAM
FORMER MINE
ROBERTSDALE
ROBERTSDALE SLOPE
LIMIT OF OLD BARRETT WORKS MINED OUT
MINED OUT FULTON
EXTENSION OF OLD WORK
BROAD TOP RR
FROUGH CREEK
EAST
SHAFT
CENTRAL POWER PLANT
WOODVILLE
No. 7 SLOPE
THOMAS LEAR
ALLOWAY MINE
HUNTINGDON COUNTY
FULTON COUNTY
No. 8 SLOPE
BURNETT OUTCROPS
FULTON OUTCROPS
FULTON COUNTY
BEDFORD COUNTY
SIX
MAP OF
ROCKHILL COAL & IRON CO. PROPERTY
ON BROAD TOP MOUNTAIN
SHOWING UNDERGROUND DEVELOPMENT
HUNTINGDON-BEDFORD & FULTON COUNTIES-PA.
SCALE 1" = 1000'
MAY 12, 1920.