


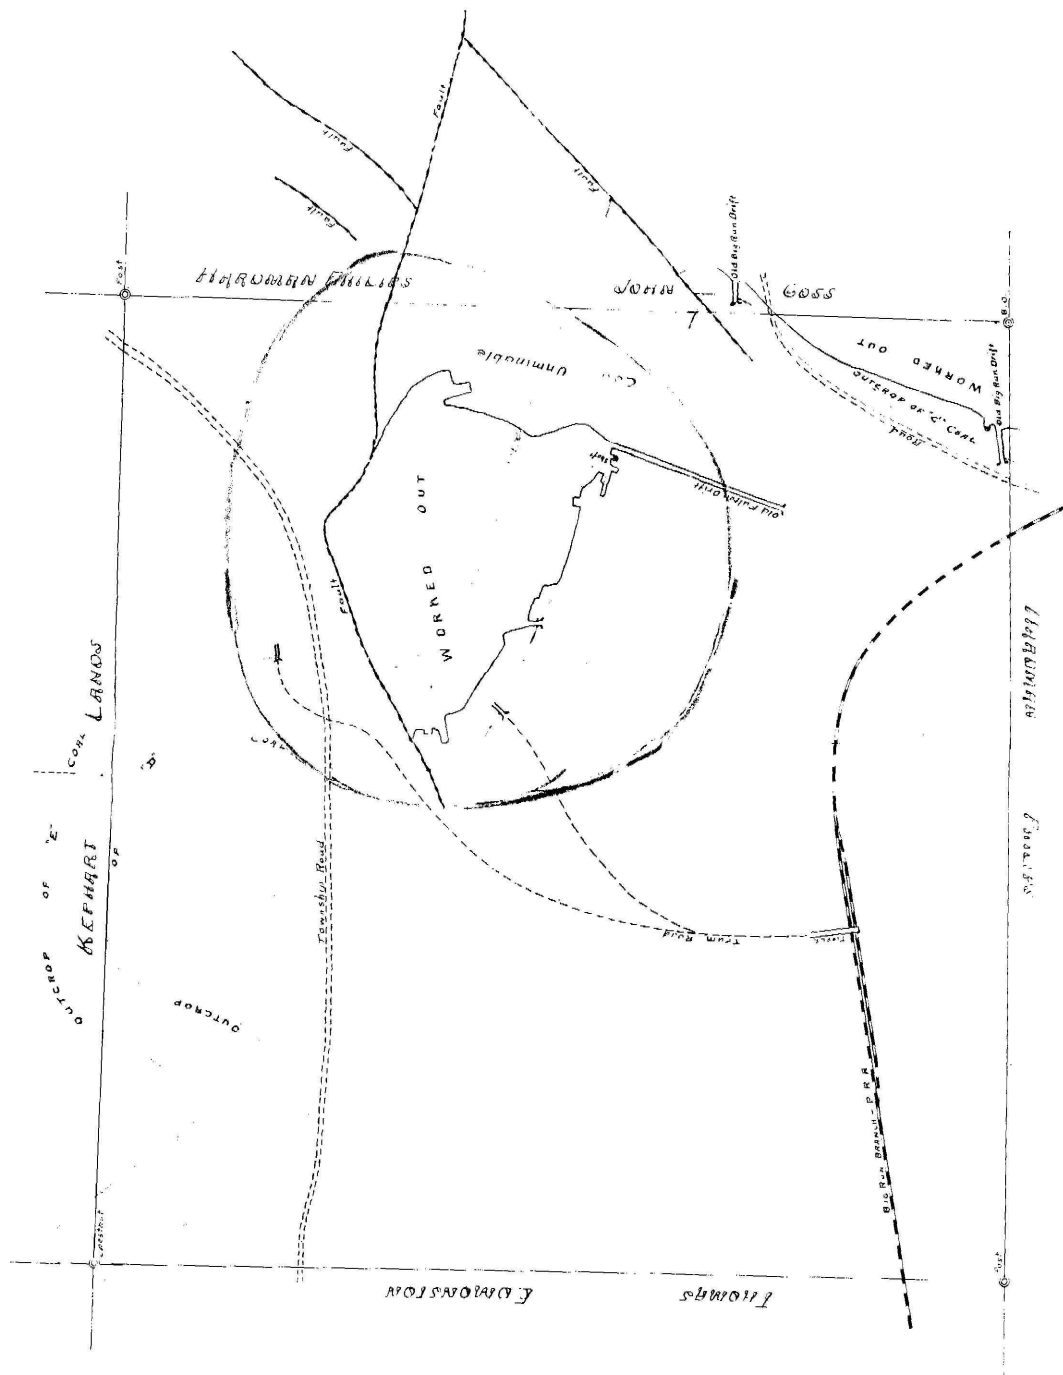

Map of Leasehold of the Rocky
Ledge Coal Company in Decatur
Township Clearfield County, Pa.

Scale 1"=200'

1920