


COAL OWNED BY B. & S. C. & C. CO.

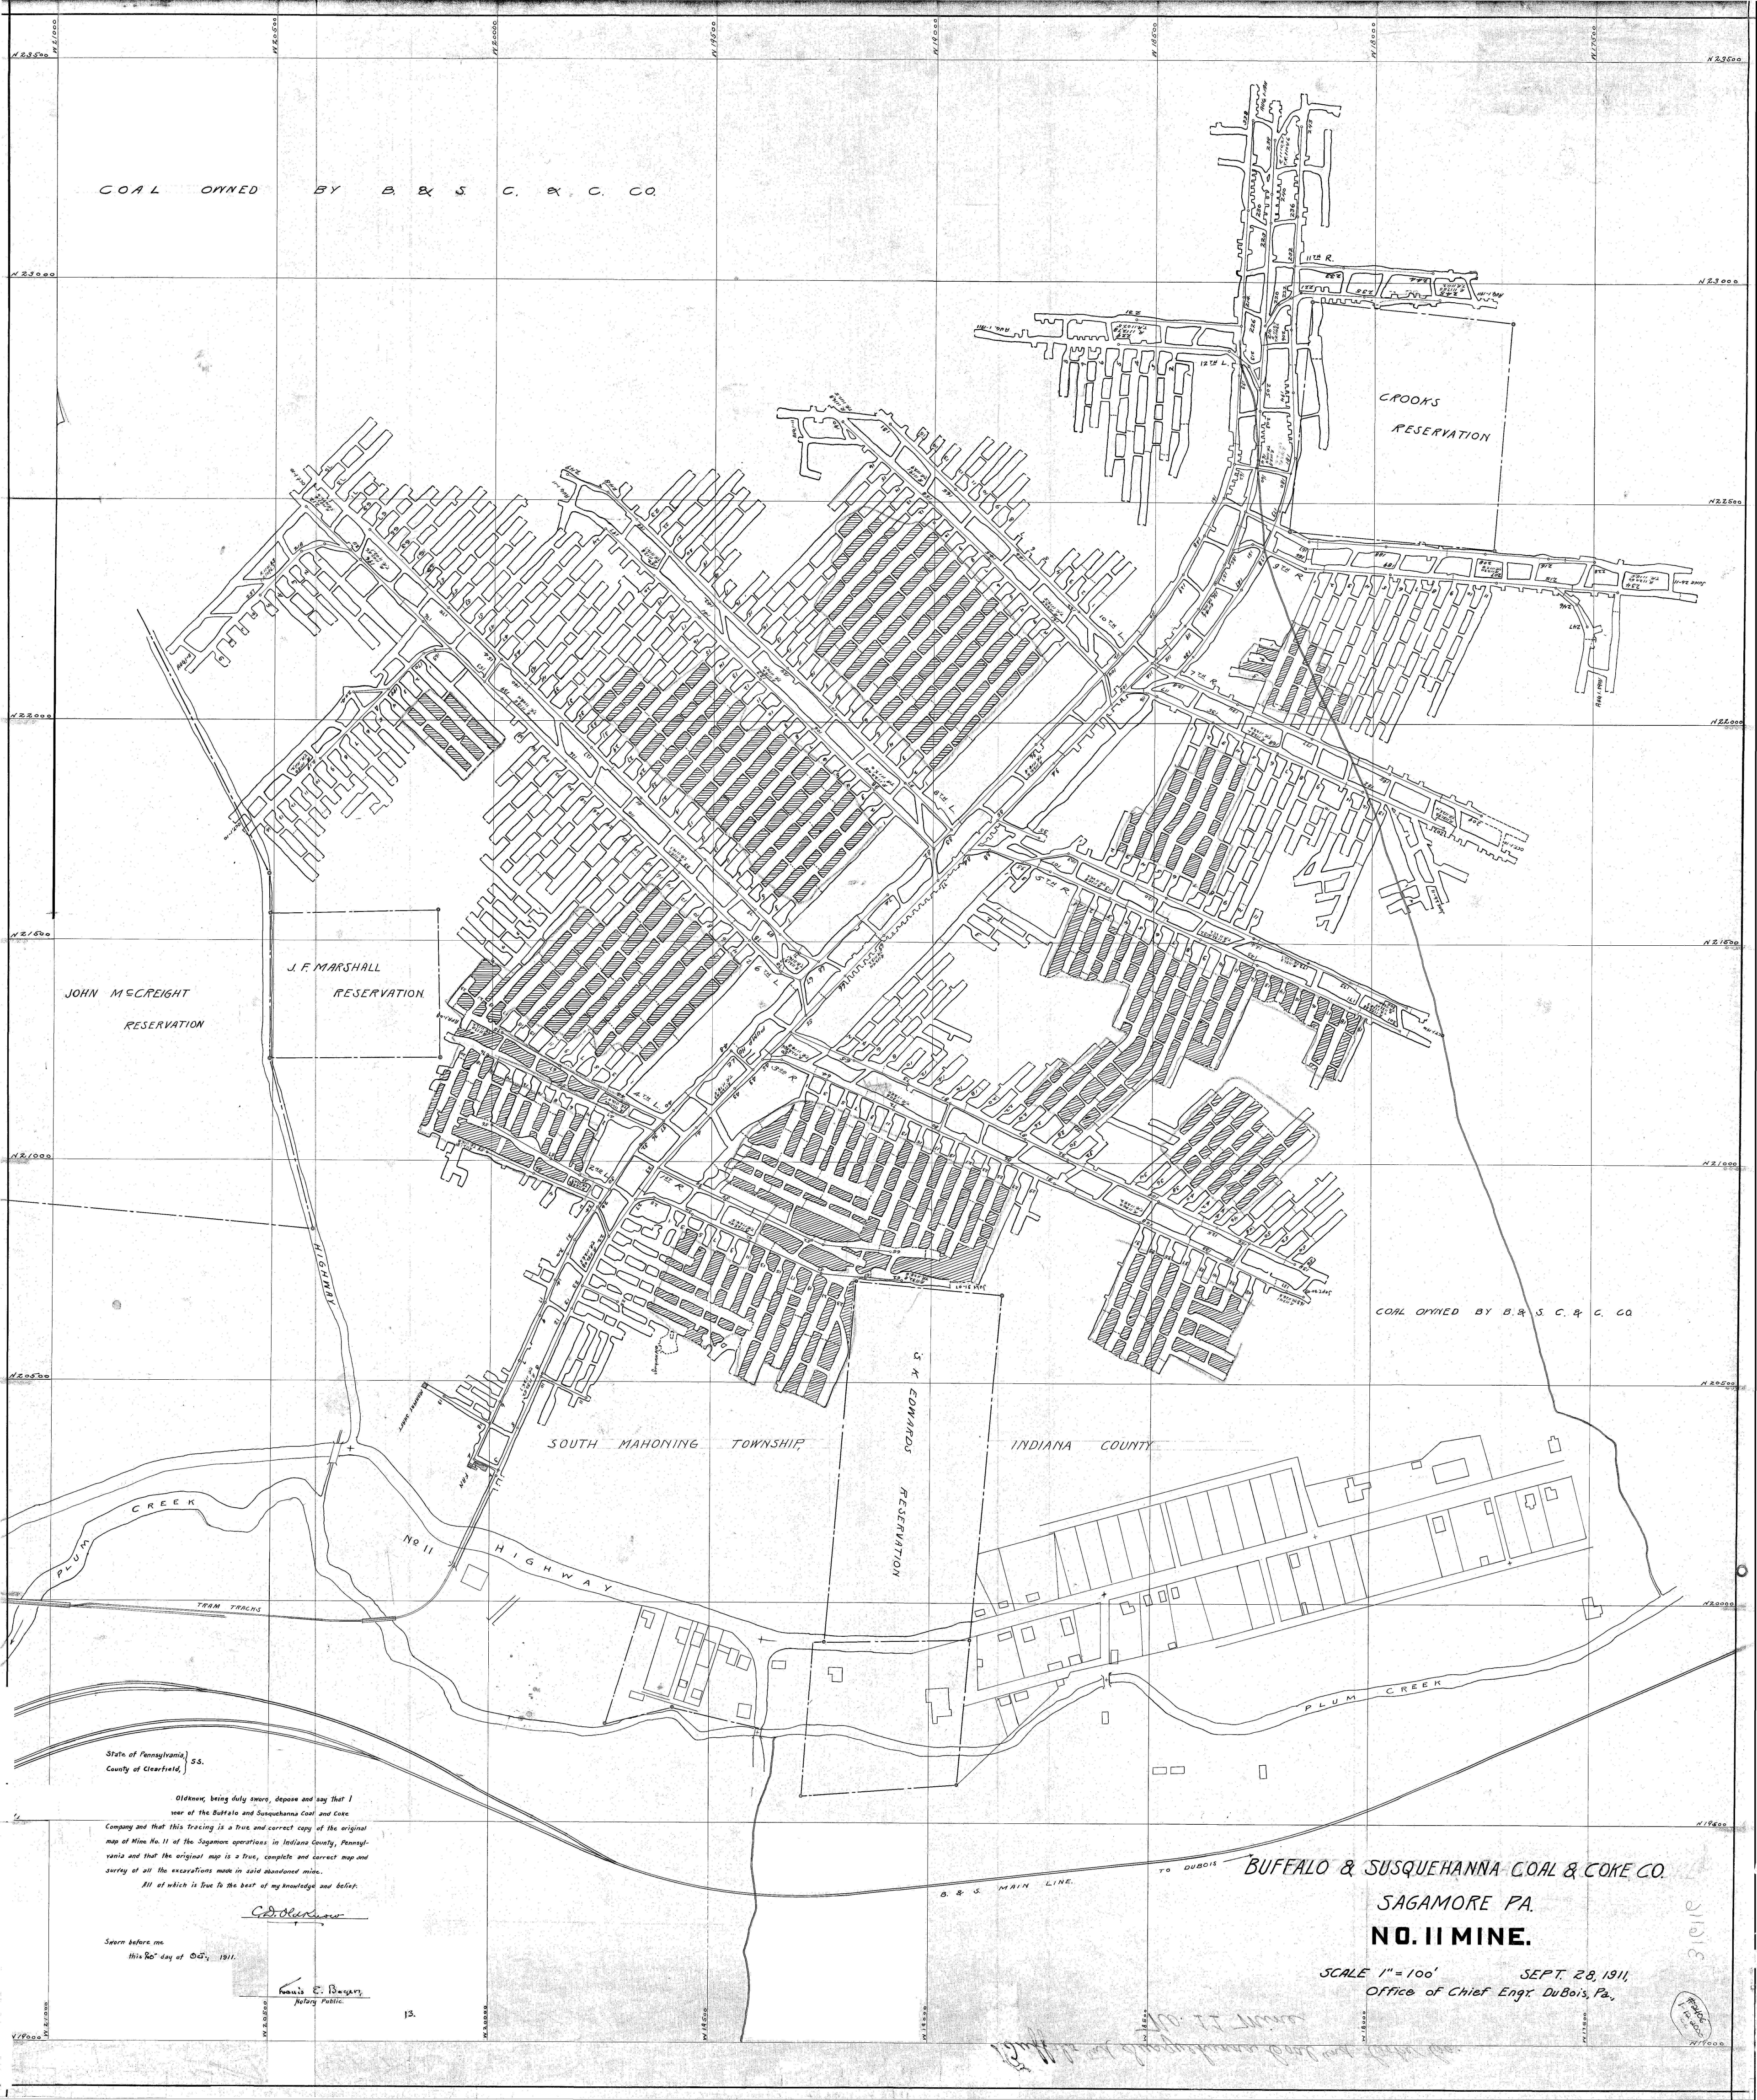

JOHN MCCREIGHT
RESERVATION

J.F. MARSHALL
RESERVATION

CROOKS
RESERVATION

COAL OWNED BY B. & S. C. & C. CO.

SOUTH MAHONING TOWNSHIP

INDIANA COUNTY

J.K. EDWARDS
RESERVATION

NO. 11
HIGHWAY

PLUM CREEK

State of Pennsylvania, ss.
County of Clearfield,

Oldknow, being duly sworn, depose and say that I
am of the Buffalo and Susquehanna Coal and Coke
Company and that this Tracing is a true and correct copy of the original
map of Mine No. 11 of the Sagamore operations in Indiana County, Pennsylv-
ania and that the original map is a true, complete and correct map and
survey of all the excavations made in said abandoned mine.
All of which is true to the best of my knowledge and belief.

C.D. Oldknow

Sworn before me
this 28th day of Oct., 1911.

Kenneth E. Baugher
Notary Public

BUFFALO & SUSQUEHANNA COAL & COKE CO.
SAGAMORE PA.
NO. 11 MINE.

SCALE 1"=100'
SEPT. 28, 1911,
Office of Chief Engr. DuBois, Pa.