
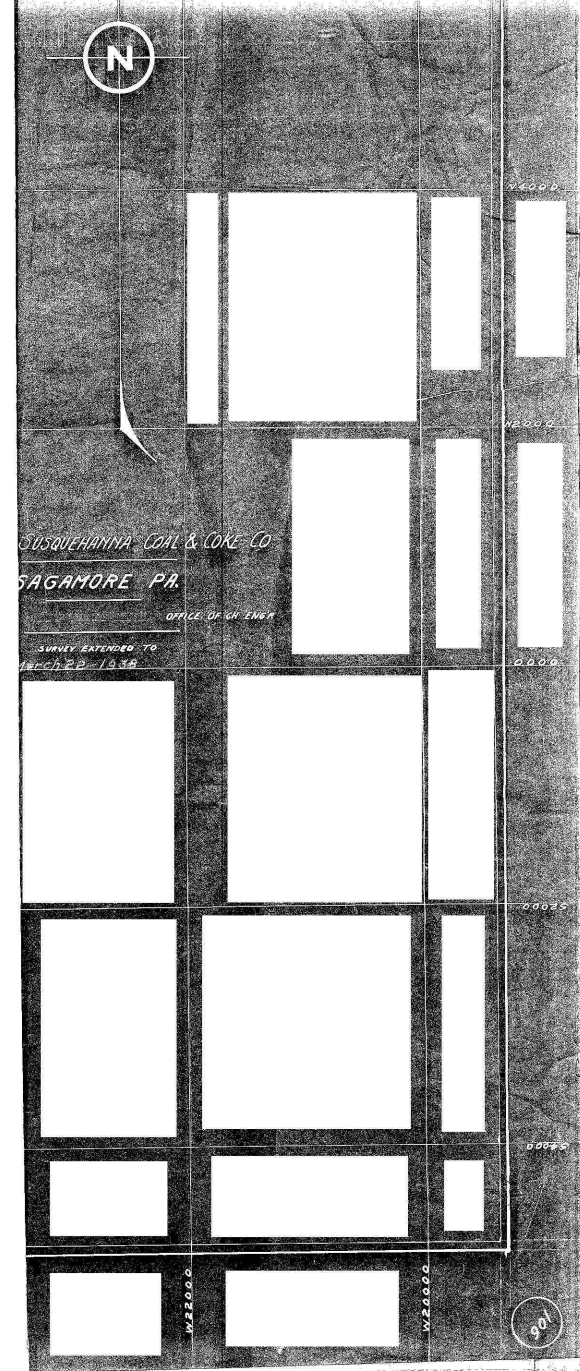


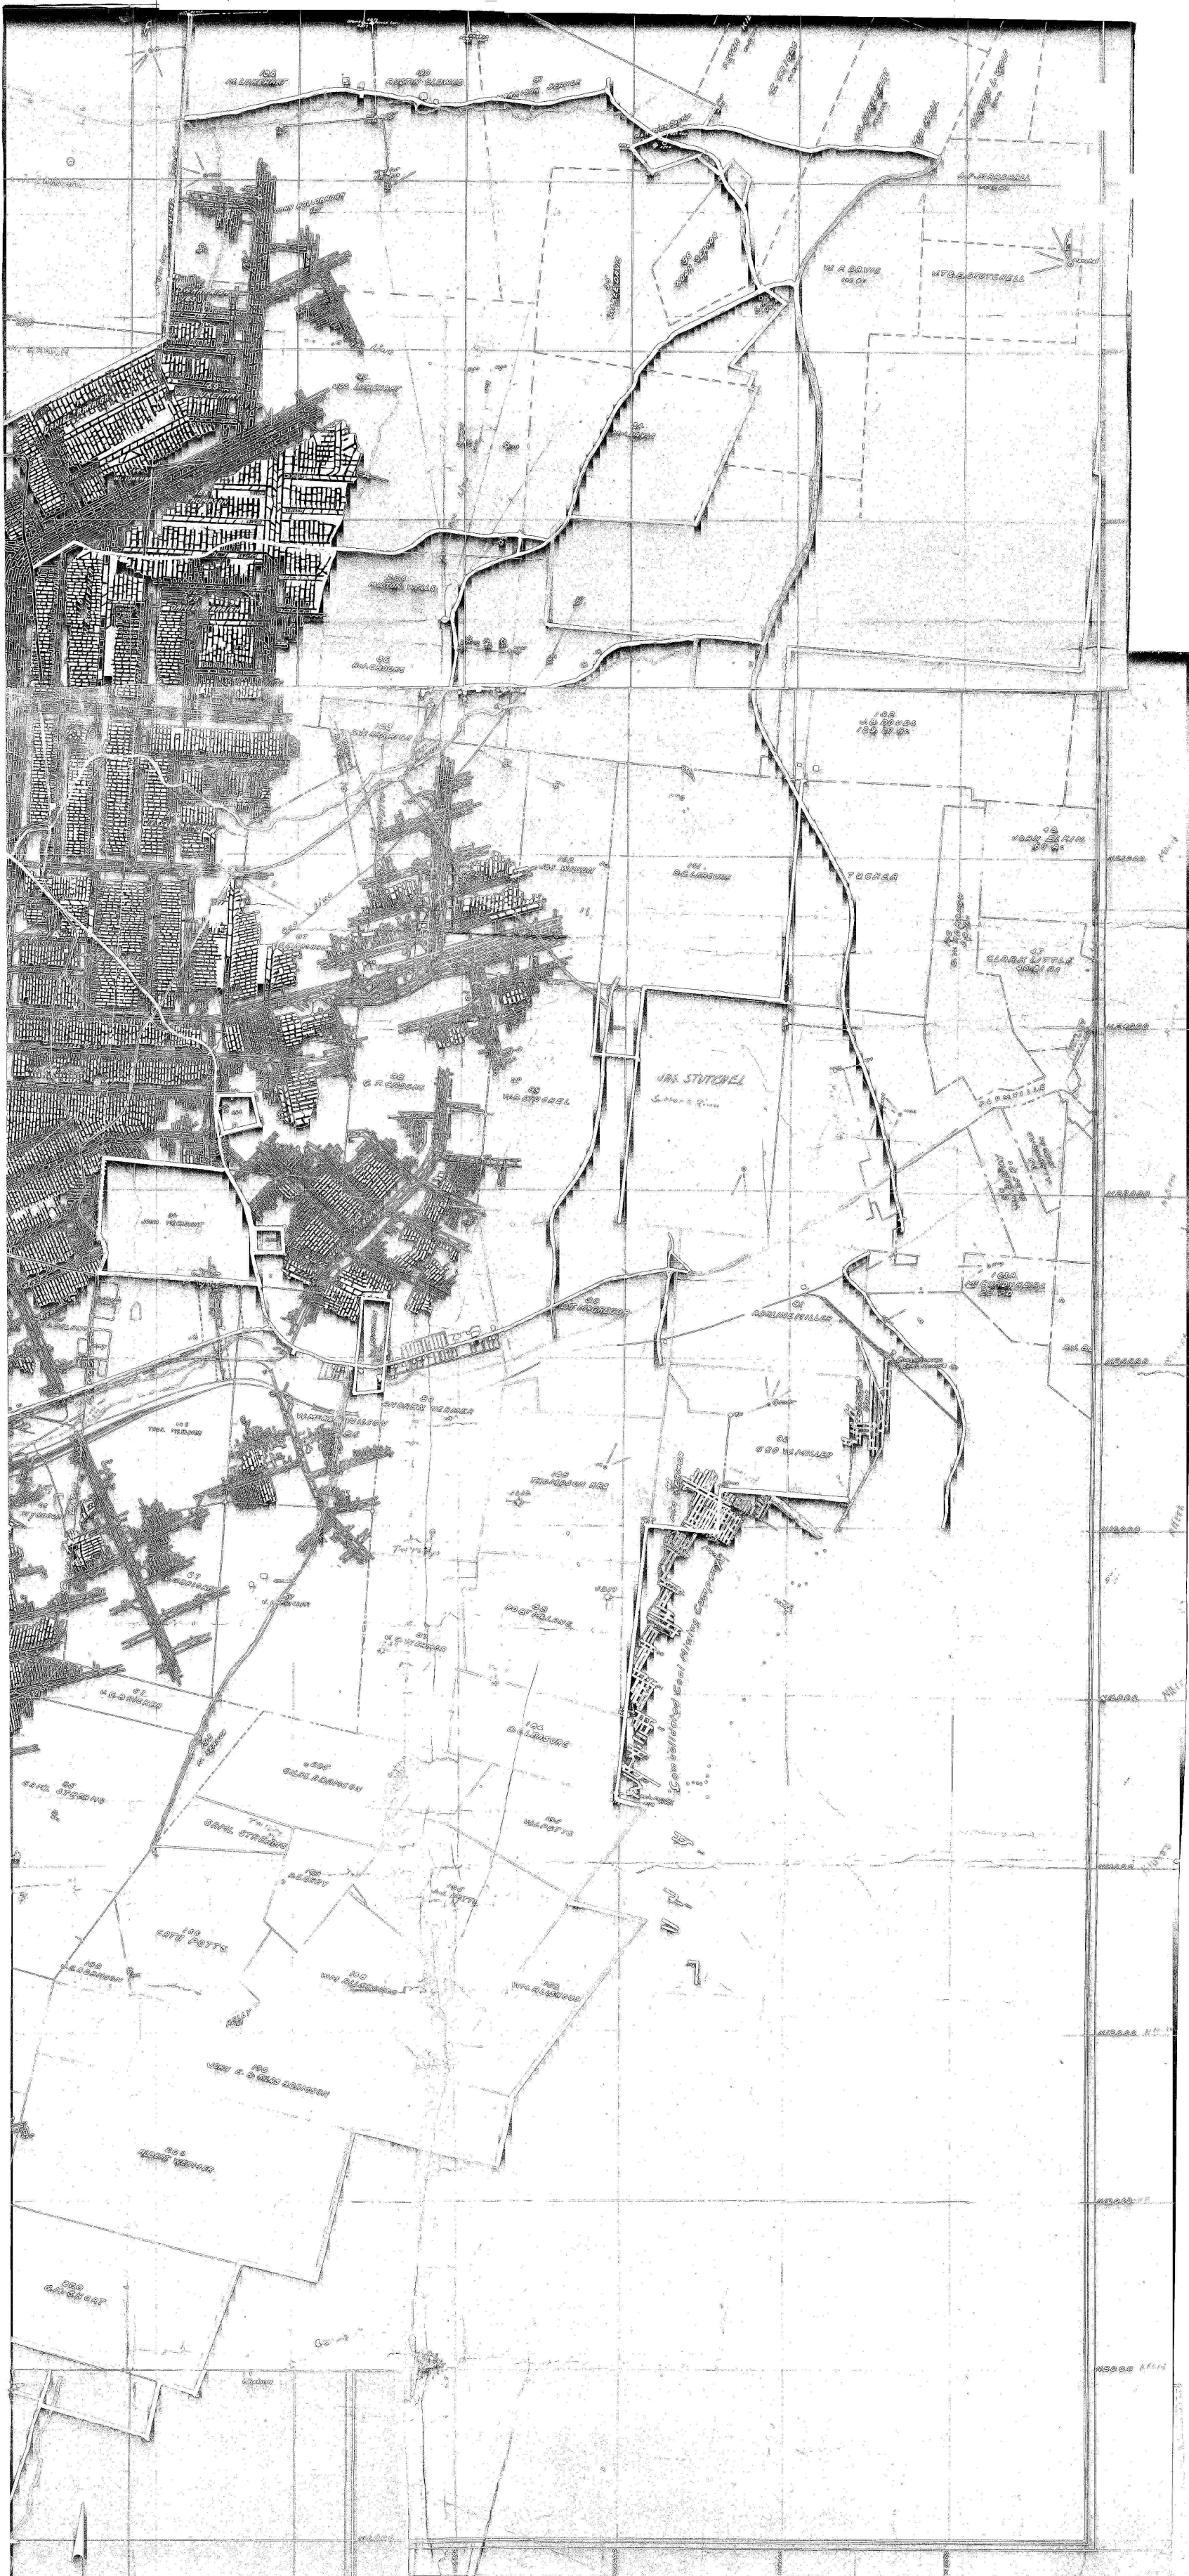

302410

302410

302410