




Handwritten note:
2/18/66
J.P. Blauser

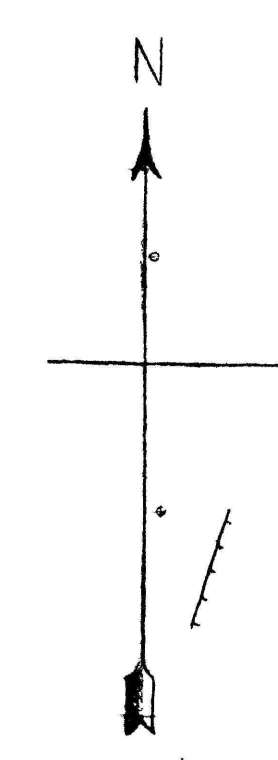

HOTEL MAGNETIC NORTH

LEGEND

E. J. WEIBEL	11/10/57
A. J. LUCAS	5/10/59
A. J. LUCAS	7/10/61
W. J. LUCAS	11/12/63
D. H. LIPSCOMB RS 1732	11/10/66
D. H. LIPSCOMB RS 1732	12/10/66

SCALE 1 INCH = 100 FEET

(Brookville Seam) 7' 10" 1' 10" 1' 10" 1' 10"

SALT CITY MINING CO., INC.
NO. 1 - MINE
ALLEGHENY TWP. BUTLER CO. PA

DATE MAY 10 1966
DATE DEC 10 1966

SIX MONTHS PROJECTION
JAN 1 - THRU JUNE 30, 1967

LEON LIPSCOMB RS

1-10-2000
C.C.