



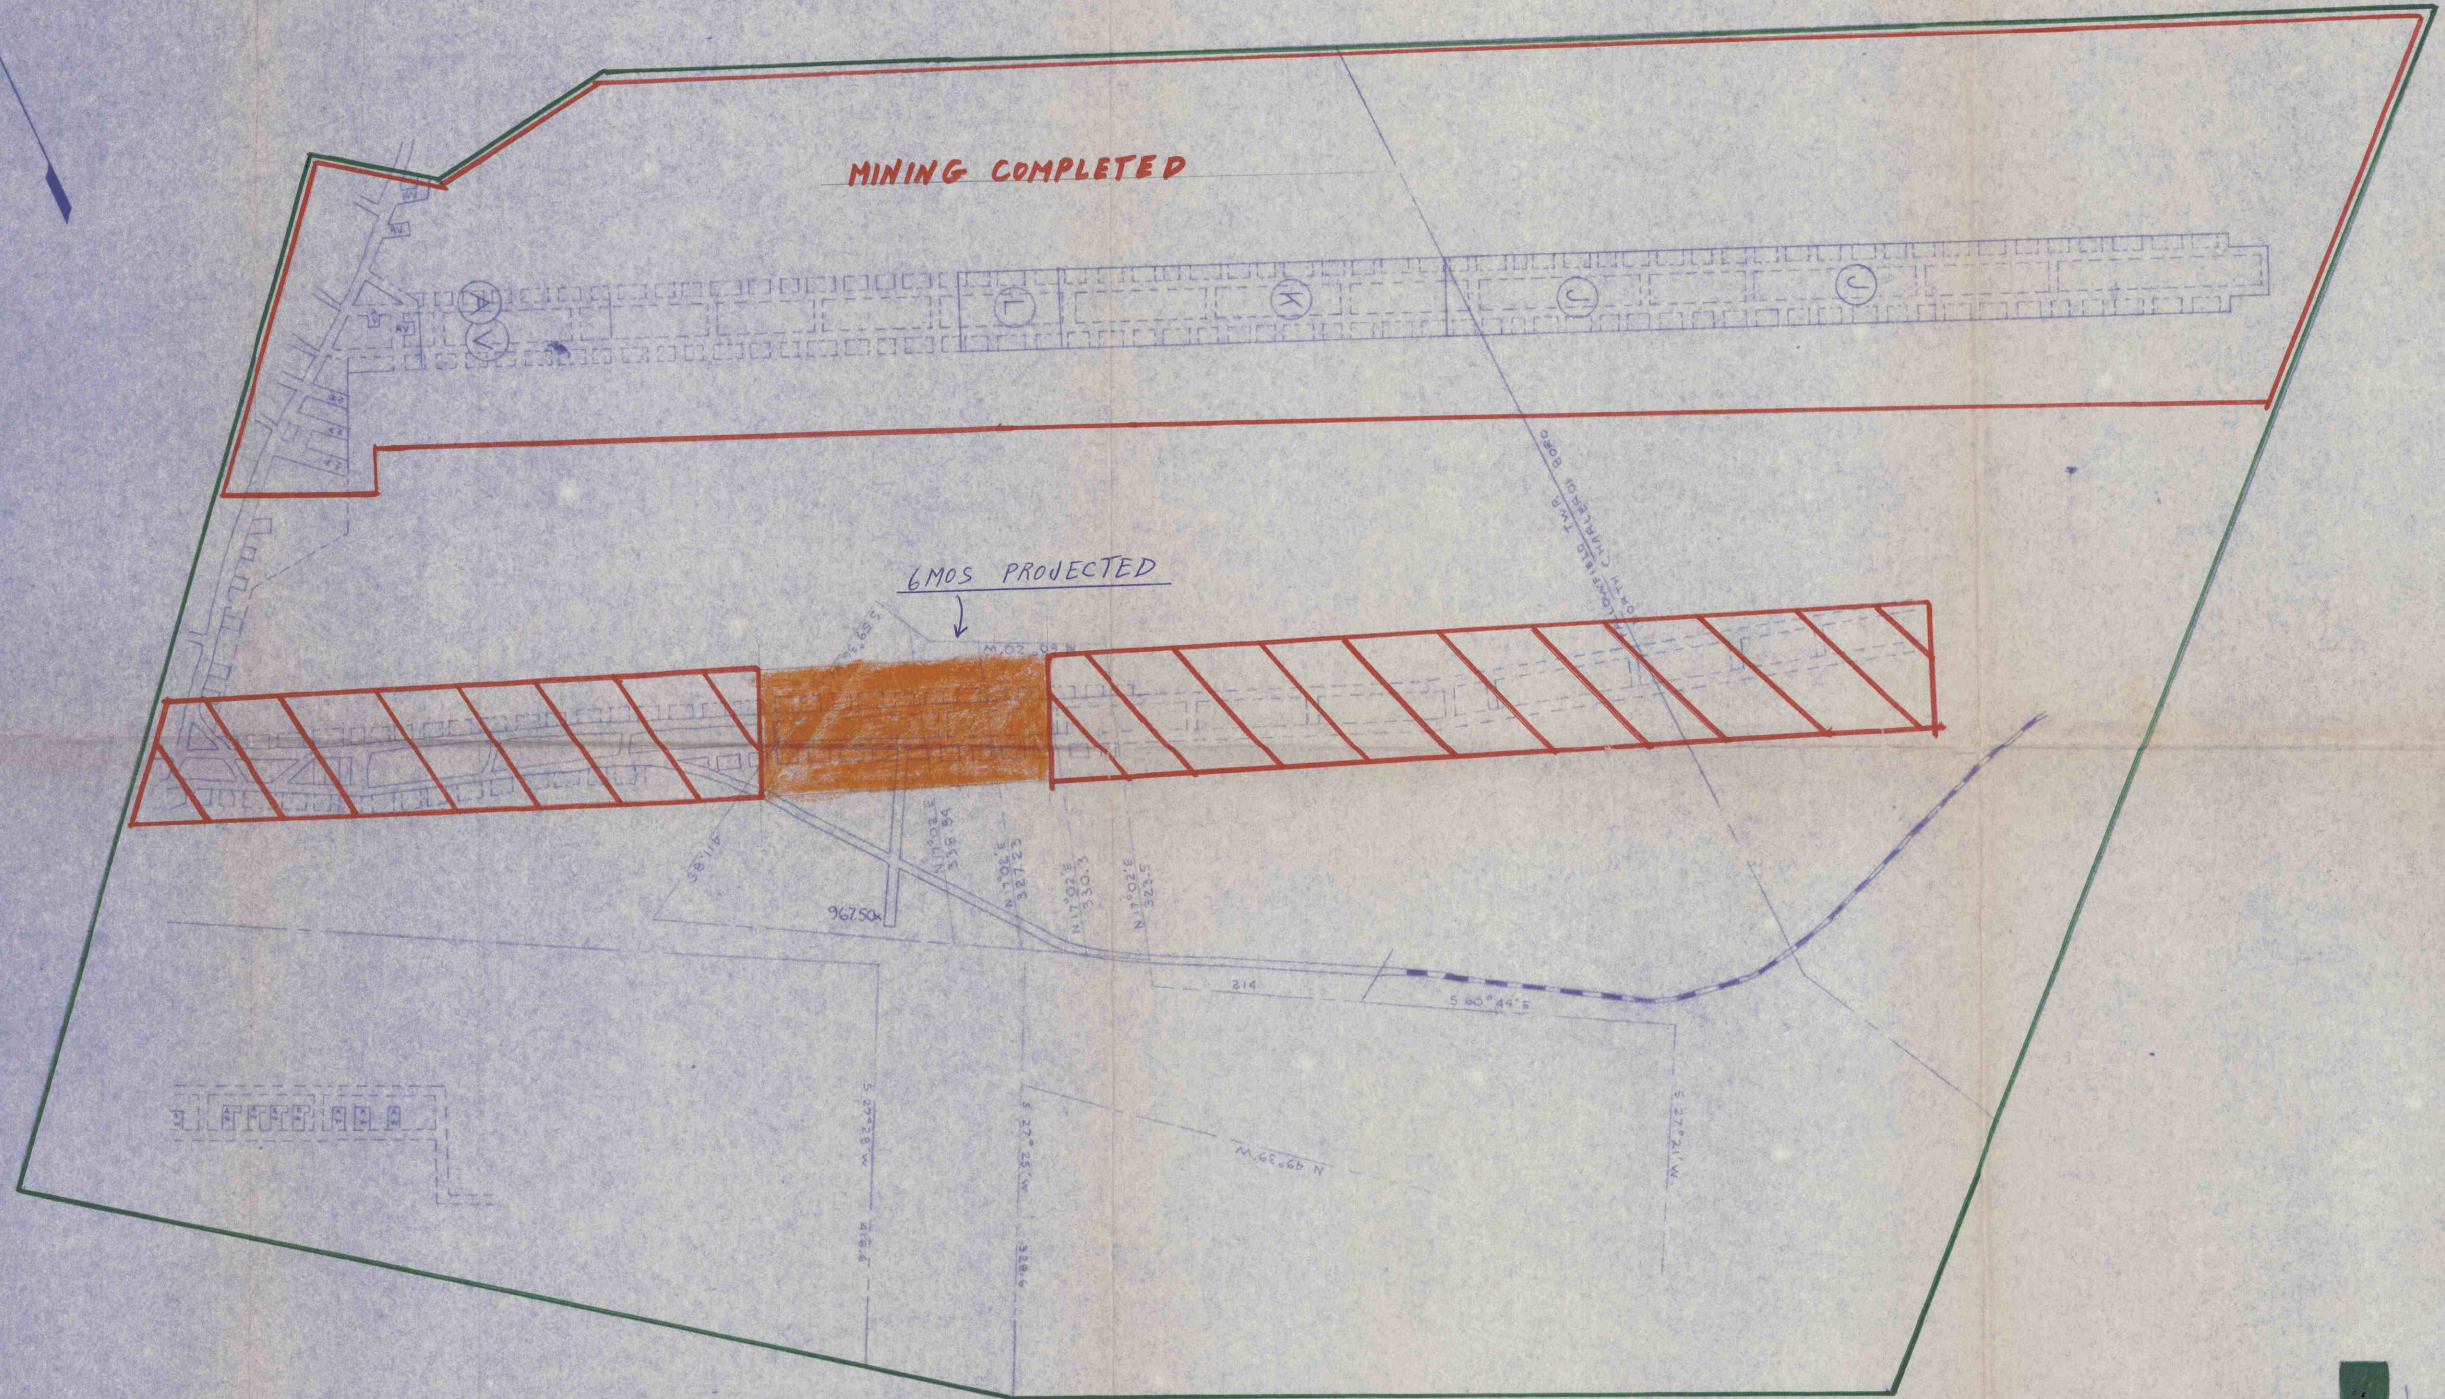

LEASE LINE
MINING COMPLETED
6 MOS. PROTECTION
11-29-67 to 5-29-68

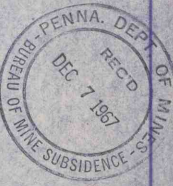

F
NB
T-30

DRAWN	RBM	11/29/66
CHECKED		
APPROVED		
REVISIONS		



SANA MINE
MCDONALD ASSOCIATES ENGINEERING
CHARLOTTE, PA.
SCALE 1" = 100'
JOB 1532
SHEET No. 1

#046
1-12-2000
C.C.