

- LEGEND
- "E" MIN. BOUNDARY
 - LIMIT OF MINE
 - MINING COMPLETE
 - AREA 6 MOS. MINING 10-20-72 to 4-20-73

TRACED FROM MAP BY ELY & FRENCH (PREVIOUS SUBMISSION)
REVISED & CORRECTED LIMIT OF MINE & MINED OUT AREAS

SCALE 1" = 200'

9-26-66


SAMUEL N. THOMAS - MINE

JENNER TWP., SOMERSET CO., PA.

SCALE 1" = 100' Survey 1-27-68

MAP TO 3-12-70 FOR NEW OWNER

S. AND F. COAL CO.

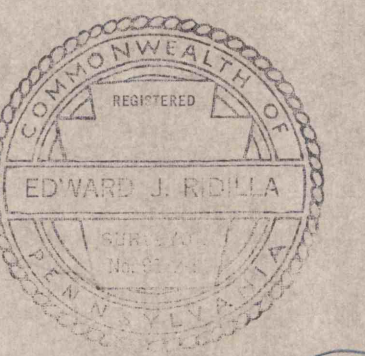

#2419
1-12-2000
C.C.