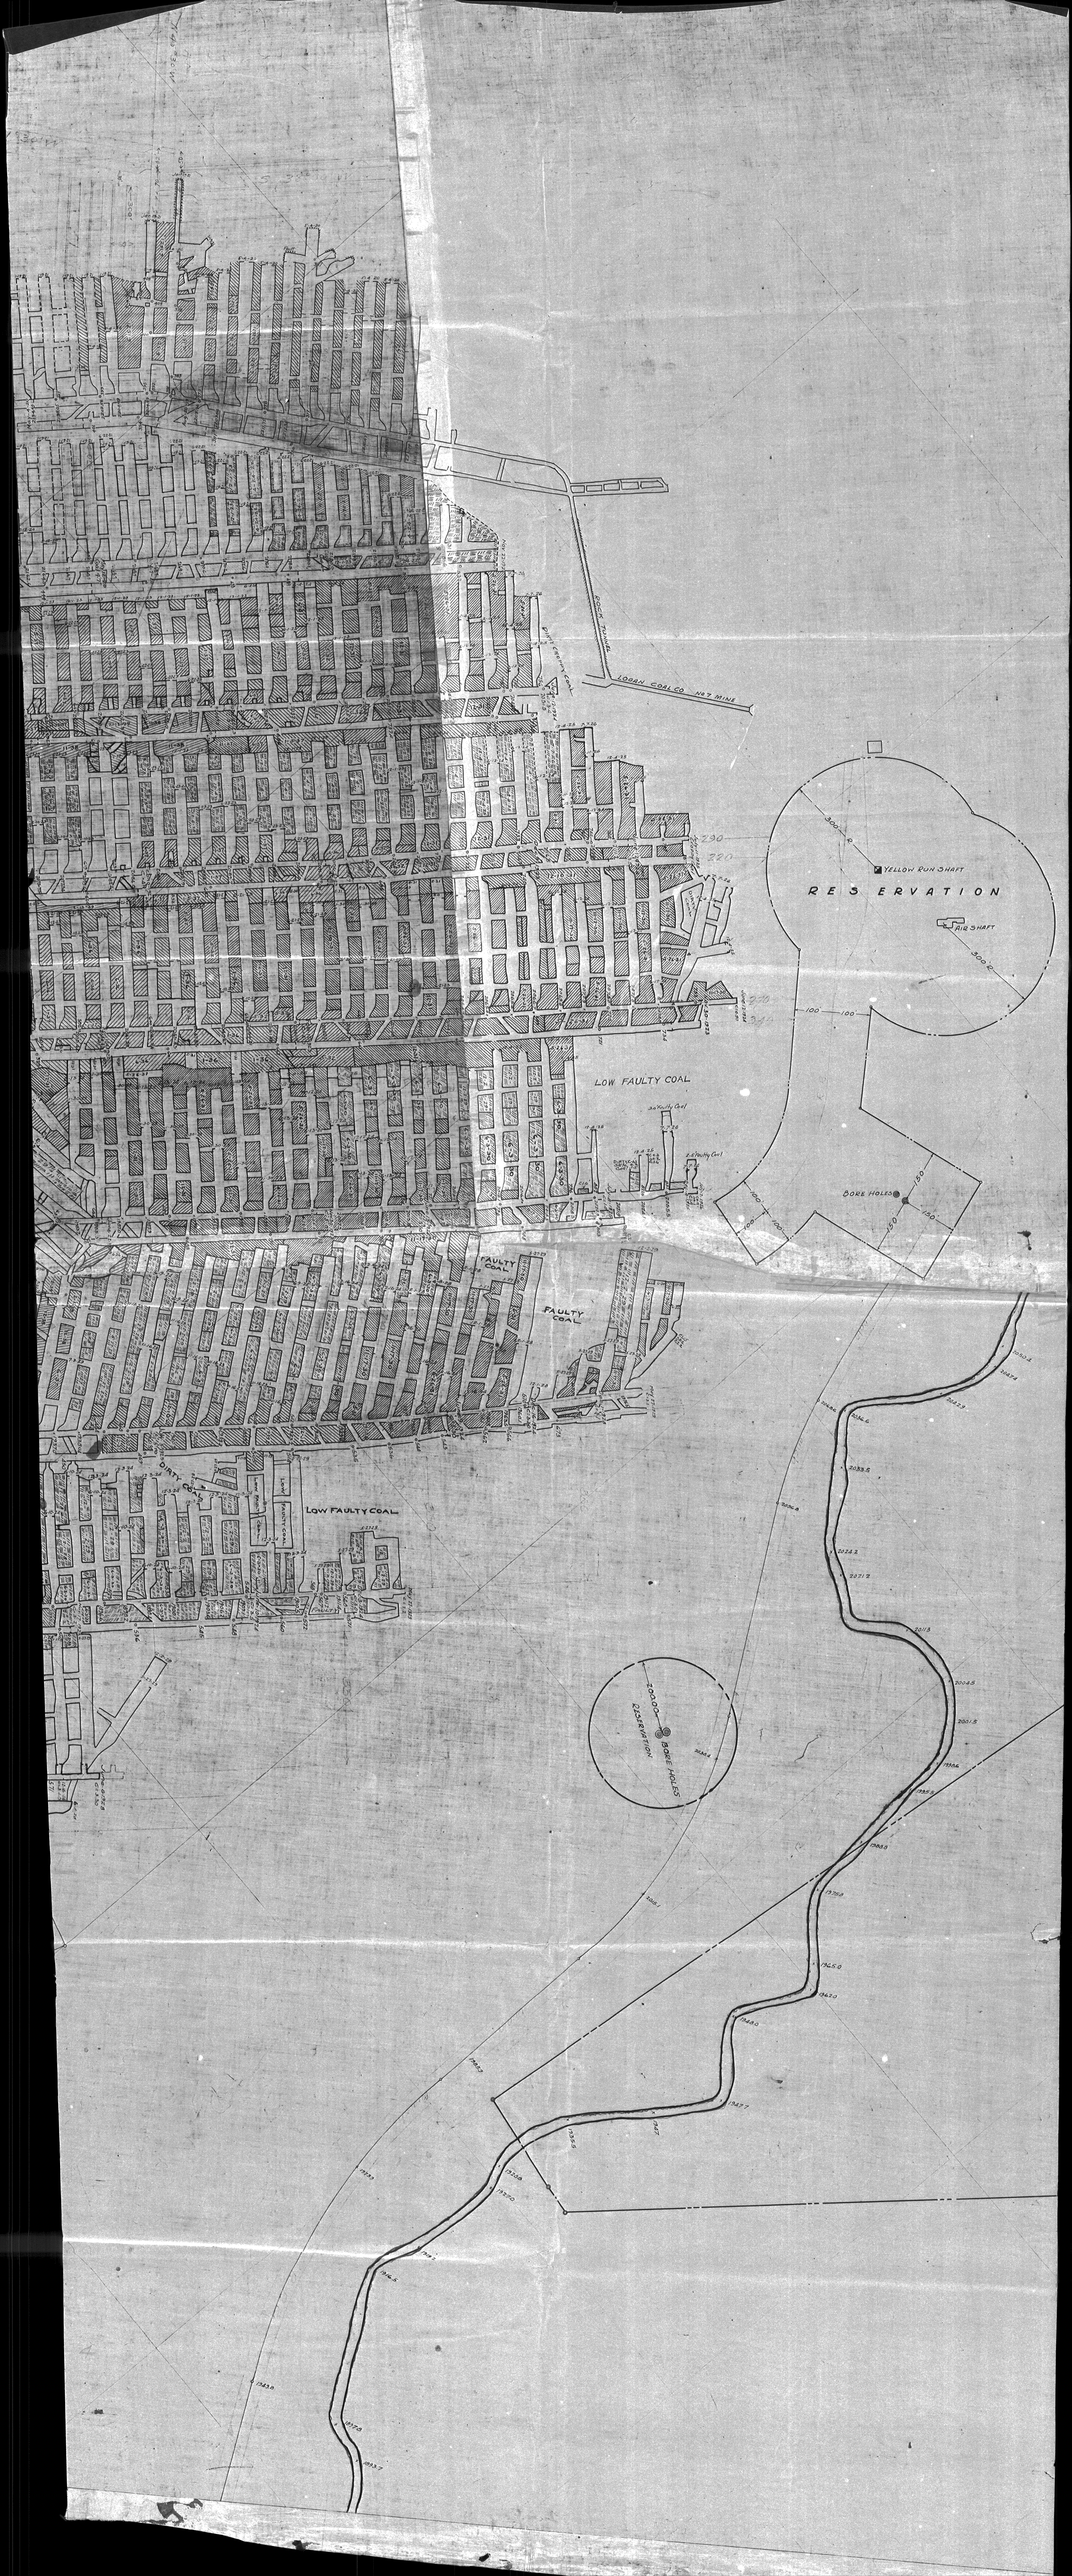
LOBAN COAL CO. NO 7 MINE
RESERVATION
YELLOW RUN SHAFT
RIB SHAFT
BORE HOLES
LOW FAULTY COAL
FAULTY COAL
FAULTY COAL
LOW FAULTY COAL
BORE HOLES
