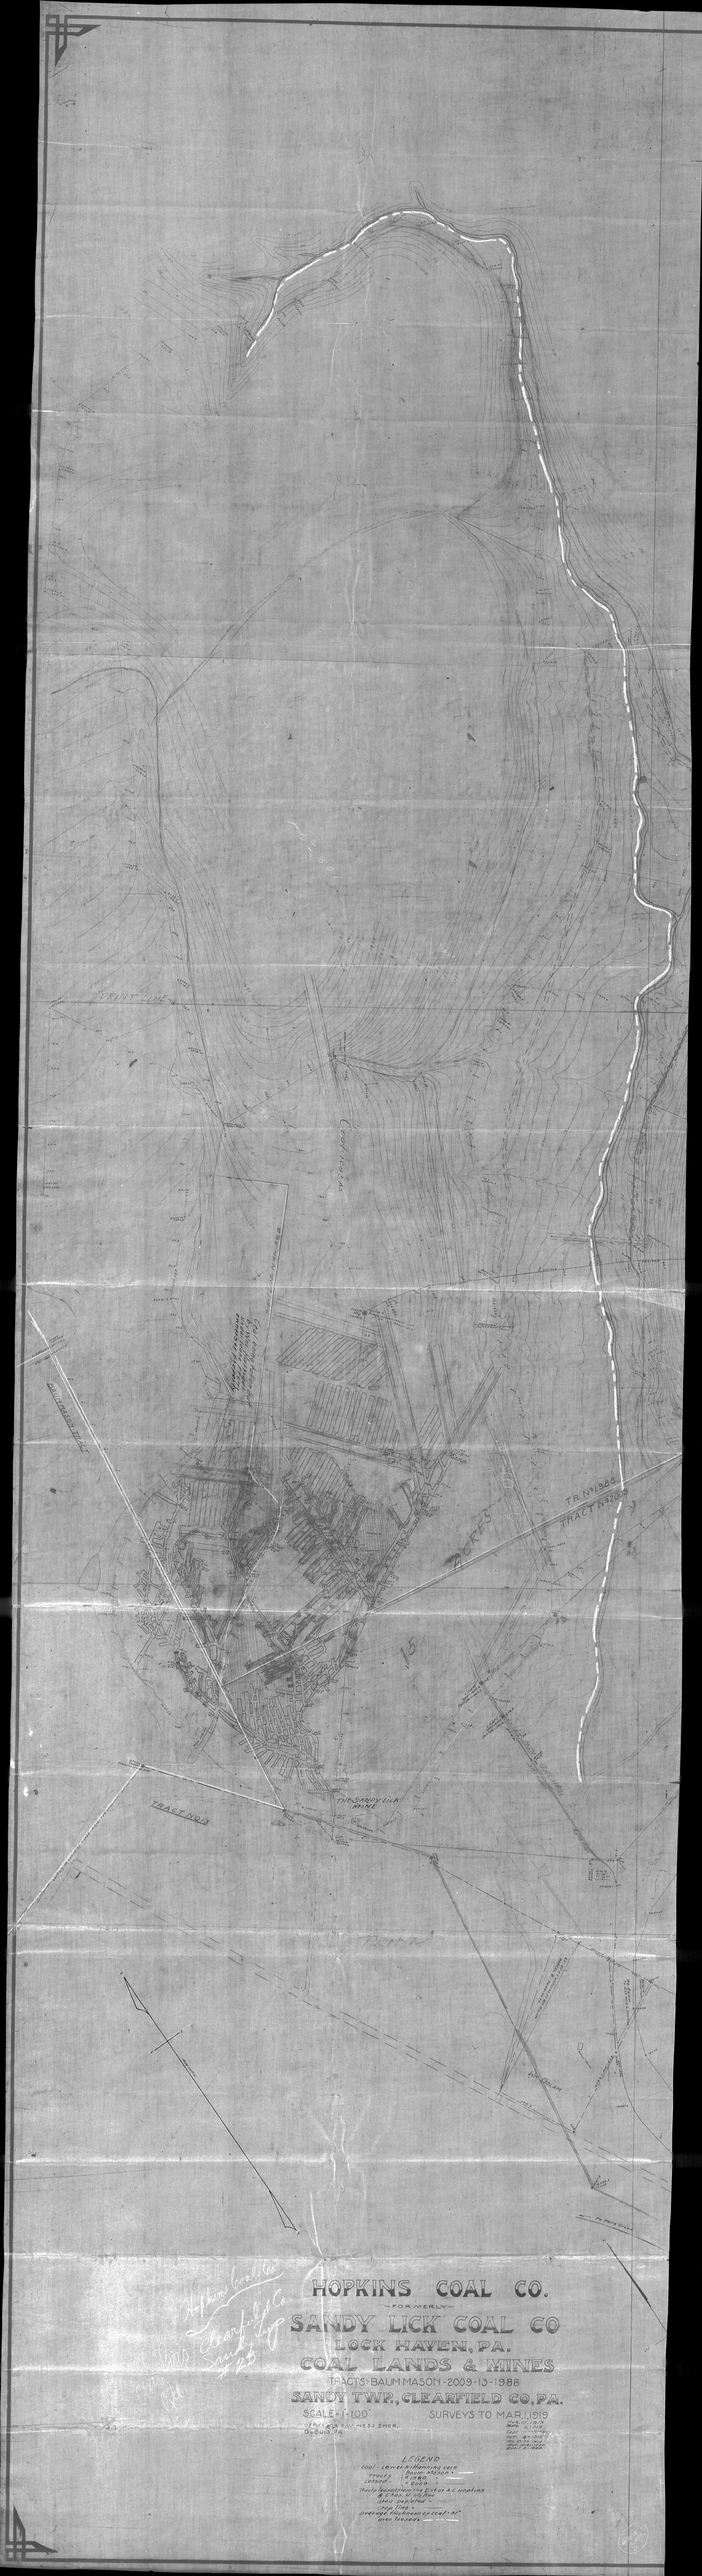
HOPKINS COAL CO.
—FORMERLY—
SANDY LICK COAL CO
LOCK HAVEN, PA.
COAL LANDS & MINES
TRACTS-BAUMASON-2009-13-1988
SANDY TWP., CLEARFIELD CO., PA.
SCALE-1"=100'
SURVEYS TO MAR. 1, 1919
LEGEND
TRACT NO 3
