


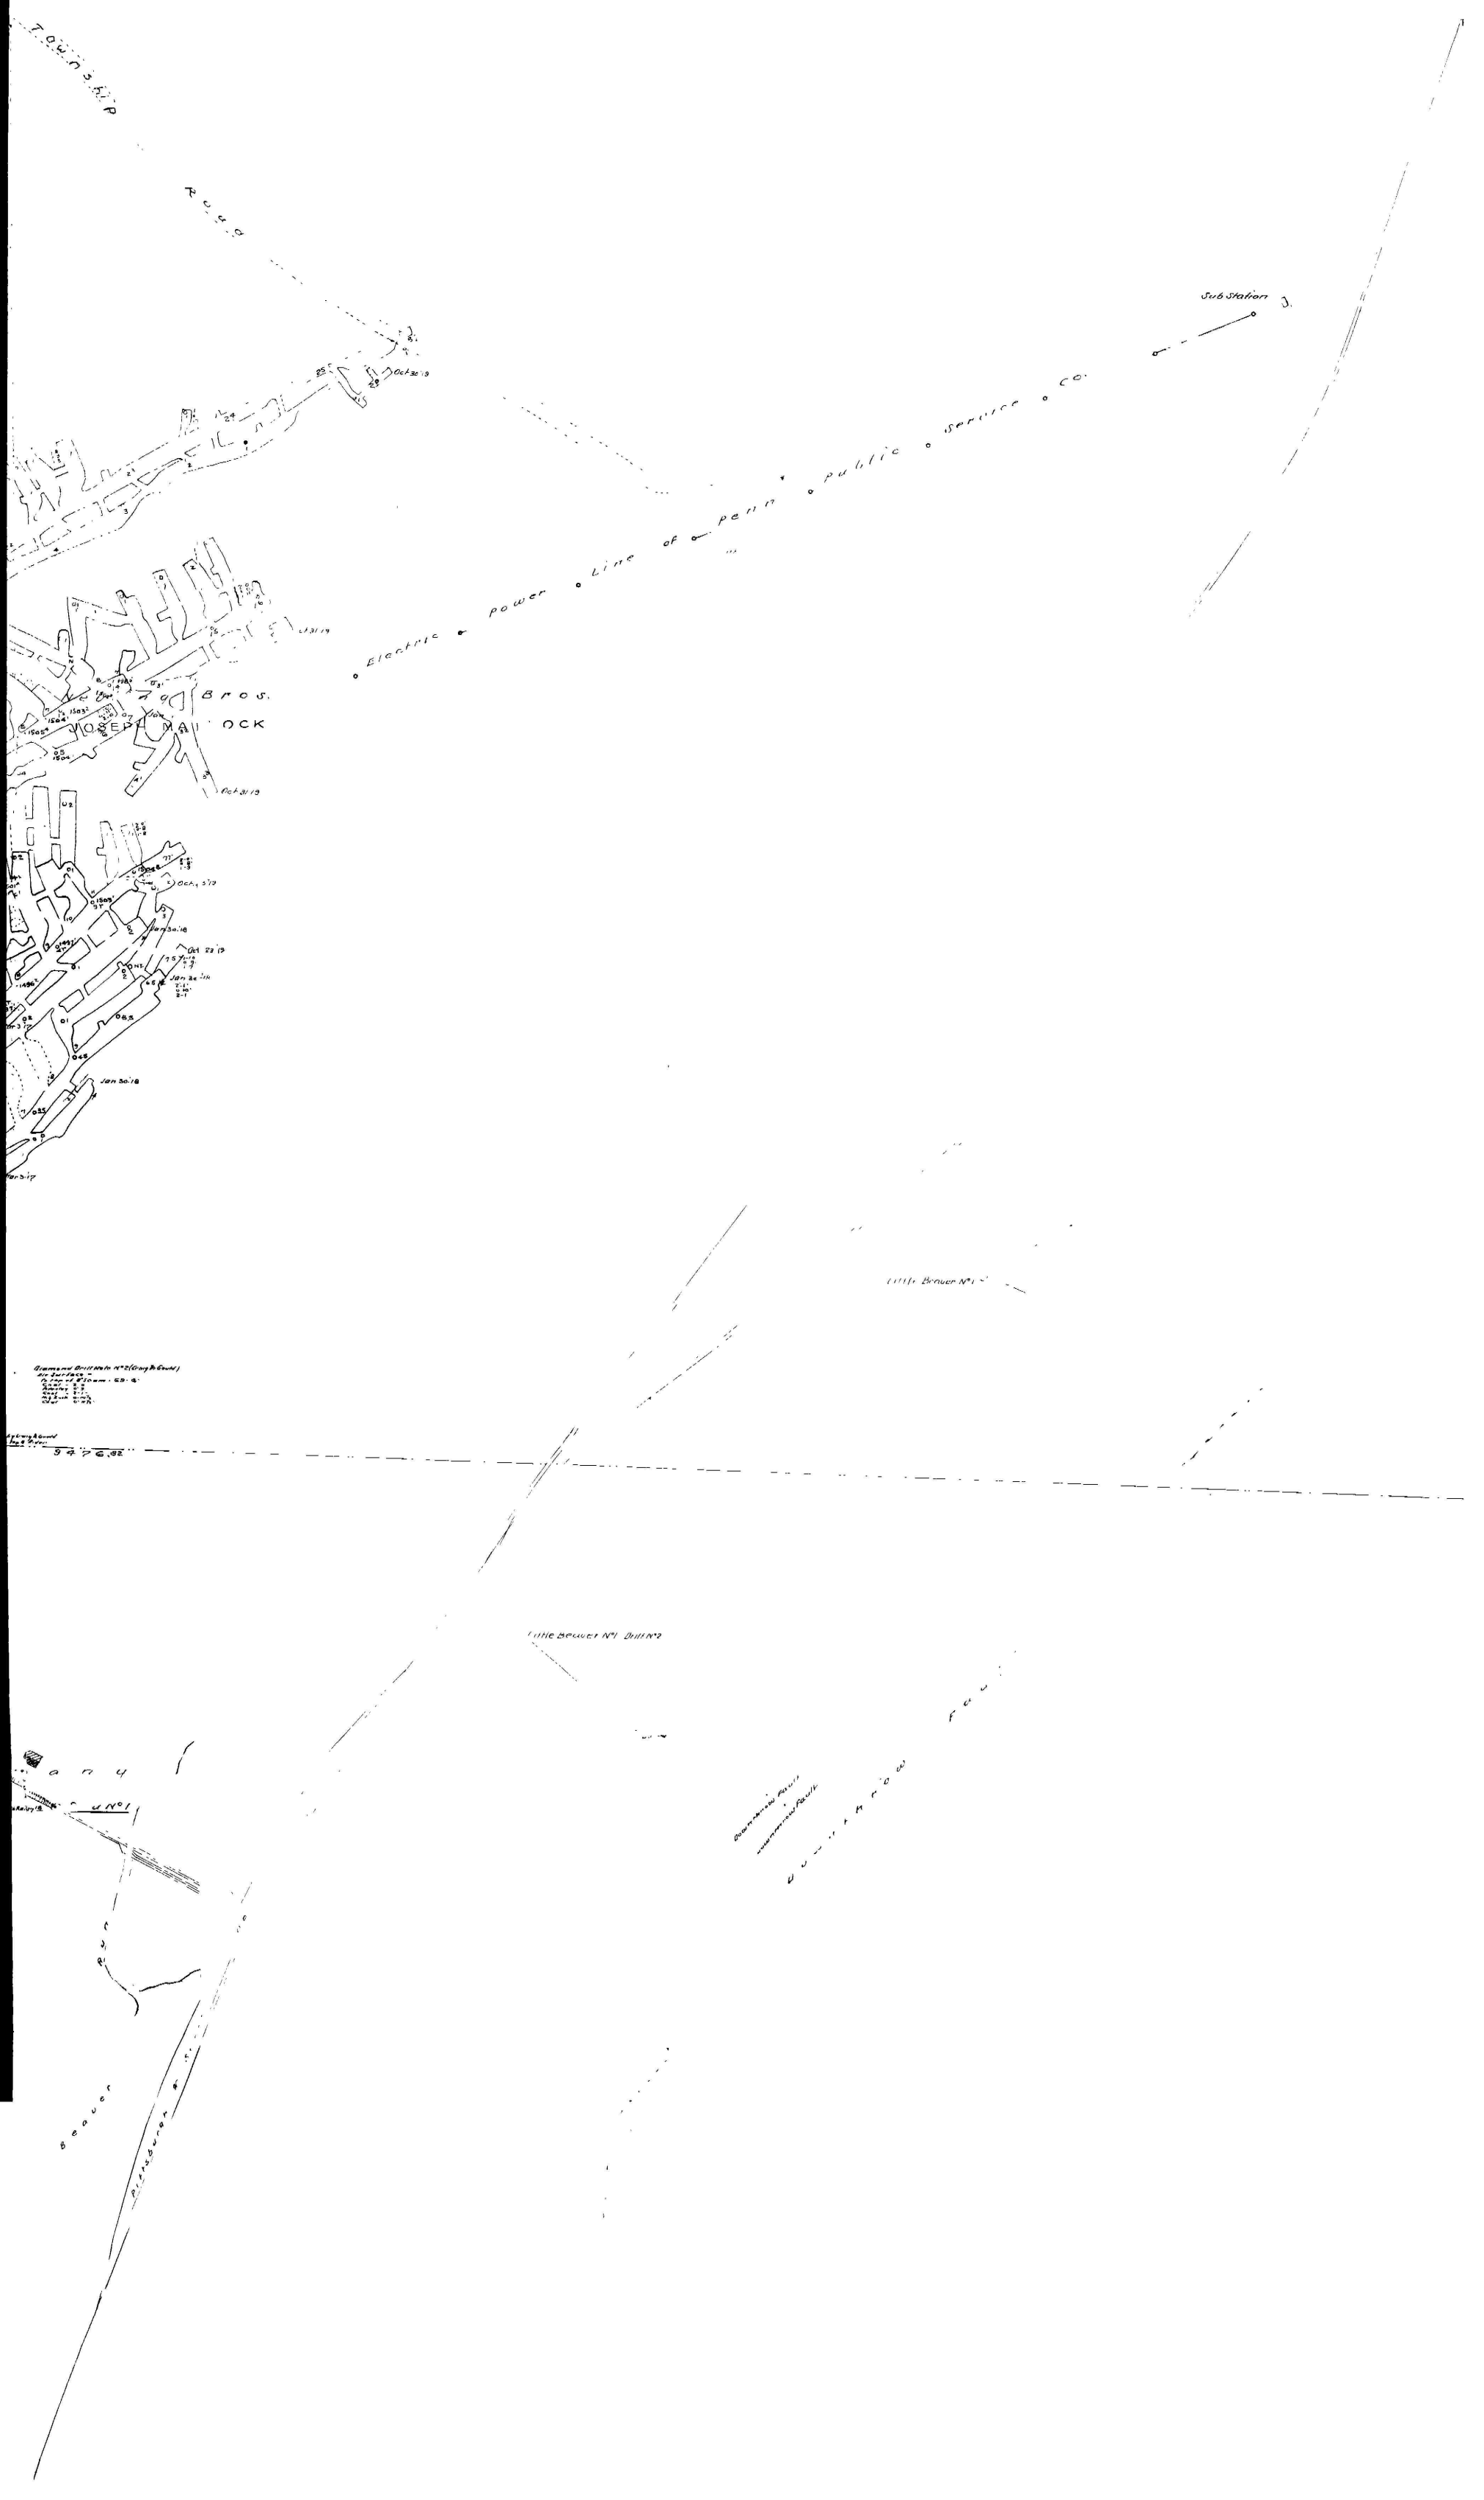

Diamond Drill Hole #2 (Deep 8' 6")

