


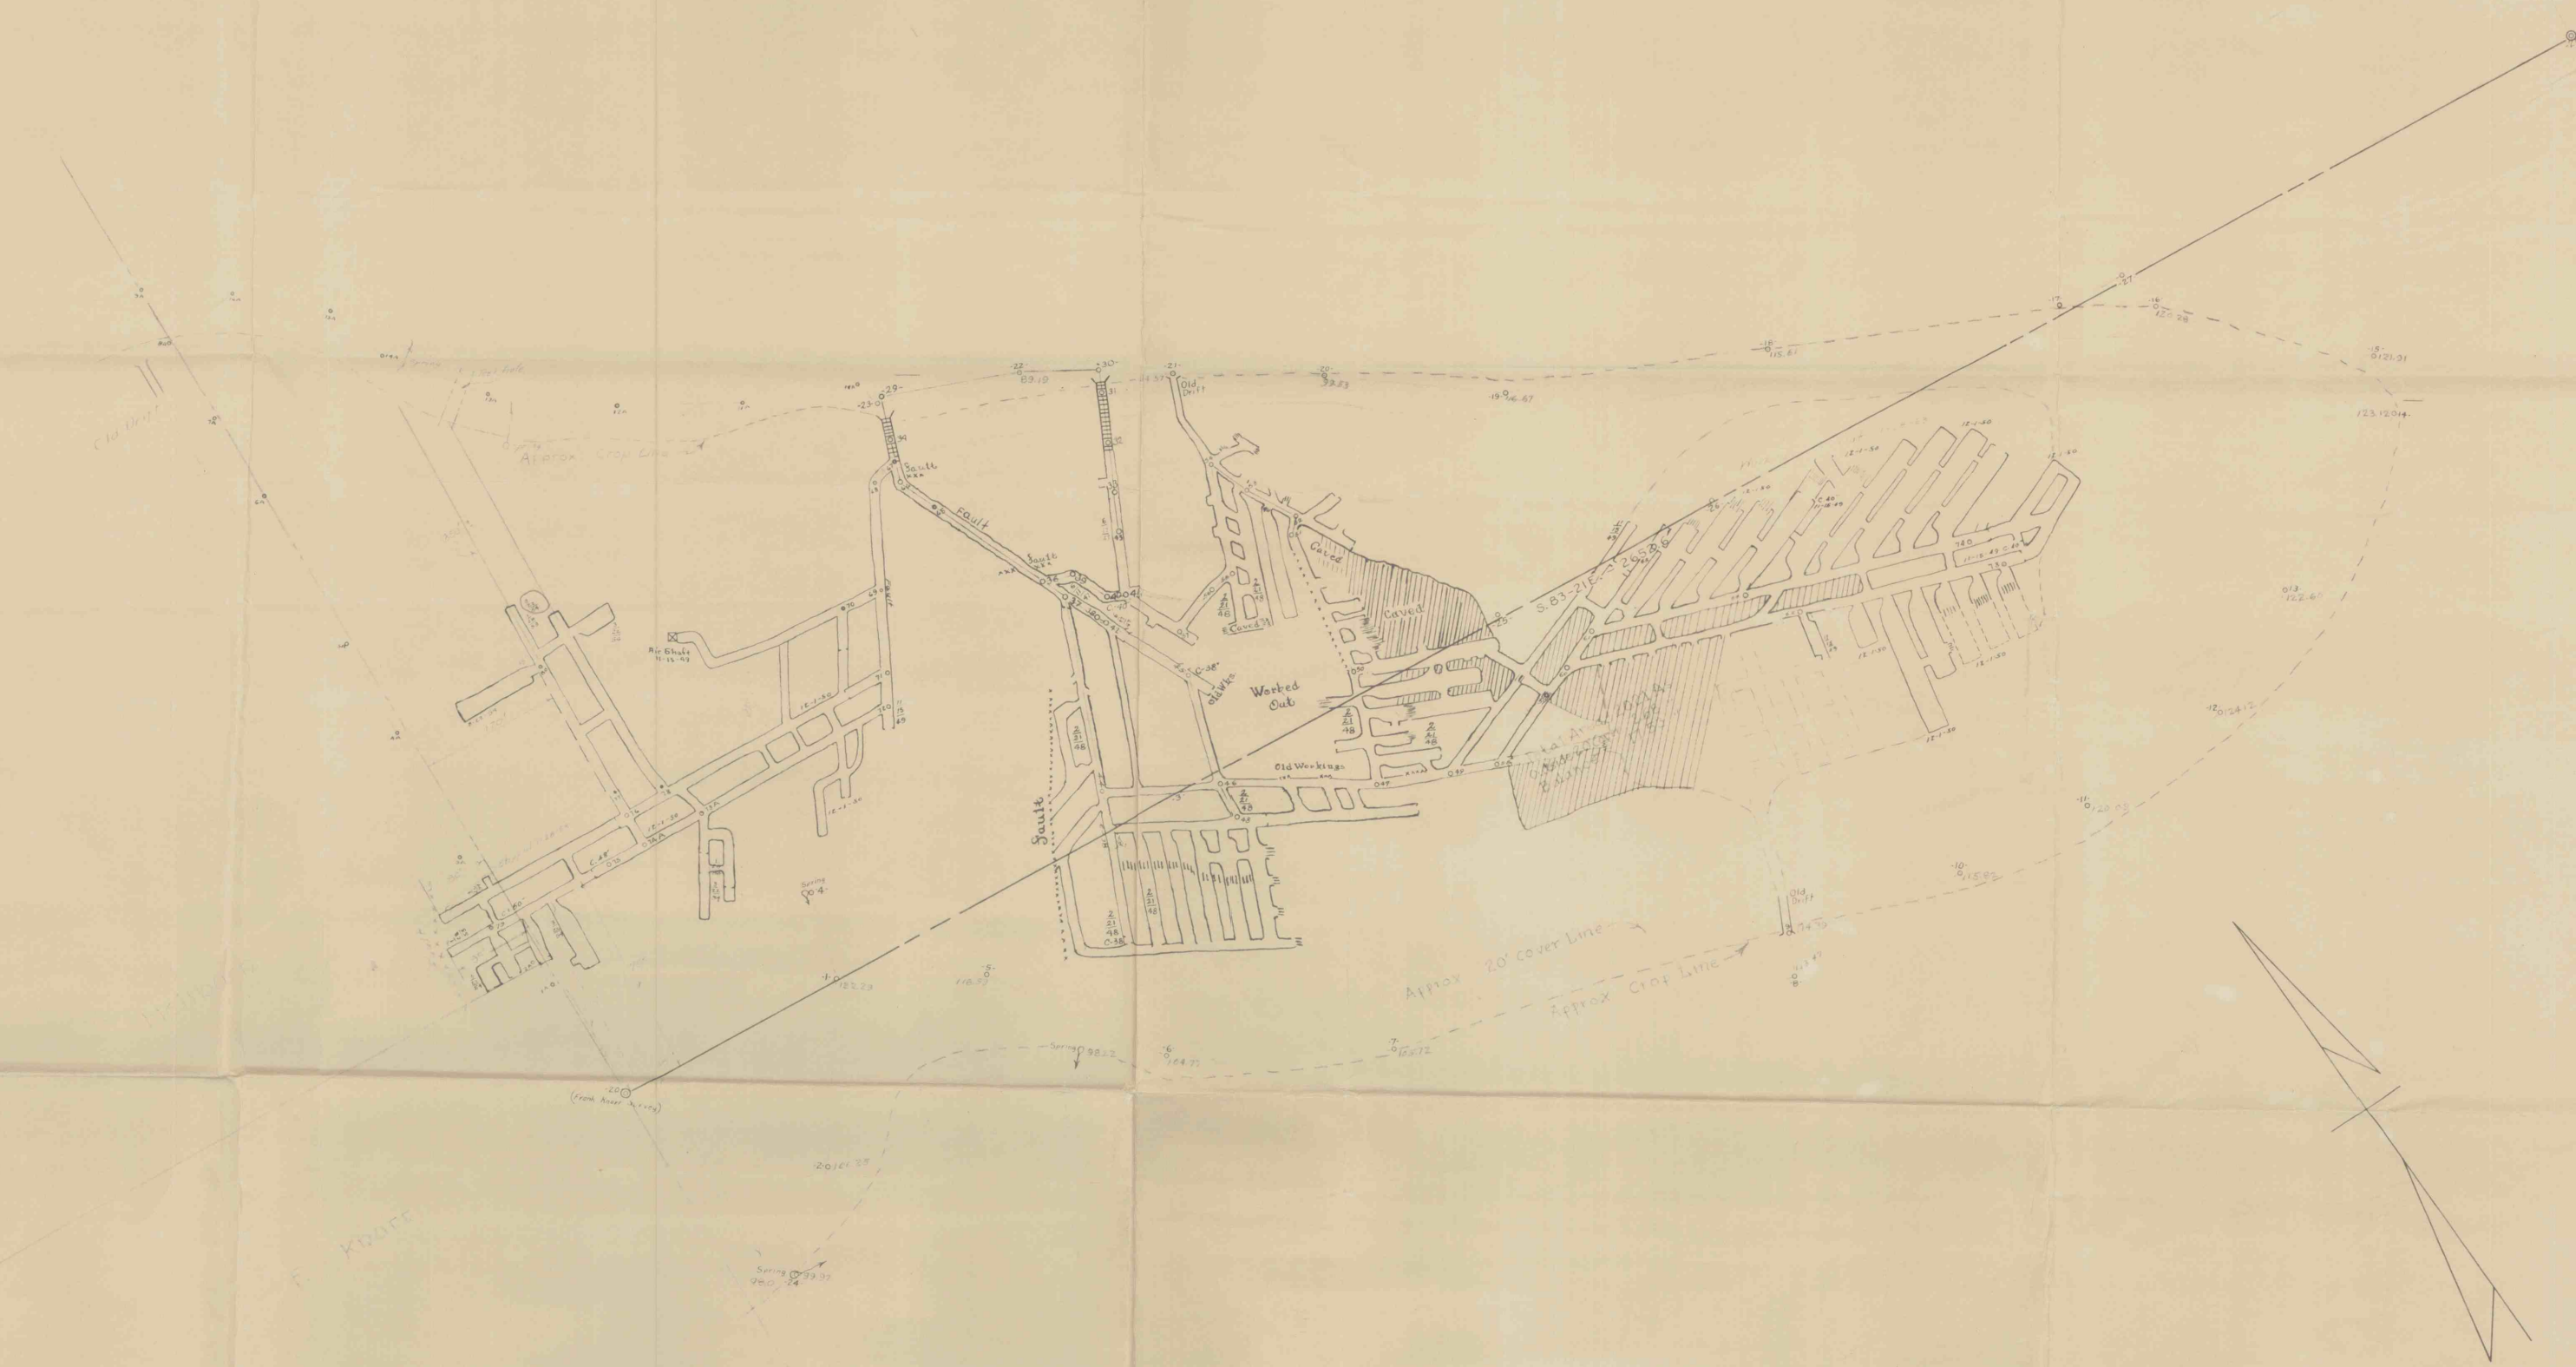

MAP SHOWING
COAL LANDS AND MINES
OF
G. L. SCHUCKERS AND SON
BELL TOWNSHIP, CLEARFIELD COUNTY, PA.

SCALE: 1"=100' DECEMBER 23, 1946

YOST, BROMFIELD AND HESS, ENGRS.
DUBOIS, PA. CLEARFIELD, PA.

1936 Annual Schuckers Coal Co.
Reynoldsville, Pa.

Dist 12